

MAP OF SURVEY AND LOT SPLIT

PREPARED FOR



RUSSELL HENDRICKS

SITUATED IN THE TOWNSHIP OF HUNTINGTON, COUNTY OF LORAIN, STATE OF OHIO AND BEING KNOWN AS PART OF ORIGINAL HUNTINGTON TOWNSHIP LOT No. 20, TRACT No. 5

SURVEYOR'S STATEMENT

DISTANCES ARE EXPRESSED IN FEET AND DECIMAL PARTS THEREOF. BEARINGS ARE TO AN ASSUMED MERIDIAN AND ARE USED TO INDICATE ANGLES ONLY. PERMANENT MONUMENTS WERE FOUND OR SET AS INDICATED HEREON. ALL OF WHICH I DECLARE TO BE CORRECT TO THE BEST OF MY ABILITIES AND BELIEF.

Thomas M. Sneyek 5-3-94
 THOMAS M. SNEYEK, R.L.S. No. 7051

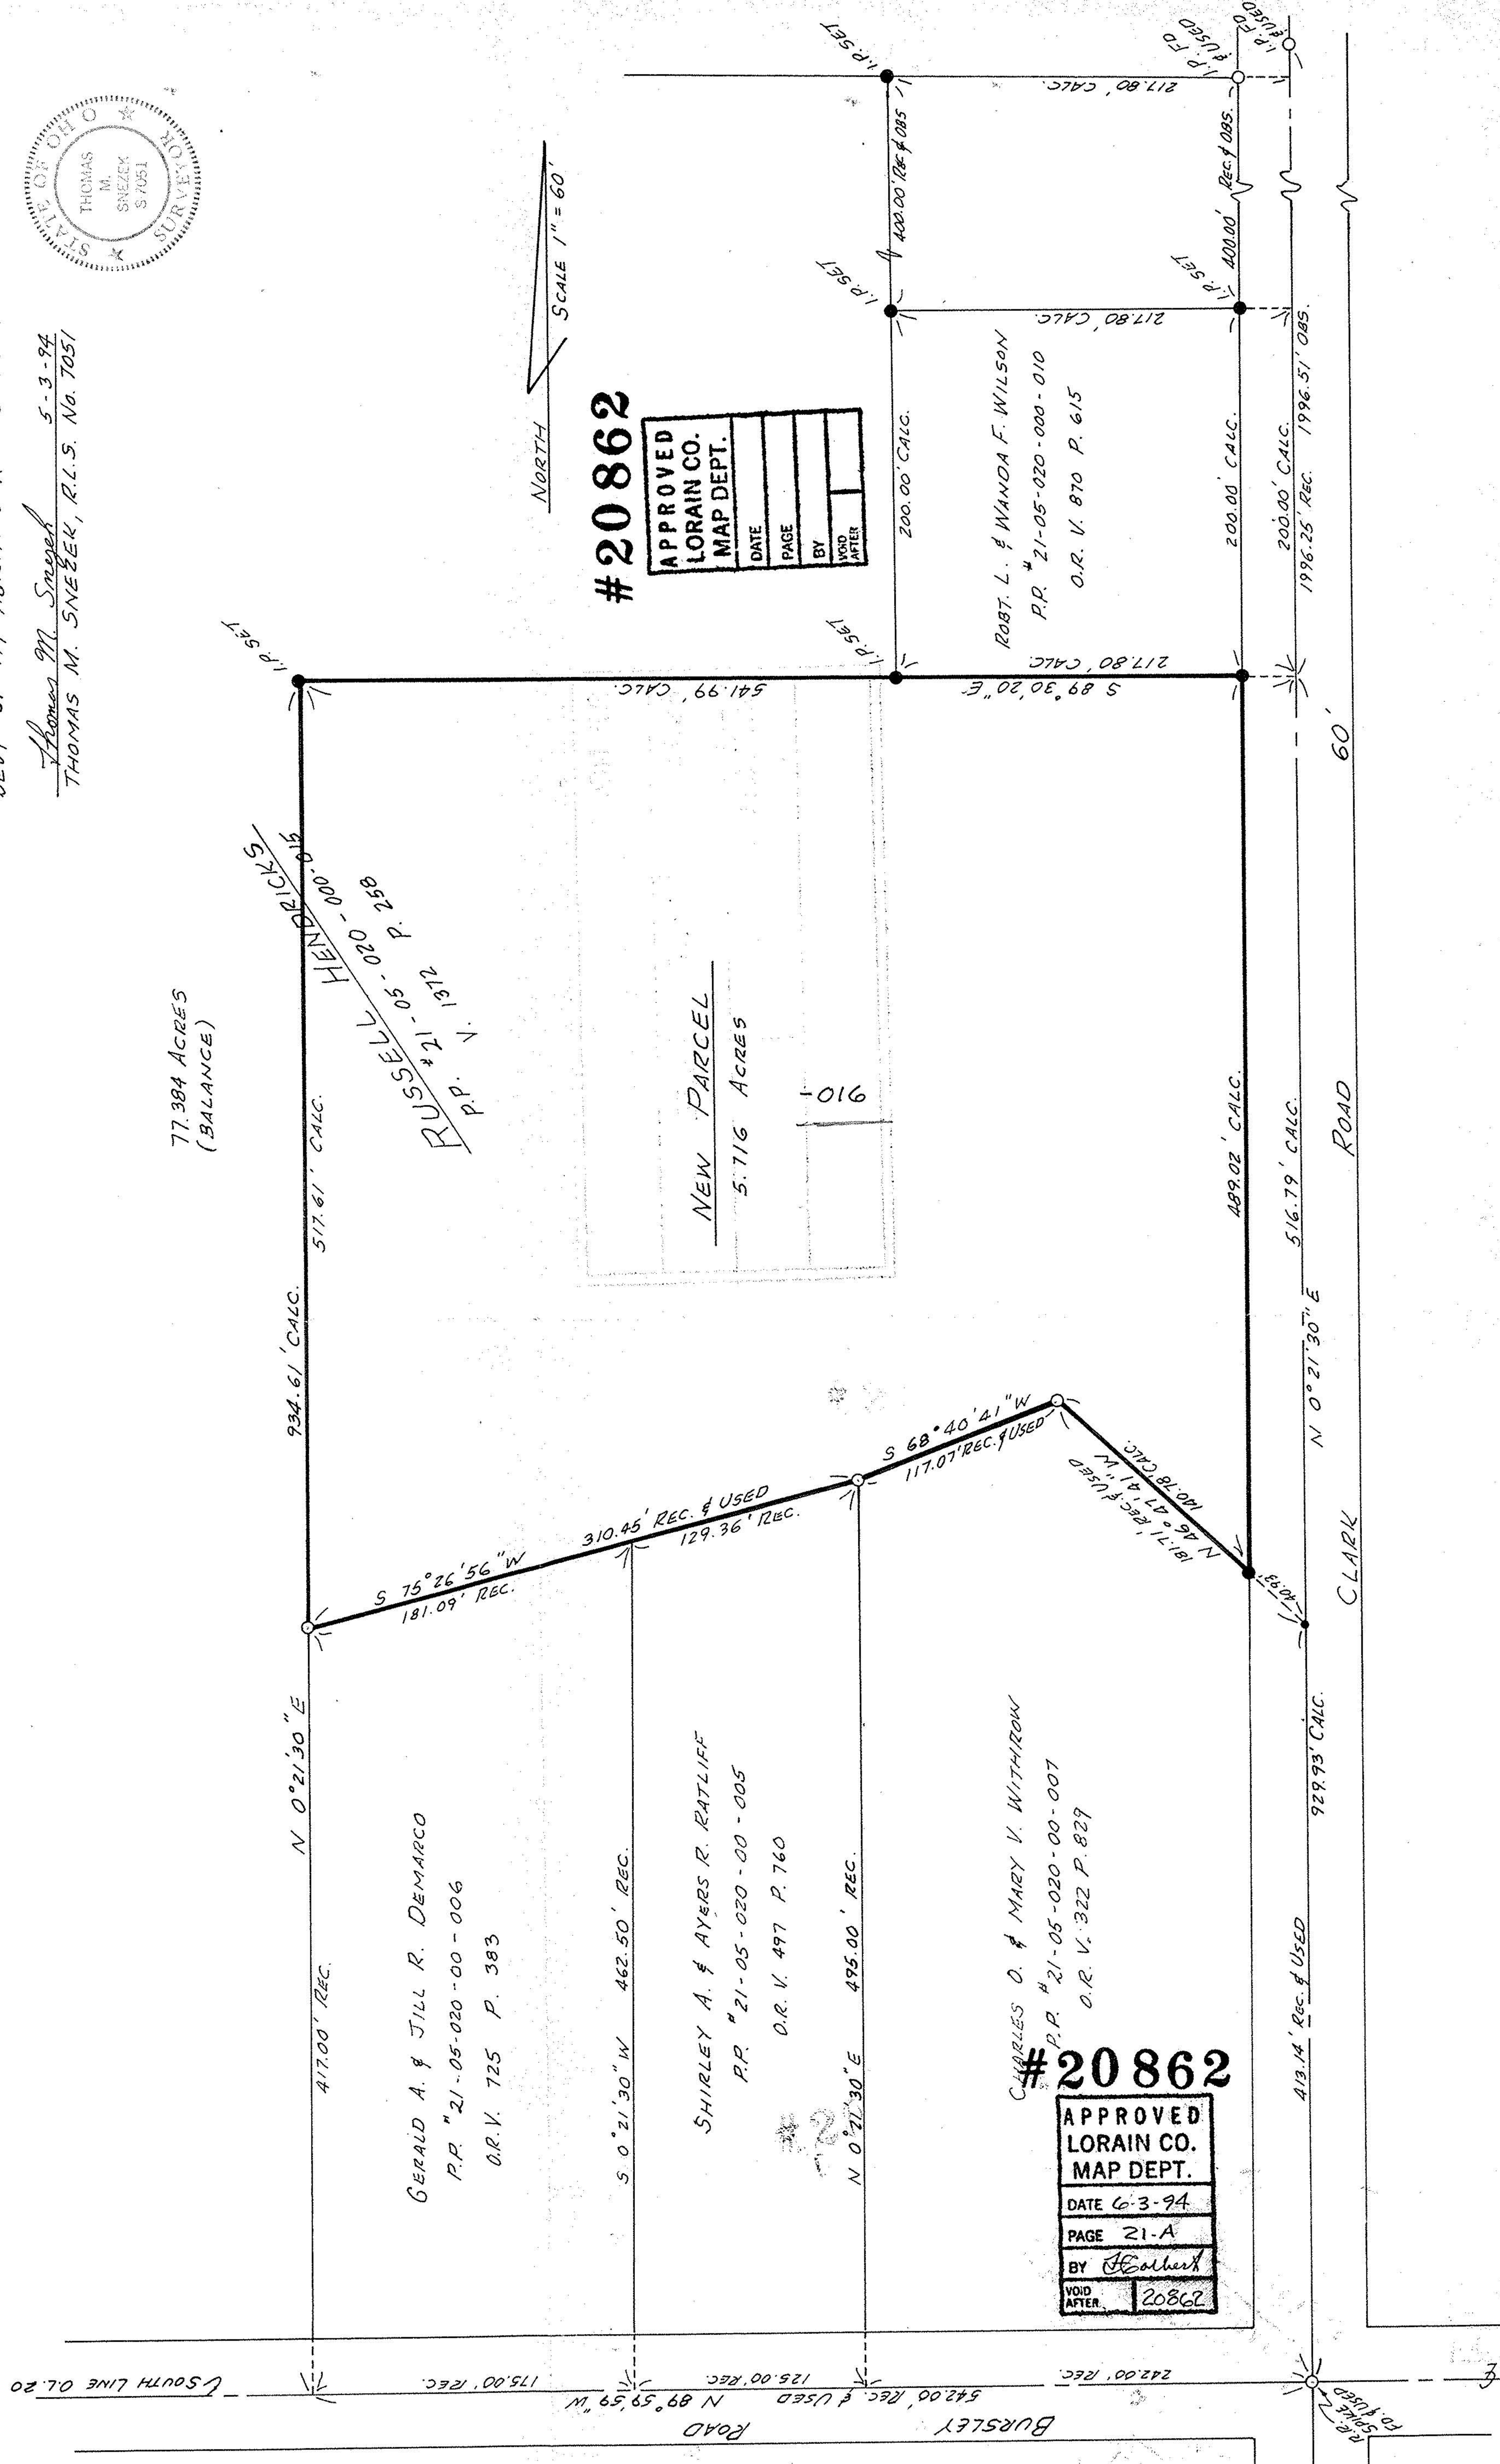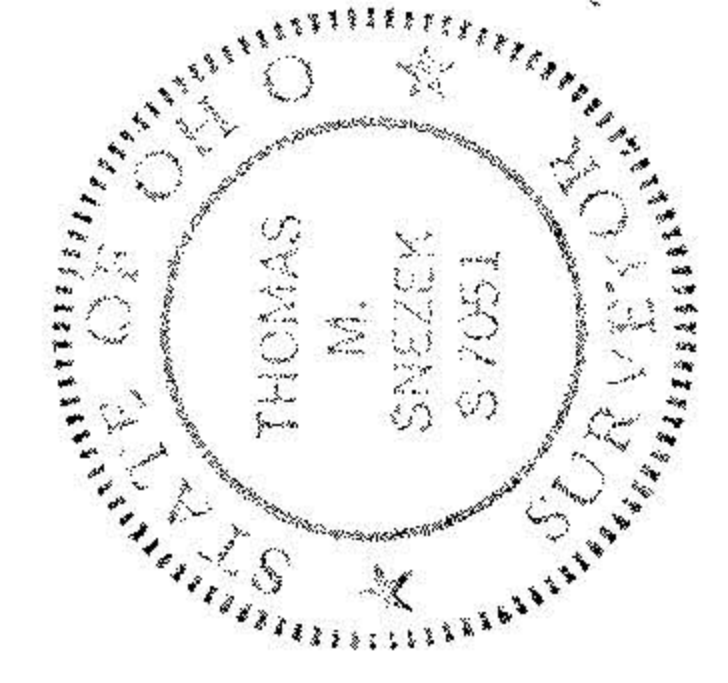

#20862

APPROVED LORAIN CO. MAP DEPT.			
DATE			
PAGE			
BY			
VOID AFTER	20862		

#20862

APPROVED LORAIN CO. MAP DEPT.	
DATE	6-3-94
PAGE	21-A
BY	TS/Barber
VOID AFTER	20862