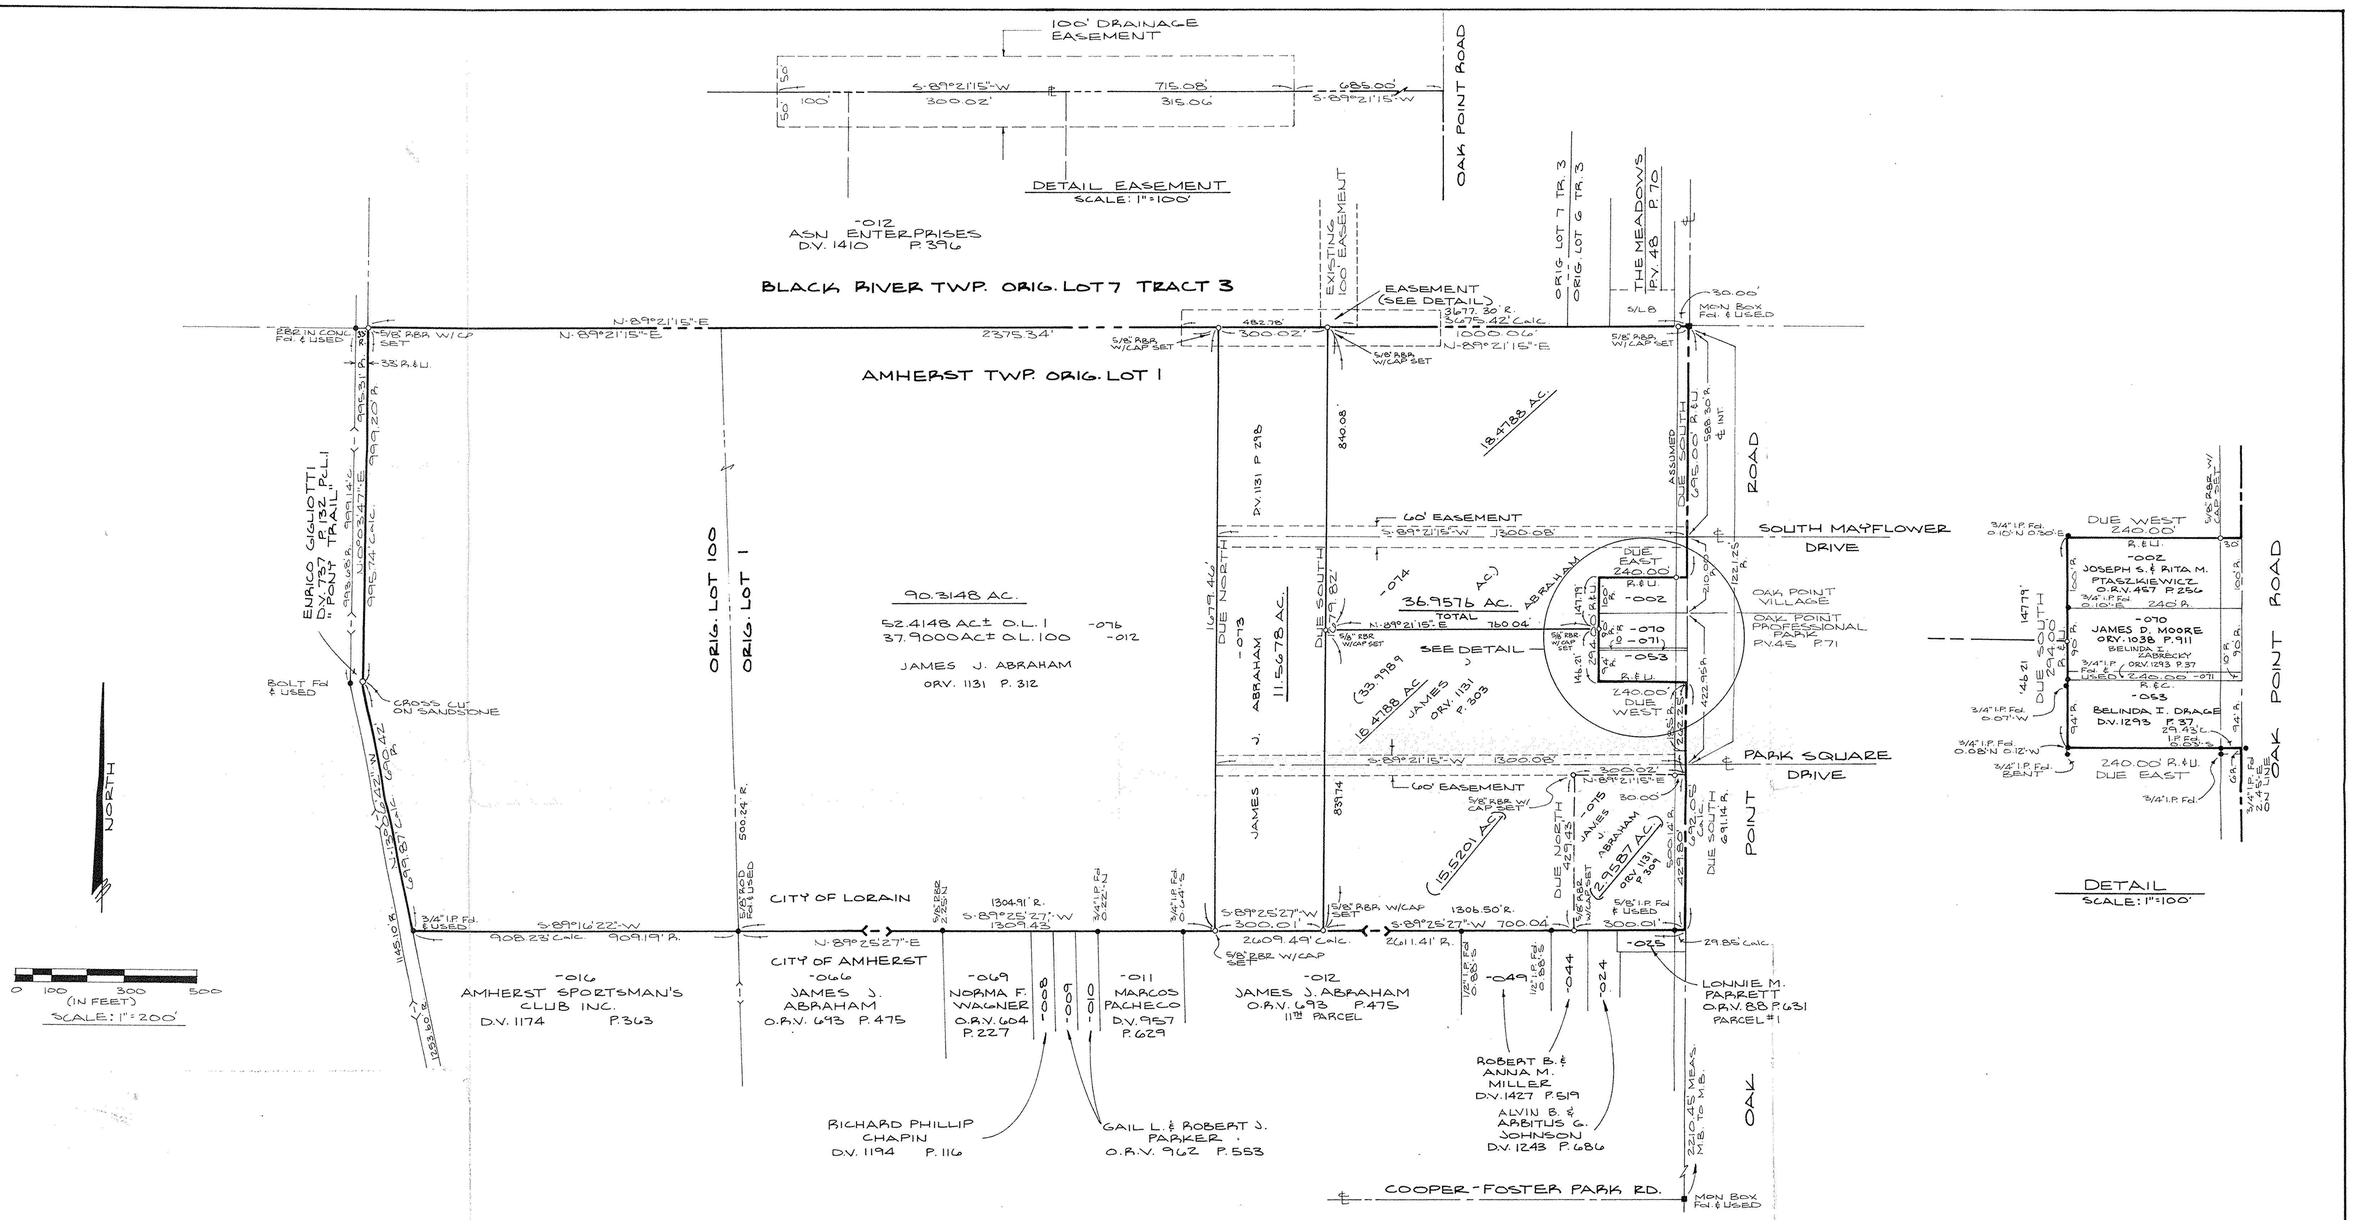

SURVEY MAP

PART OF ORIGINAL AMHERST TOWNSHIP

LOT NOS. 1 AND 100

CITY OF LORAIN COUNTY OF LORAIN

STATE OF OHIO

MAY 31, 1995

PREPARED BY:

KS ASSOCIATES INC.

ENGINEERS SURVEYORS

REVISED 08-17-95
REVISED 04-28-99
REVISED 06-29-99

David L. Elwell
DAVID L. ELWELL
REG. SURVEYOR NO. 6333

STATE OF OHIO
DAVID L. ELWELL
6333
REGISTERED
SURVEYOR

95-148