

MILAN AVE.

DUE WEST

90.00

200.96 DEED

I.P. SET

I.P. FID & CHK'D

CHK'D

SOUTH LAKE

SUBDIVISION OF LANDS FOR
ROBERT STURTZ
796 MILAN AVE AMHERST 44001
CITY OF AMHERST - LORAIN CO. OHIO

PART OF ORIGINAL AMHERST
TOWNSHIP LOT No. 4.

OHIO


SCALE: 1" = 40'
AUGUST 1988

MONUMENTS WERE FOUND OR SET
AS SHOWN. DISTANCES ARE IN FEET
AND DECIMALS. BEARINGS ARE FOR
ANGLE CALCULATIONS ONLY. WE CERTIFY
ALL TO BE CORRECT.

Vincent C. McGervey

CONSULTING ENGINEER &
SURVEYOR NO. 4289

VINCENT C. MCGERVEY
CIVIL ENGR. & SURVEYOR
2643 JOSEPH ST
AMHERST OHIO 44001
937-5353

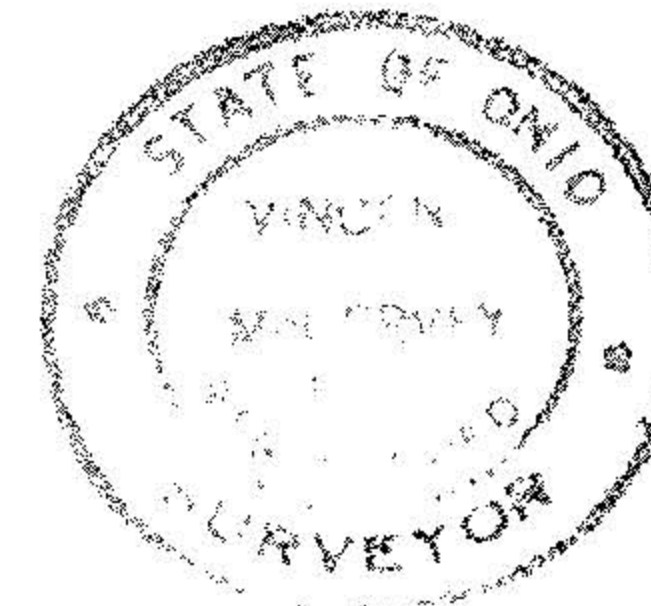

#18162

APPROVED
LORAIN CO.
MAP DEPT.

DATE 10-6-88

PAGE 5-00-004 B

BY Carolyn France

VOID
AFTER #18162

SUBLOT 2

SUBLOT 1

0.5258
ACRES

250.00

DUE NORTH 253.57

DUE SOUTH 255.42

I.P. FID & CHK'D

CHK'D

85.42

N88°50'00"W
90.02

12.51

I.P. FID & CHK'D

102.53
I.P. DEED & OBS.
SET

I.P. FID & CHK'D

CHK'D

205.00

203.04

OWNERS
ROBERT L. & MARY JANE STURTZ
VOL. 964 - PAGE 799
TELEPHONE No. 988-7474