


5-00-005 B
01-200-00-20

#18724

05-00-005-101
01-200-00-20

101-

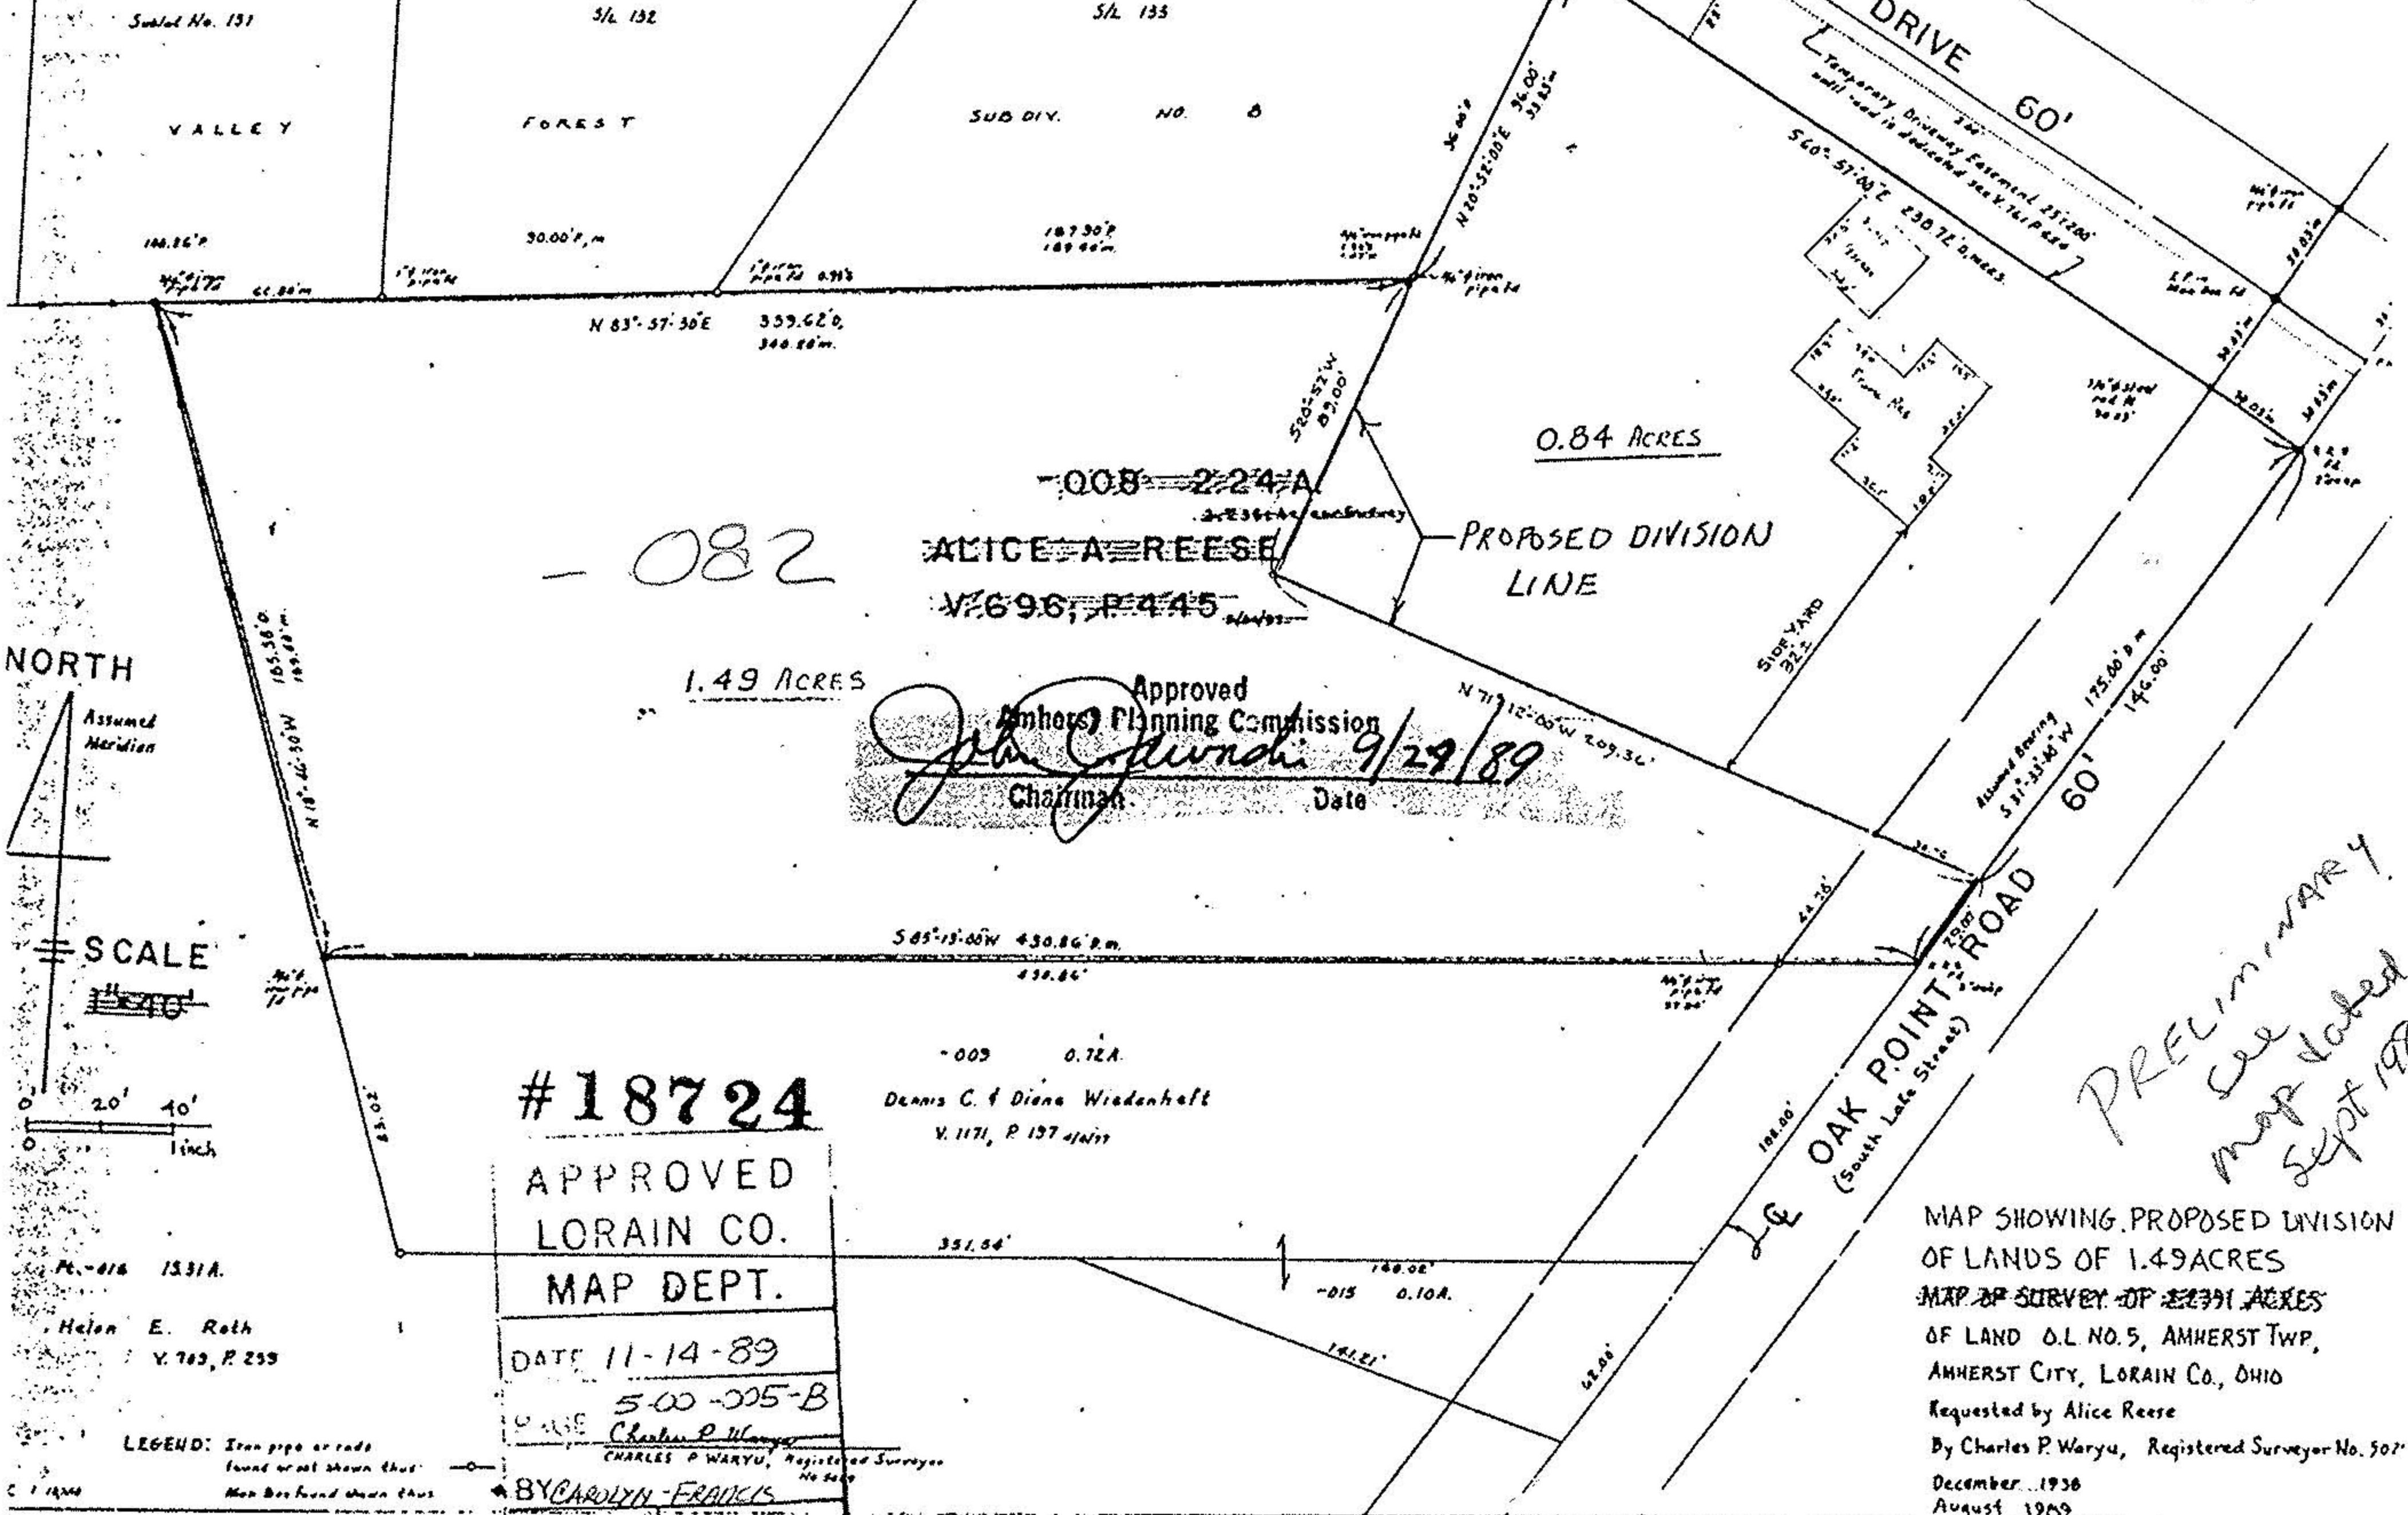

Approved
Amherst Planning Commission
John Grundi
Chairman
Date 9/29/89

#18724
APPROVED
LORAIN CO.
MAP DEPT.
DATE 11-14-89
5-00-005-B
BY CAROLYN FRANKS
VOID AFTER # 18724

PRELIMINARY!
see labeled
map dated
Sept 1989

MAP SHOWING PROPOSED DIVISION
OF LANDS OF 1.49 ACRES
MAP OF SURVEY OF 2.2791 ACRES
OF LAND O.L. NO. 5, AMHERST TWP,
AMHERST CITY, LORAIN CO., OHIO
Requested by Alice Reese
By Charles P. Waryu, Registered Surveyor No. 507
December, 1936
August, 1969

NORTH
Assumed Meridian
SCALE
0 20' 40'
0 1 inch

PL-416 1531A
Helen E. Roth
Y. 769, P. 259

LEGEND: Iron pipe or rods
found and shown thus
Map Book found shown thus