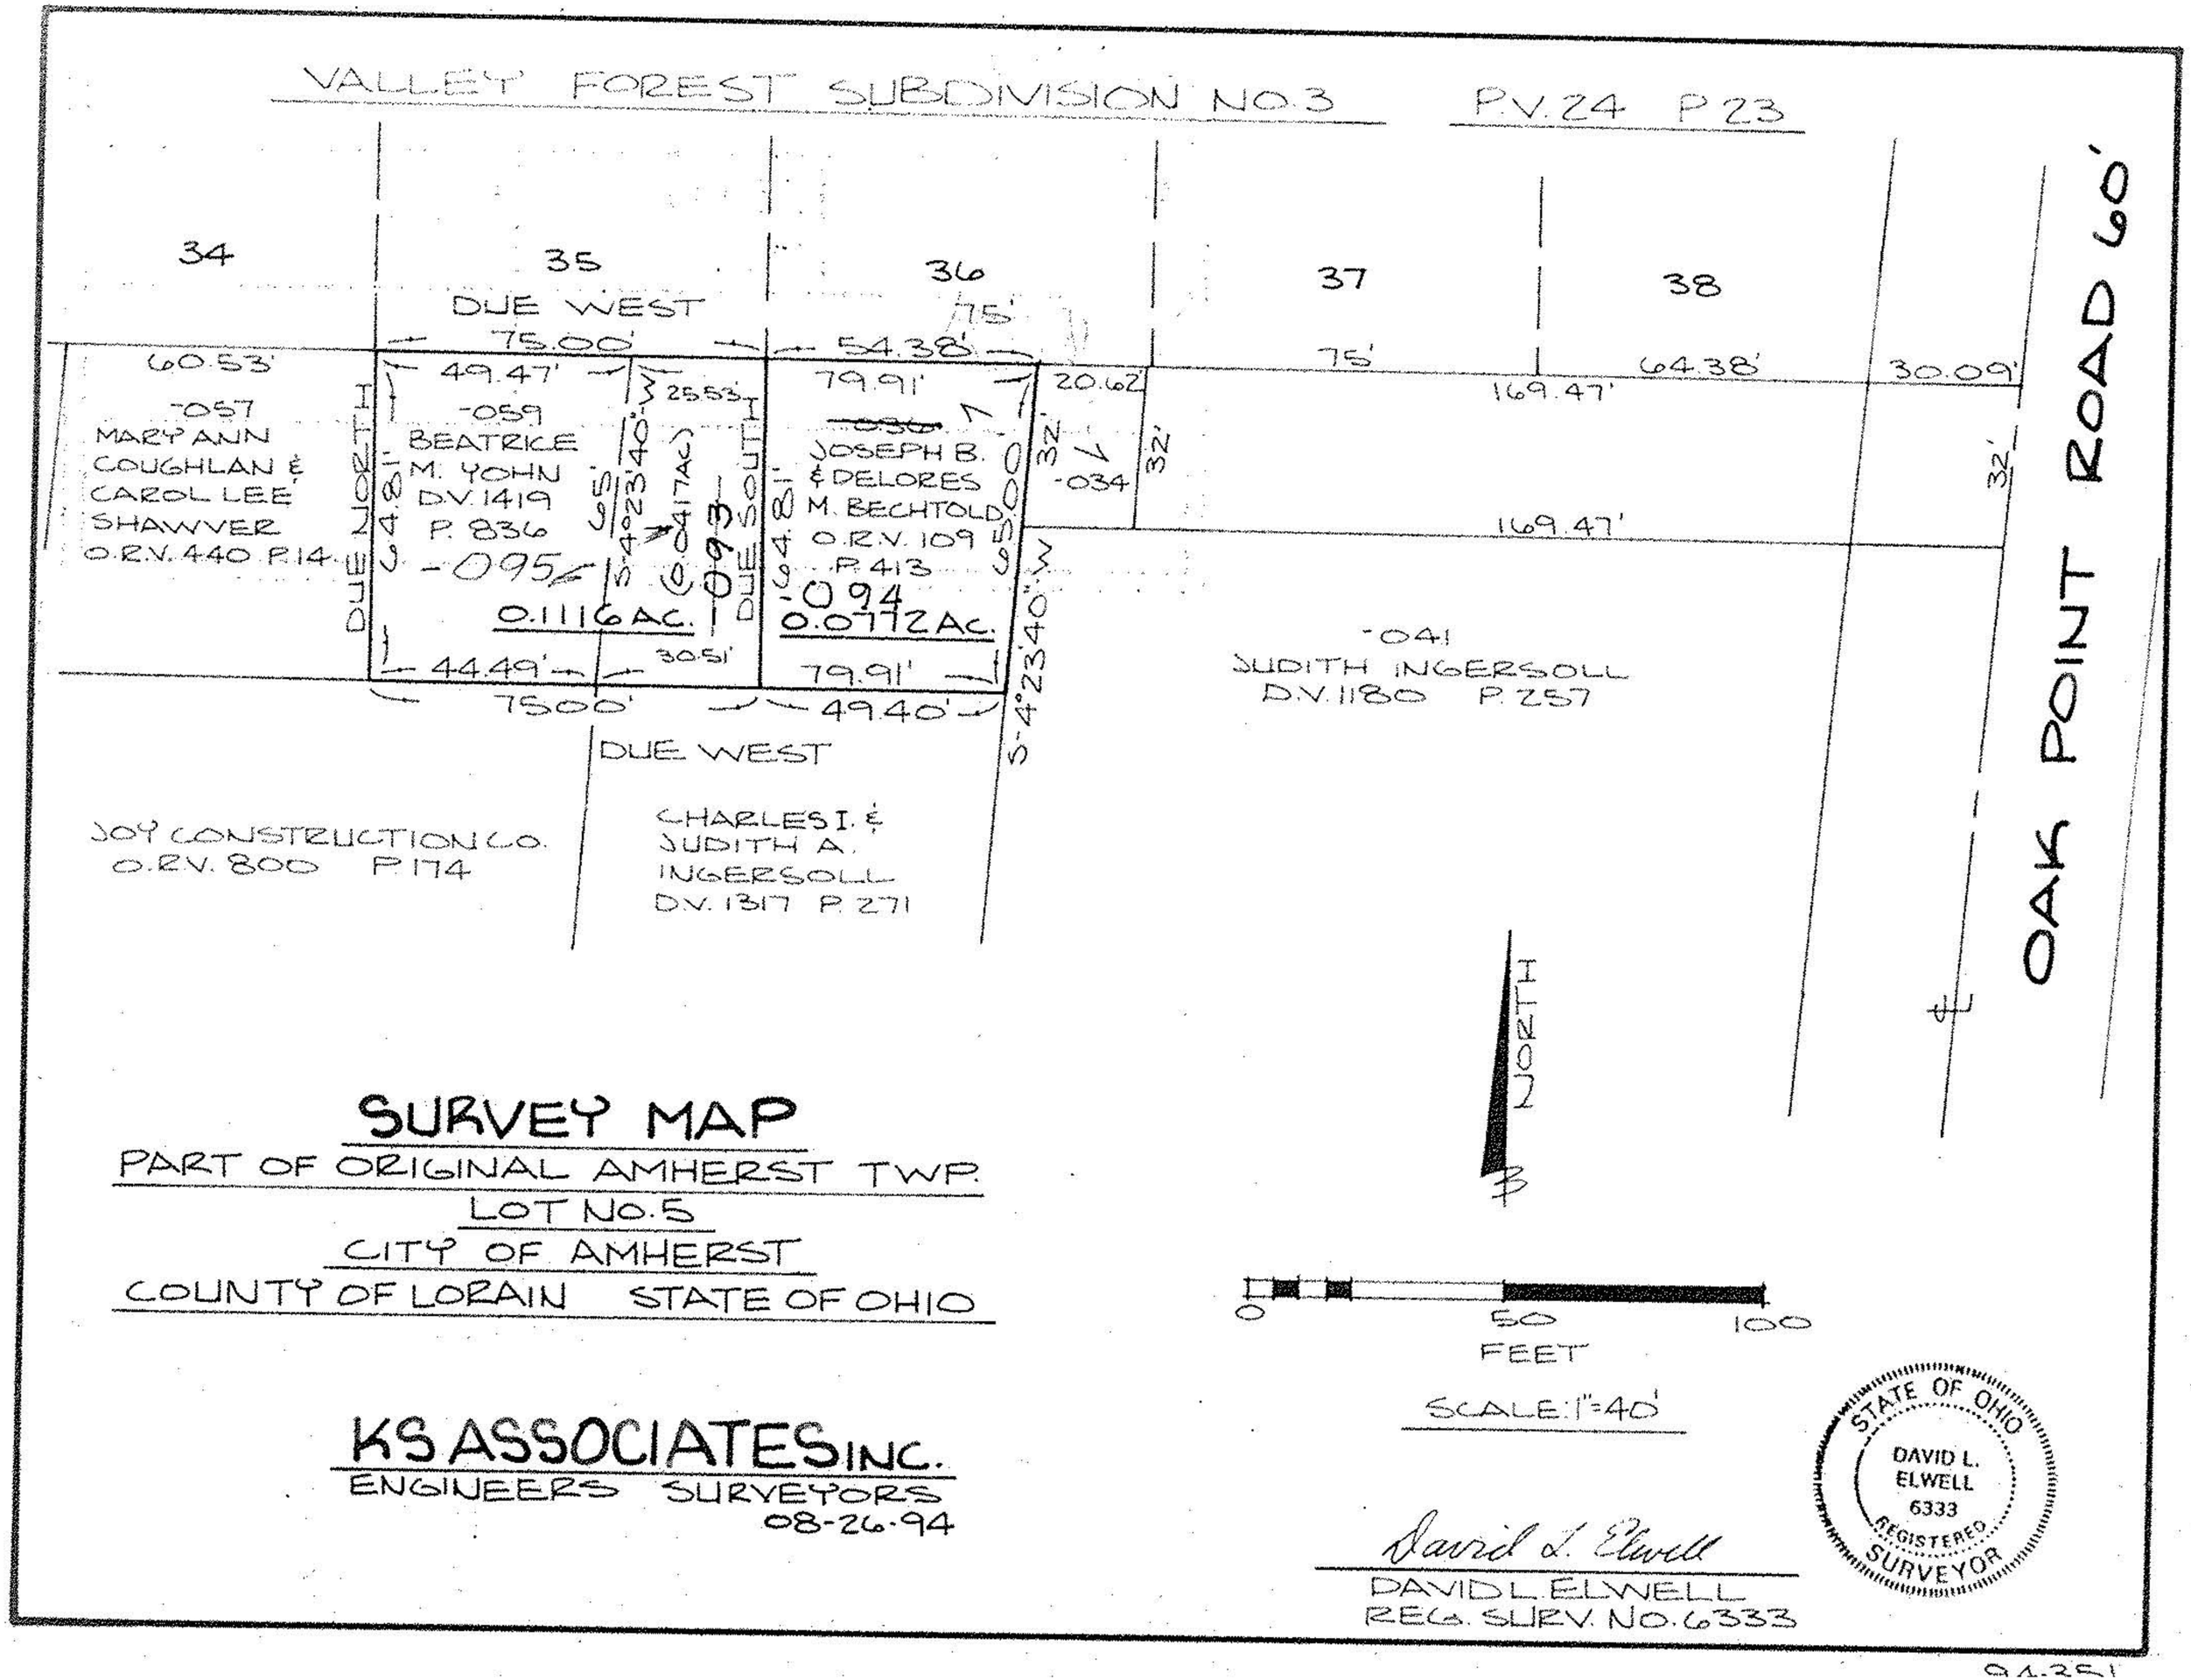

SURVEY MAP

PART OF ORIGINAL AMHERST TWP.

LOT NO. 5

CITY OF AMHERST

COUNTY OF LORAIN STATE OF OHIO

KS ASSOCIATES INC.

ENGINEERS SURVEYORS

08-26-94

David L. Elwell

DAVID L. ELWELL

REG. SURV. NO. 6333

94-351