


05-00-006-A

SHIRLEY SHUBERT
V.941 P.27

NORTH

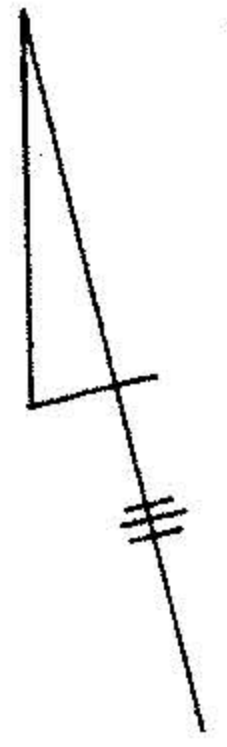

SCALE 1"=60'

S 15° 14' W
120.20'

S 77° 41' E
55.00'

0.1619 ACRES

center of ditch

120.42'
N 18° 44' 25" E

REVISED

N 18-51-58 E
117.64

Howard & Myrtle
Holmes
V.554 P.175

John & Myra Carter
V.499 P.187
1 ACRE Deed

16201

0.8381 ACRES
Remainder

0.3772
ACRES

S 77°-41'E 341.10'

N 74°-46' W 333.21'

333.21'

323.95'

50.85' S 25° 44' W
50.85'

#16201
APPROVED
LORAIN CO.
MAP DEPT.

DATE 6-27-85

PAGE 5-00-006-A

BY T. McMain

VOID
AFTER

17.00'

100.00'

50.00

50.00'

± OAK POINT ROAD (60')
N 15° 14' E

5-00-006-A

MAP OF PROPOSED DIVISION OF LANDS
OF JOHN AND MYRA CARTER IN AMHERST
CITY, O.L.G. AMHERST TWP. LORAIN CO., OHIO
Made at request of Shirley Shubert
By Charles P. Waryu, Reg. Surveyor No. 5029
April 22, 1985