MAP OF LAND FOR SHIRLEY SHUBERT

CITY OF AMHERST ÷
LORAIN COUNTY ÷ OHIO
PART OF ORIGINAL AMHERST
TOWNSHIP LOT NO. 6
SCALE: 1" = 100'
SEPTEMBER 1994
REVISED 9-95

DISTANCES ARE IN FEET AND DECIMALS.
BEARINGS ARE FOR ANGLE CALCULATIONS ONLY

Vincent C. M. Gerney
PROFESSIONAL ENGINEER & SURVEYOR
NO. 42289
2643 JOSEPH ST.
AVON OHIO 44011
937-5353
871-4075

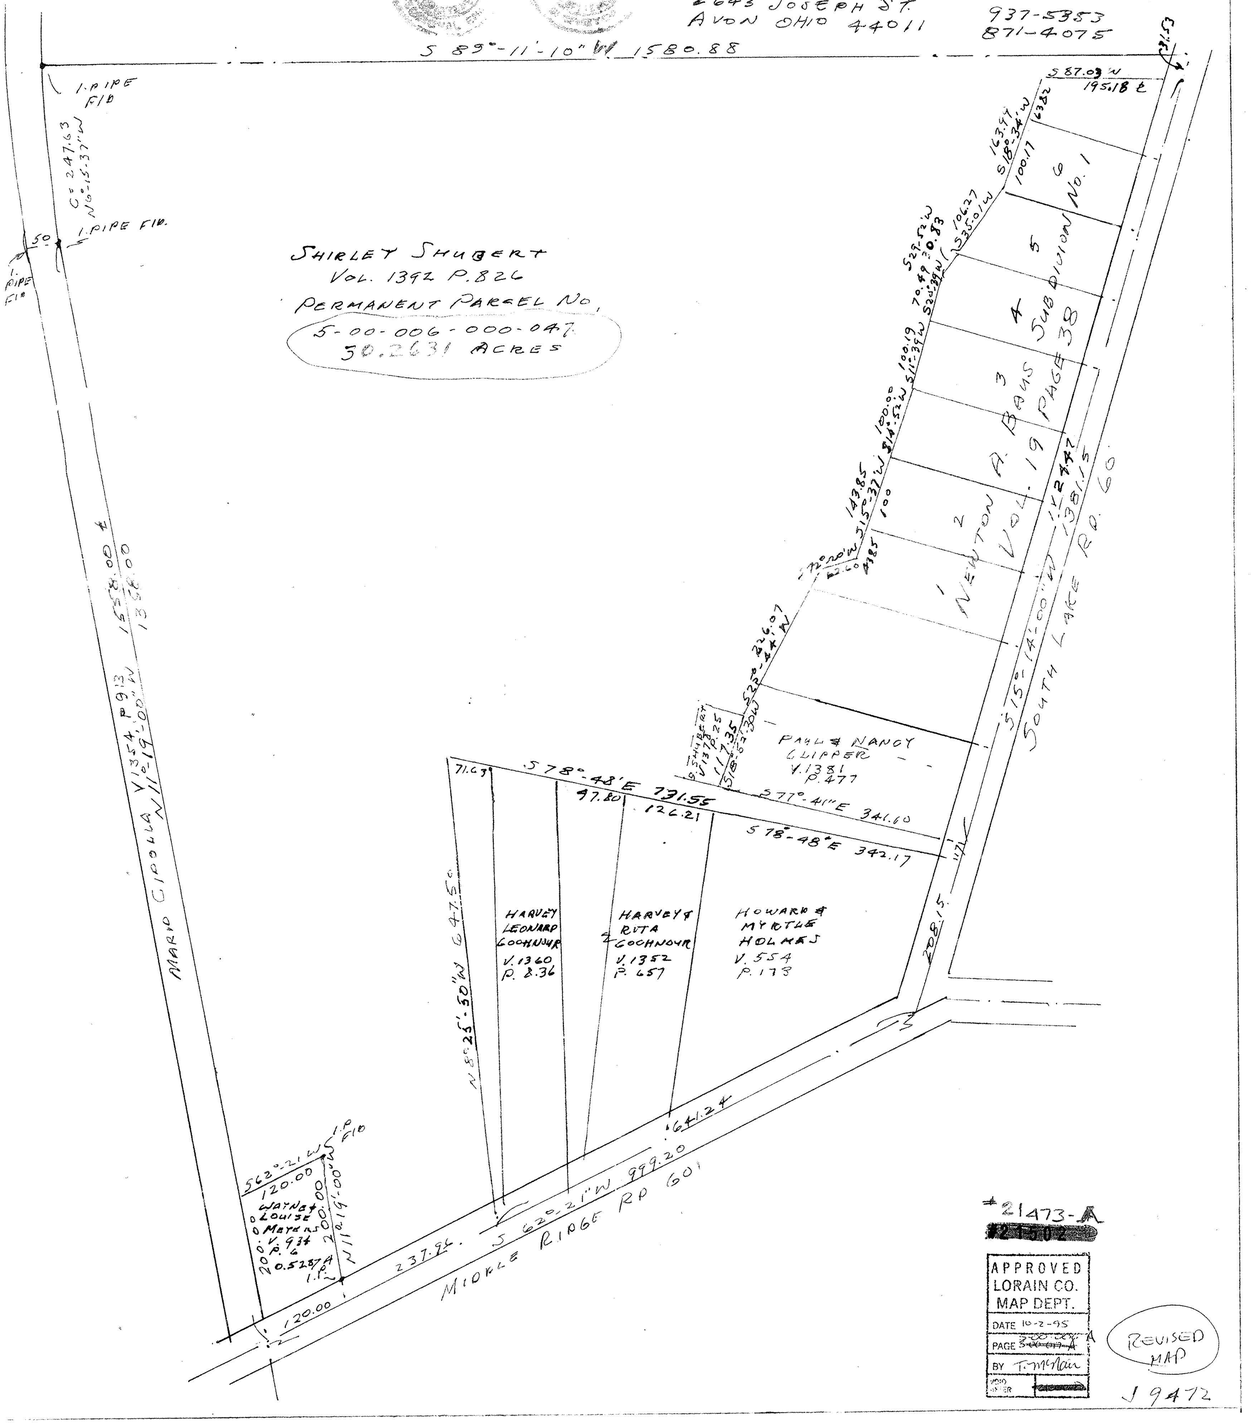

MAP OF LAND FOR SHIRLEY SHUBERT

CITY OF AMHERST ÷
LORAIN COUNTY ÷ OHIO
PART OF ORIGINAL AMHERST
TOWNSHIP LOT NO. 6
SCALE: 1" = 100'
SEPTEMBER 1994

DISTANCES ARE IN FEET AND DECIMALS.
BEARINGS ARE FOR ANGLE CALCULATIONS ONLY
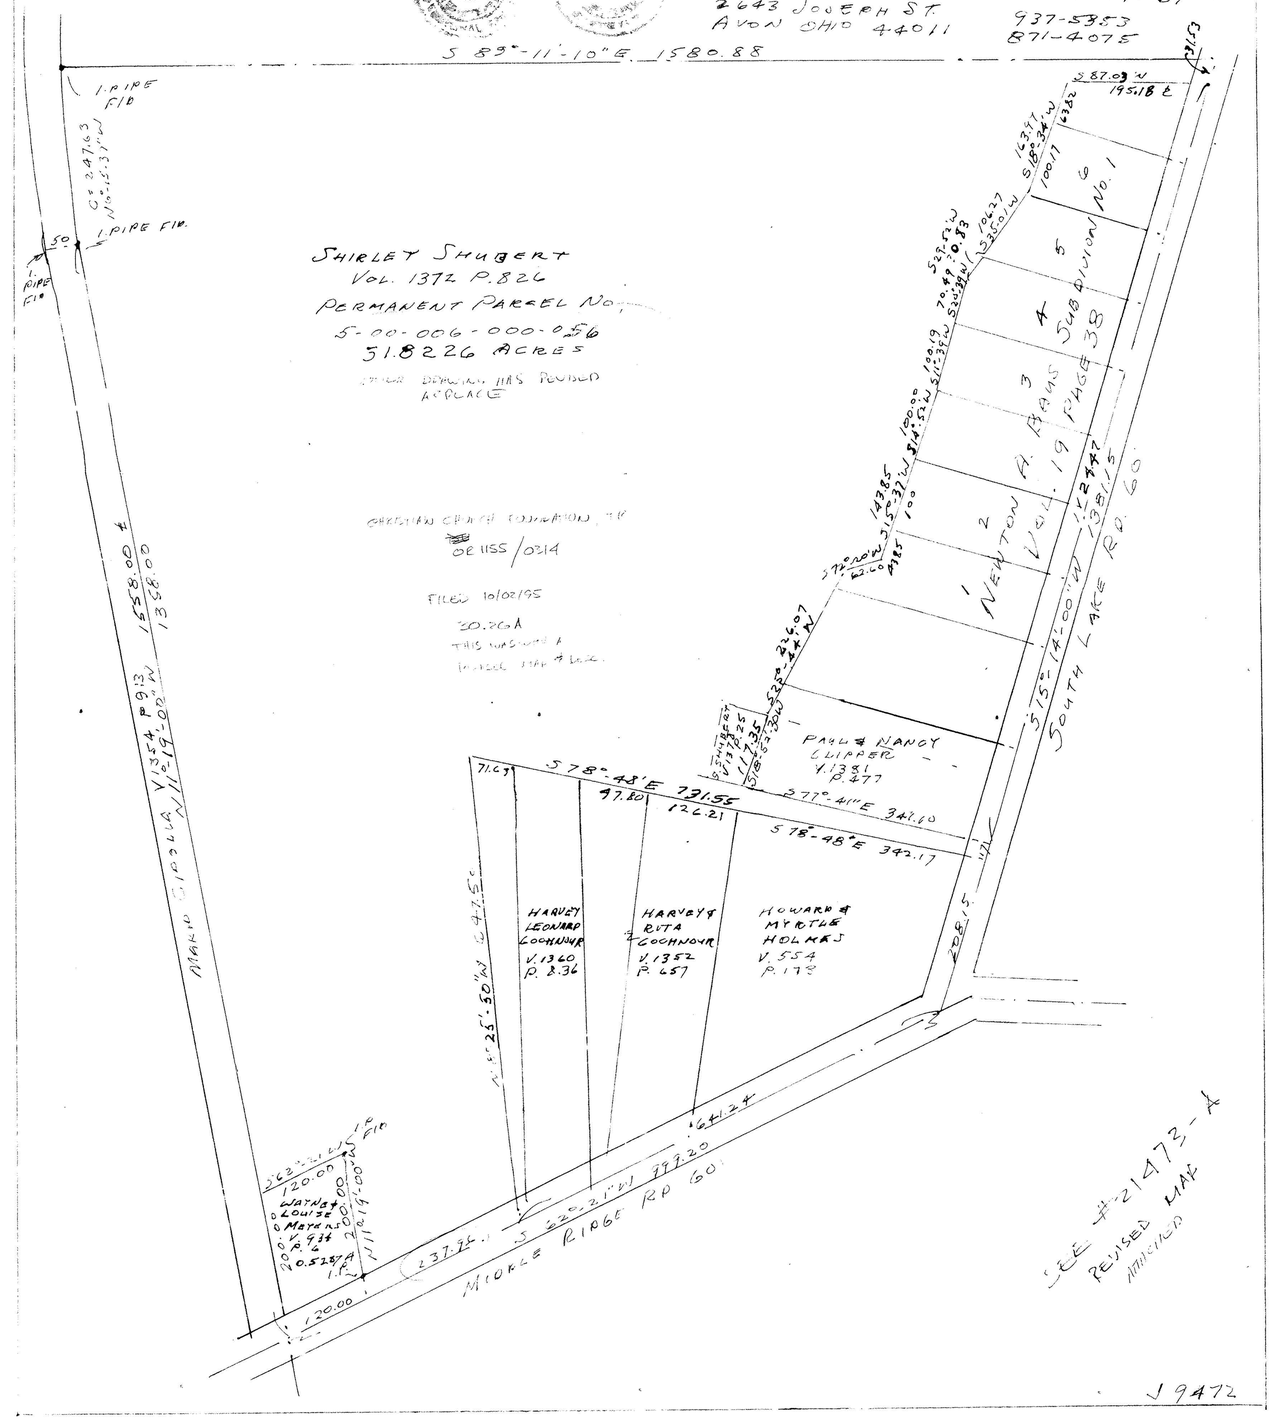
Vincent C. M. Gerney
PROFESSIONAL ENGINEER & SURVEYOR
NO. 42289
2643 JOSEPH ST.
AVON OHIO 44011
937-5353
871-4075