5-00-011-A

18618

05-00-011-108

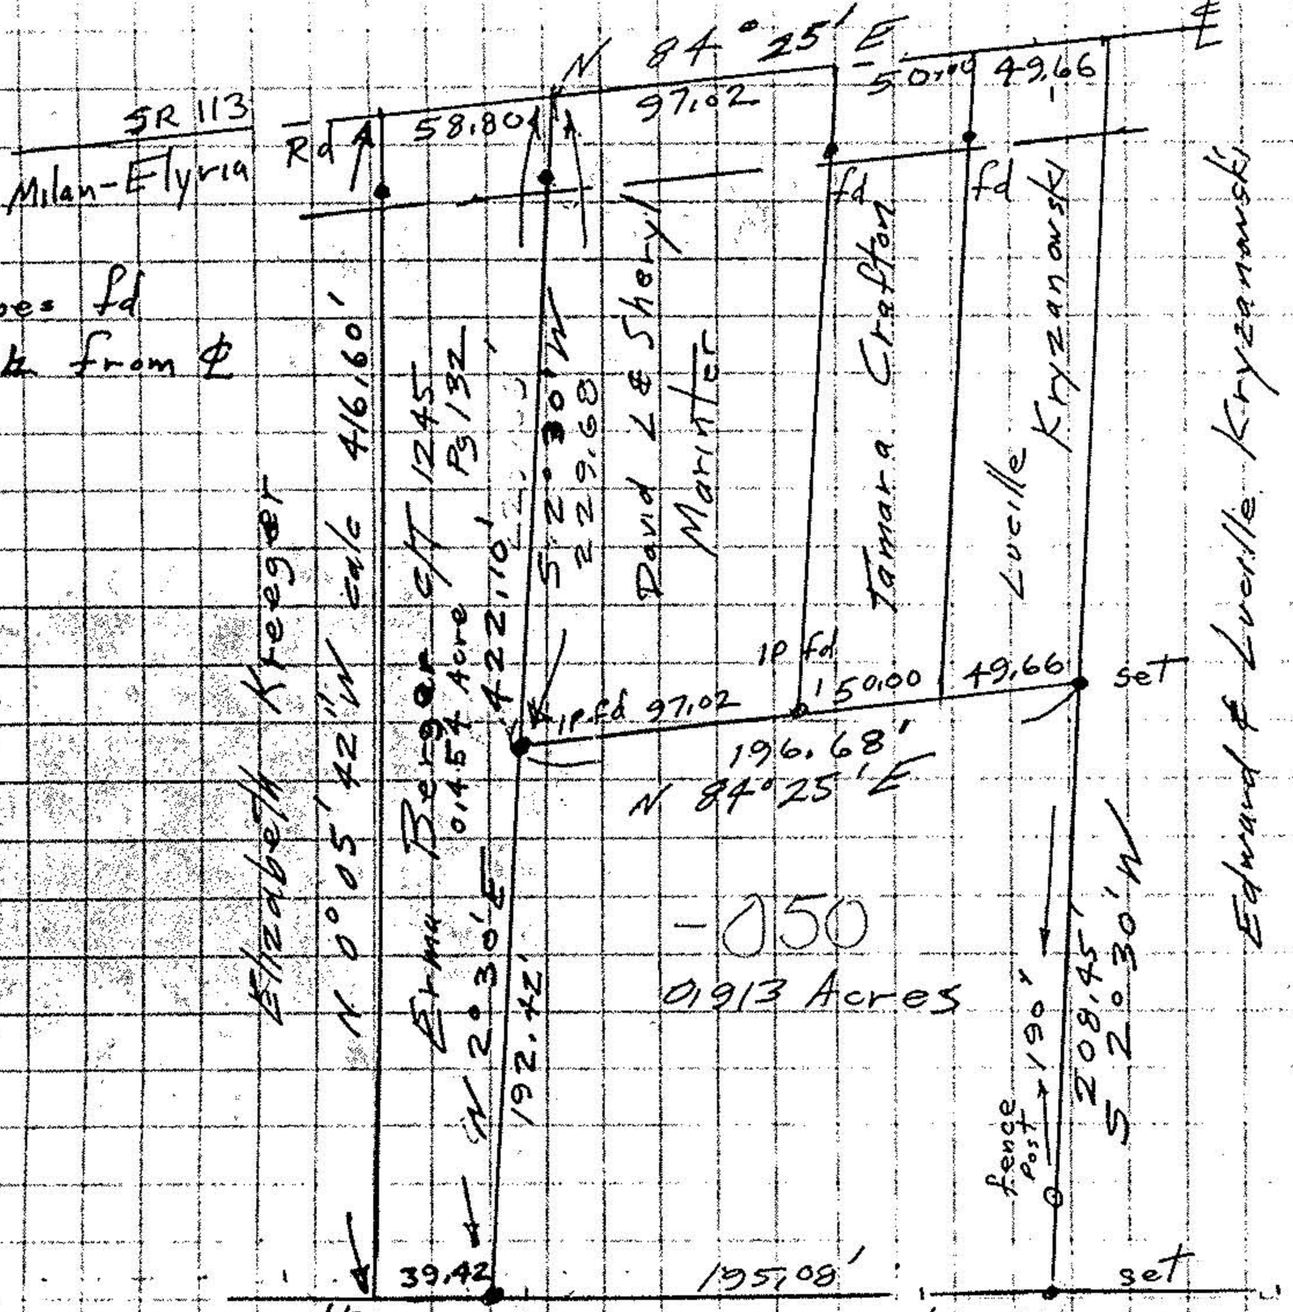

John Pozywak
Reg Surveyor
5292

#18618

APPROVED
LORAIN CO.
MAP DEPT.
DATE 9-8-89
PAGE 5-00-011 A
BY T. McClain
VOID AFTER 18618

Survey for
Erma Berger
Part of Original Lot 11
Original Amherst Township
Village of So. Amherst
Lorain County Ohio
Scale 1"=80' July 8, 1989
July 12, 1989