Survey Map Part of C.L. 9 Amherst Twp. Now Village of South Amherst
Scale 1" 100' June21, 1969 By Arnold F. Koepp
Registered Surveyor No. 4306

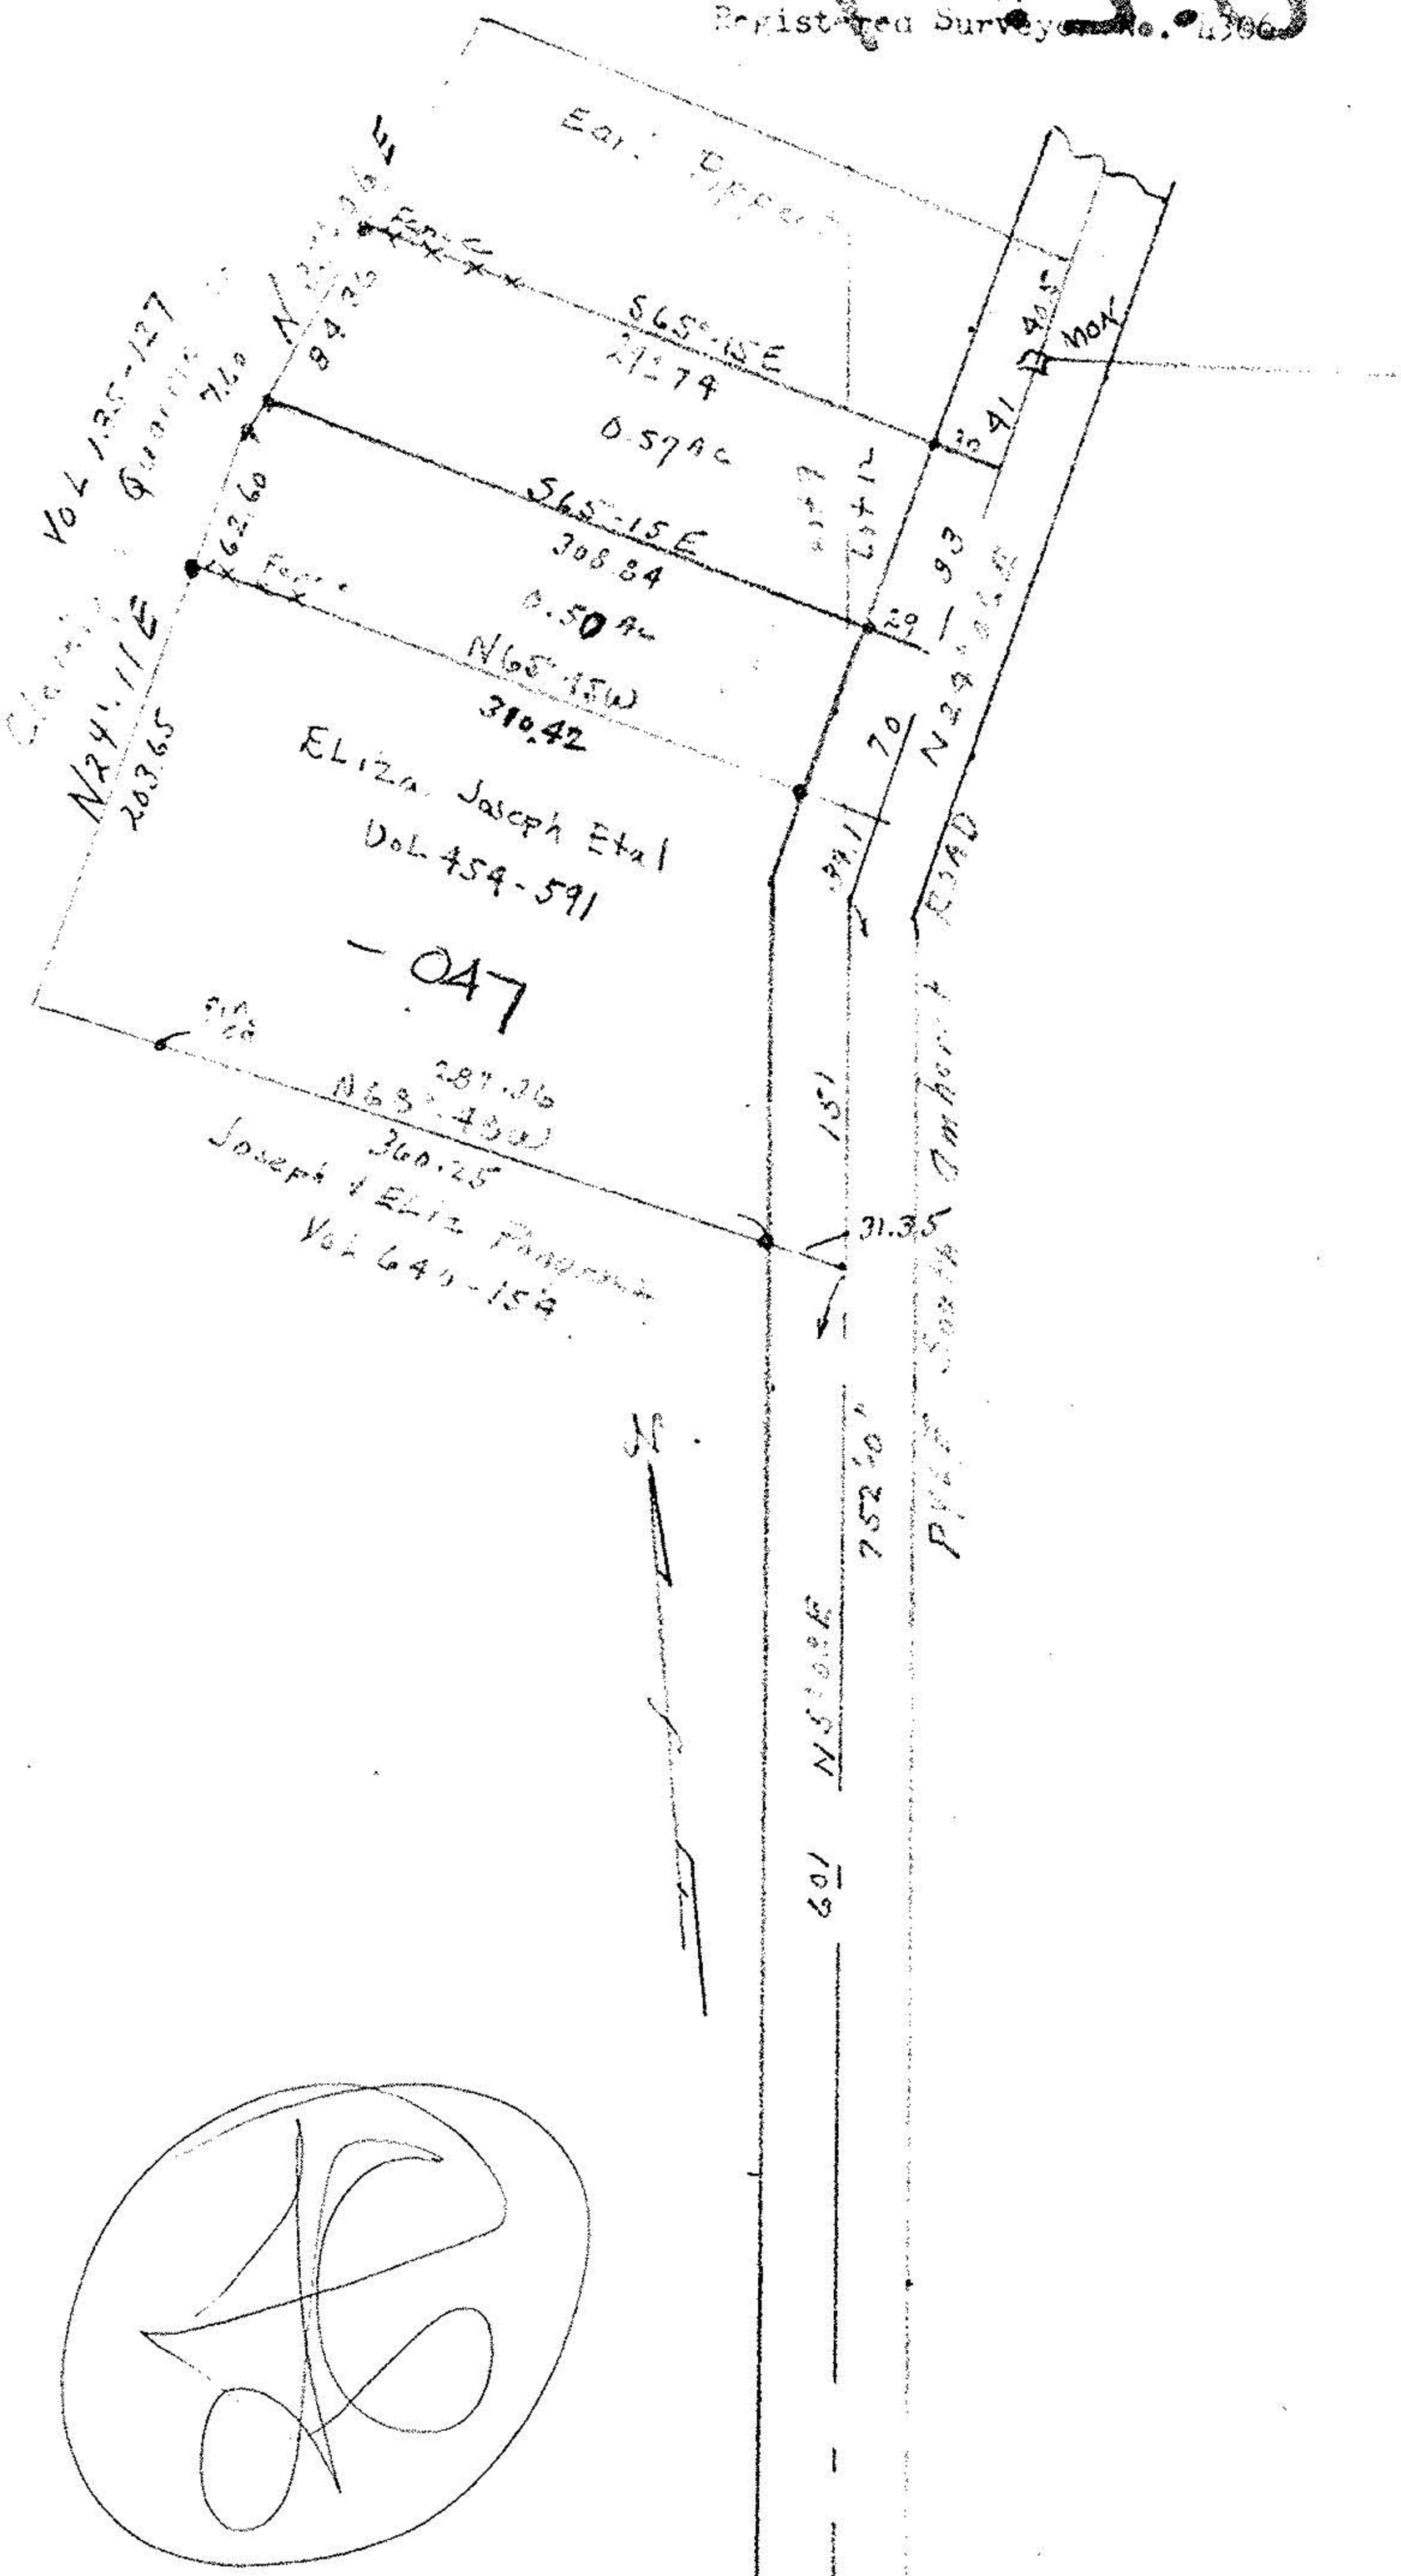

JUL 24 1969

5-00-009-B