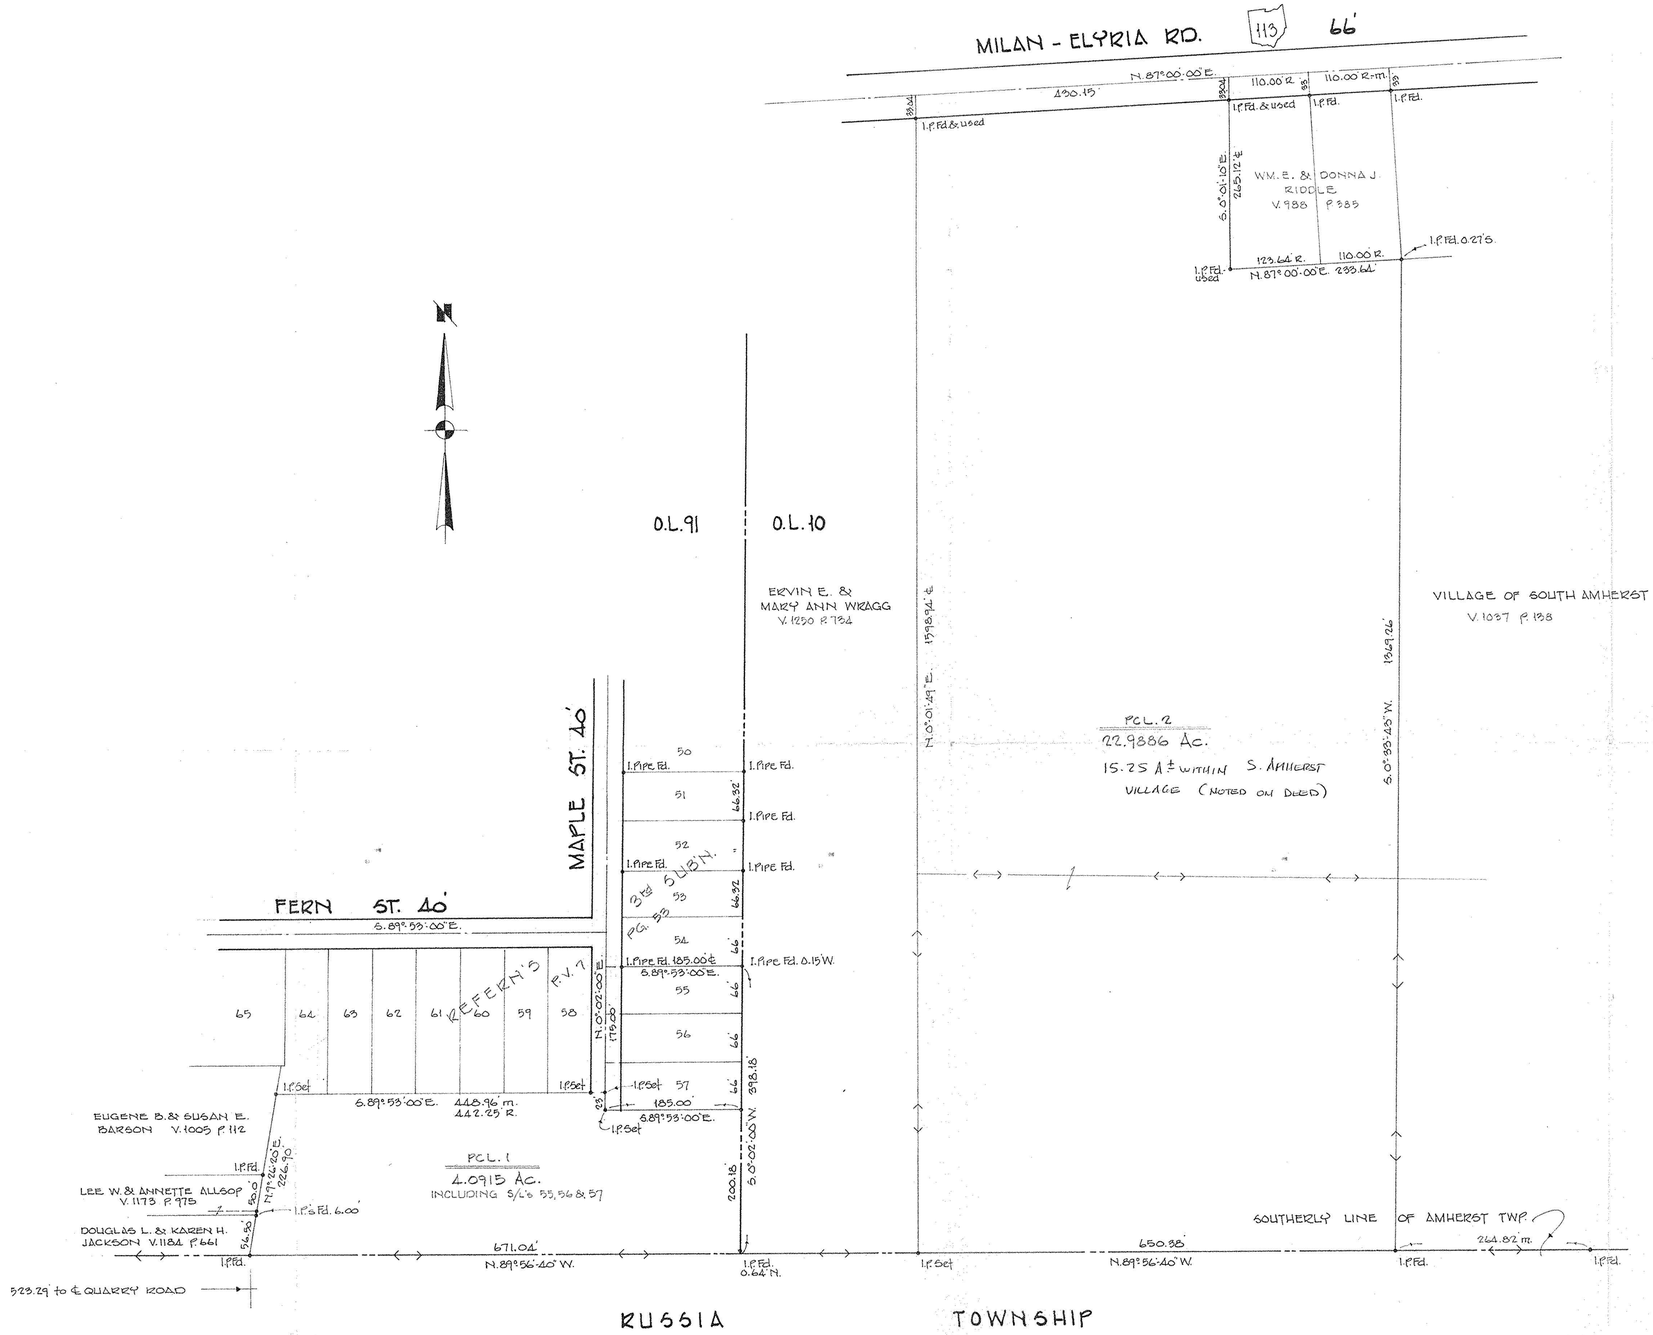

05-00-010-102

#19263-A

ACRE. CORR.

APPROVED LORAIN CO. MAP DEPT.	
DATE	1-25-91
PAGE	S-00-010-A
BY	T. McCain
VOID AFTER	19263-A

SURVEY FOR

ALEXANDER PAUKST ET AL

S/L's 55, 56 & 57 IN REDFERN'S 3RD SUBDIVISION P.V. 7 P. 53

PART OF O.L.'s 10 & 91 TOWNSHIP OF AMHERST

PART OF THE VILLAGE OF S. AMHERST COUNTY OF LORAIN

STATE OF OHIO

SCALE 1"=100' MARCH, 1990

LAUNDON · SIMON · CAHL & ASSOC.
ENGINEERS SURVEYORS

JOB Nº 90-1914

STATE OF OHIO
RODGER G. SIMON
5101
REGISTERED SURVEYOR