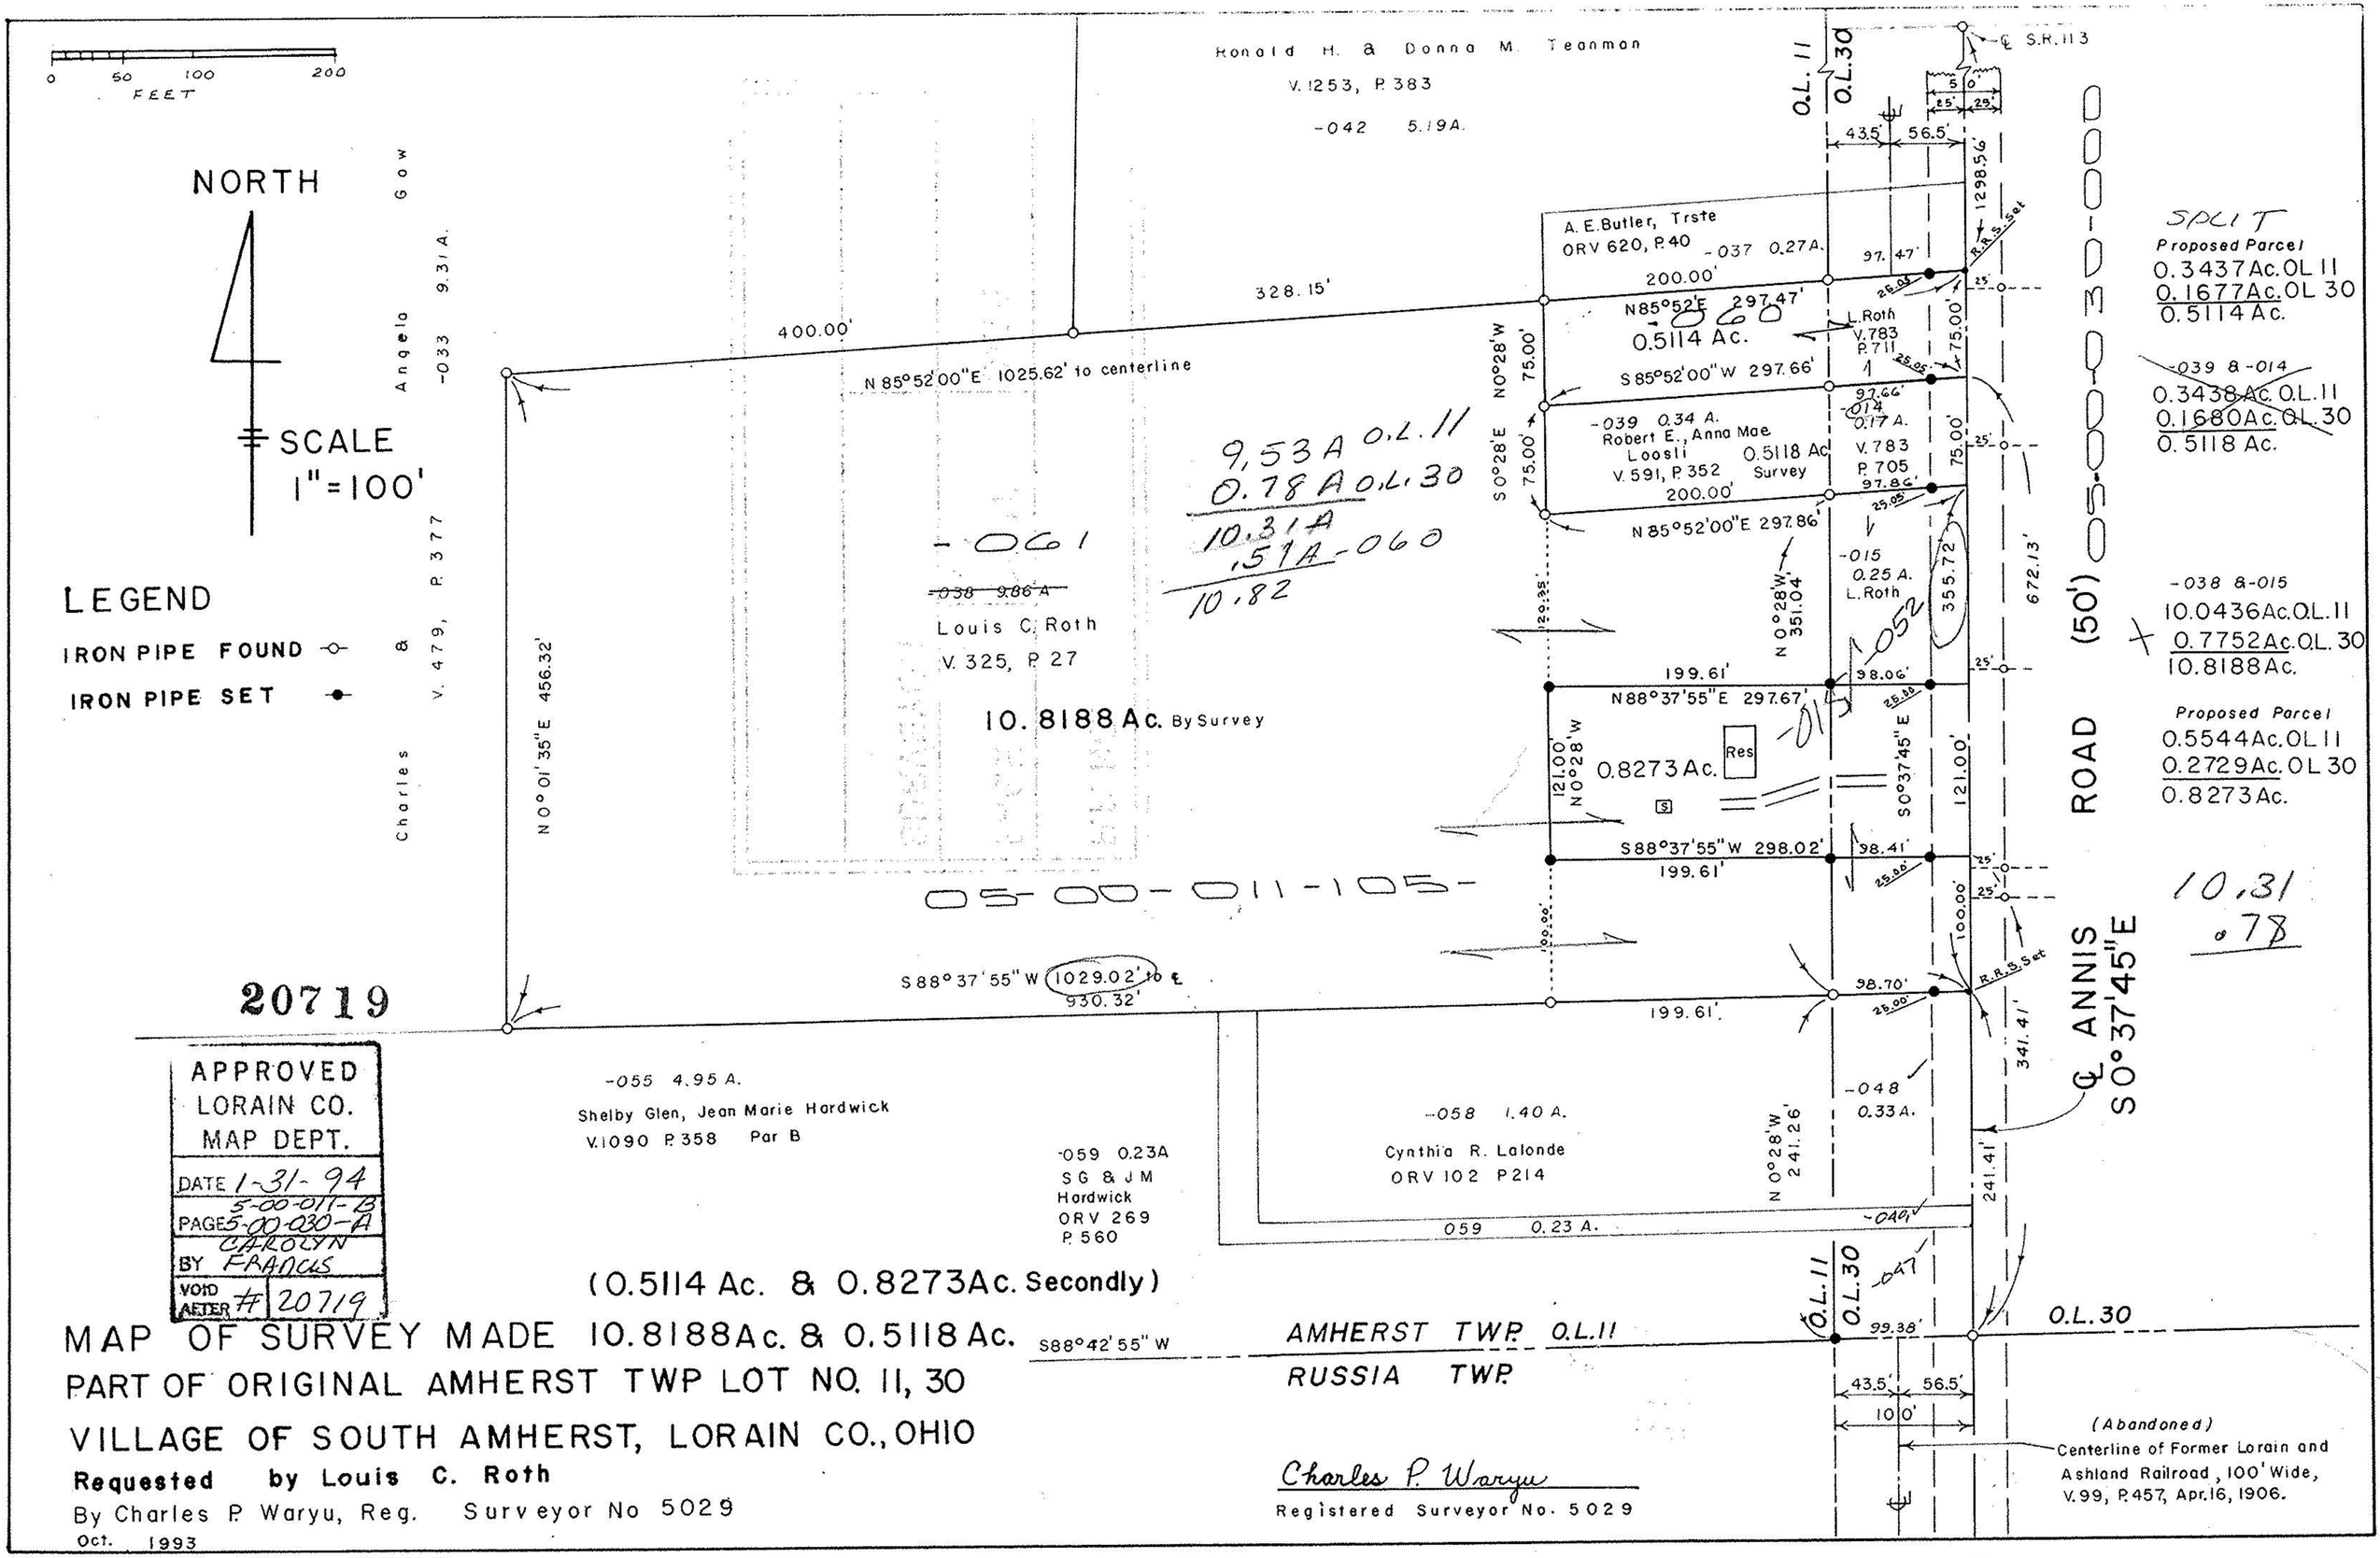

MAP OF SURVEY MADE 10.8188 Ac. & 0.5118 Ac.

PART OF ORIGINAL AMHERST TWP LOT NO. 11, 30

VILLAGE OF SOUTH AMHERST, LORAIN CO., OHIO

Requested by Louis C. Roth

By Charles P. Waryu, Reg. Surveyor No 5029

Oct. 1993

Charles P. Waryu

Registered Surveyor No. 5029