


05-00-012-103-
05-00-012-101

#14734

5-00-012-A

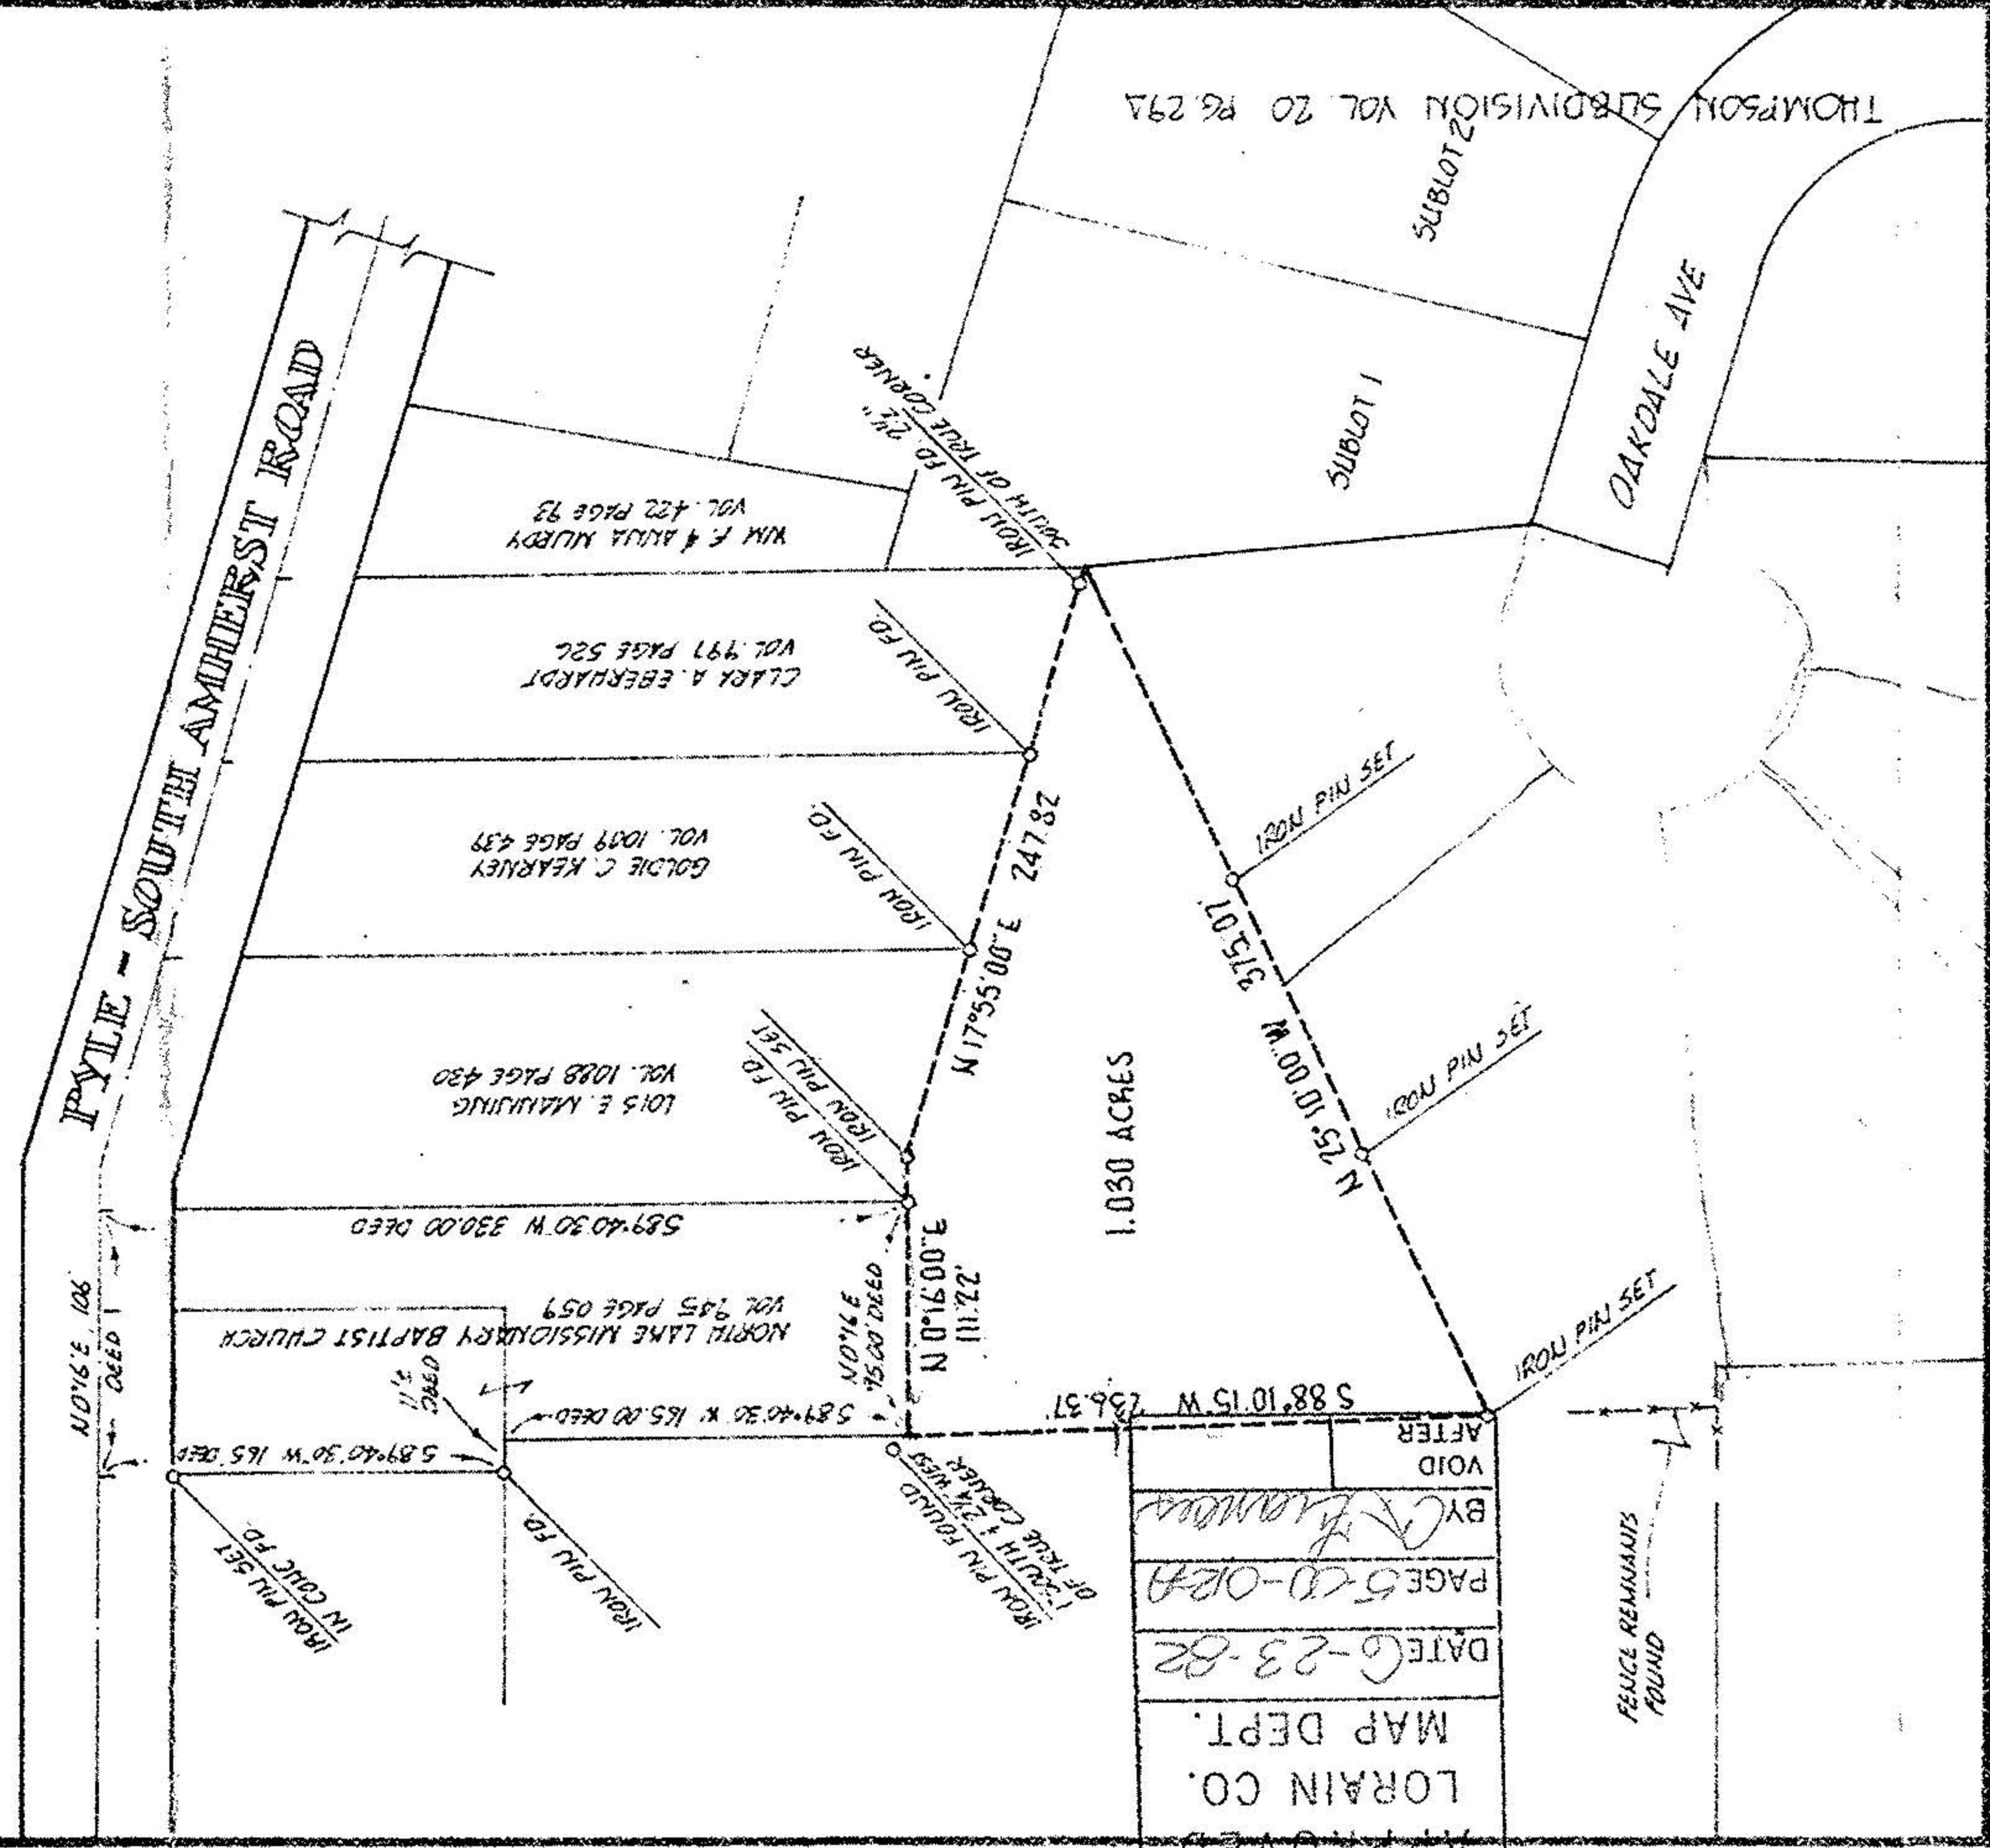

APPROVED
LORAIN CO.
MAP DEPT.
DATE 6-23-82
PAGE 5-0-02A
BY *[Signature]*
VOID AFTER



ACREAGE 1.030

DATE MAY 03-82

SCALE 1" = 100 FT. DRAWN MGH

PERMANENT PARCEL NO.

Michael G. Hura and Associates
3409 LIBERTY AVENUE VERMILION, OHIO

PERIMETER SURVEY

PART OF O.L. 12 TR. SECTION OF
AMHERST Township LORAIN County, Ohio
SUBLOT of VOL. PAGE OF PLATS