20241 [illegible] 70/— 014

Map of Part of O.L. 13 Amherst Twp. Lorain Co. Ohio
as described in deed Vol. 687 Page 228 Lorain Co. Deeds
Scale 1" 100' Sept. 10, 1992
By Arnold F. Koepp Reg. Surveyor No. 4306

#20241

APPROVED
LORAIN CO.
MAP DEPT.
DATE 2-18-93
PACE 5-00-013-A
BY T. McNair
VOID AFTER 20241
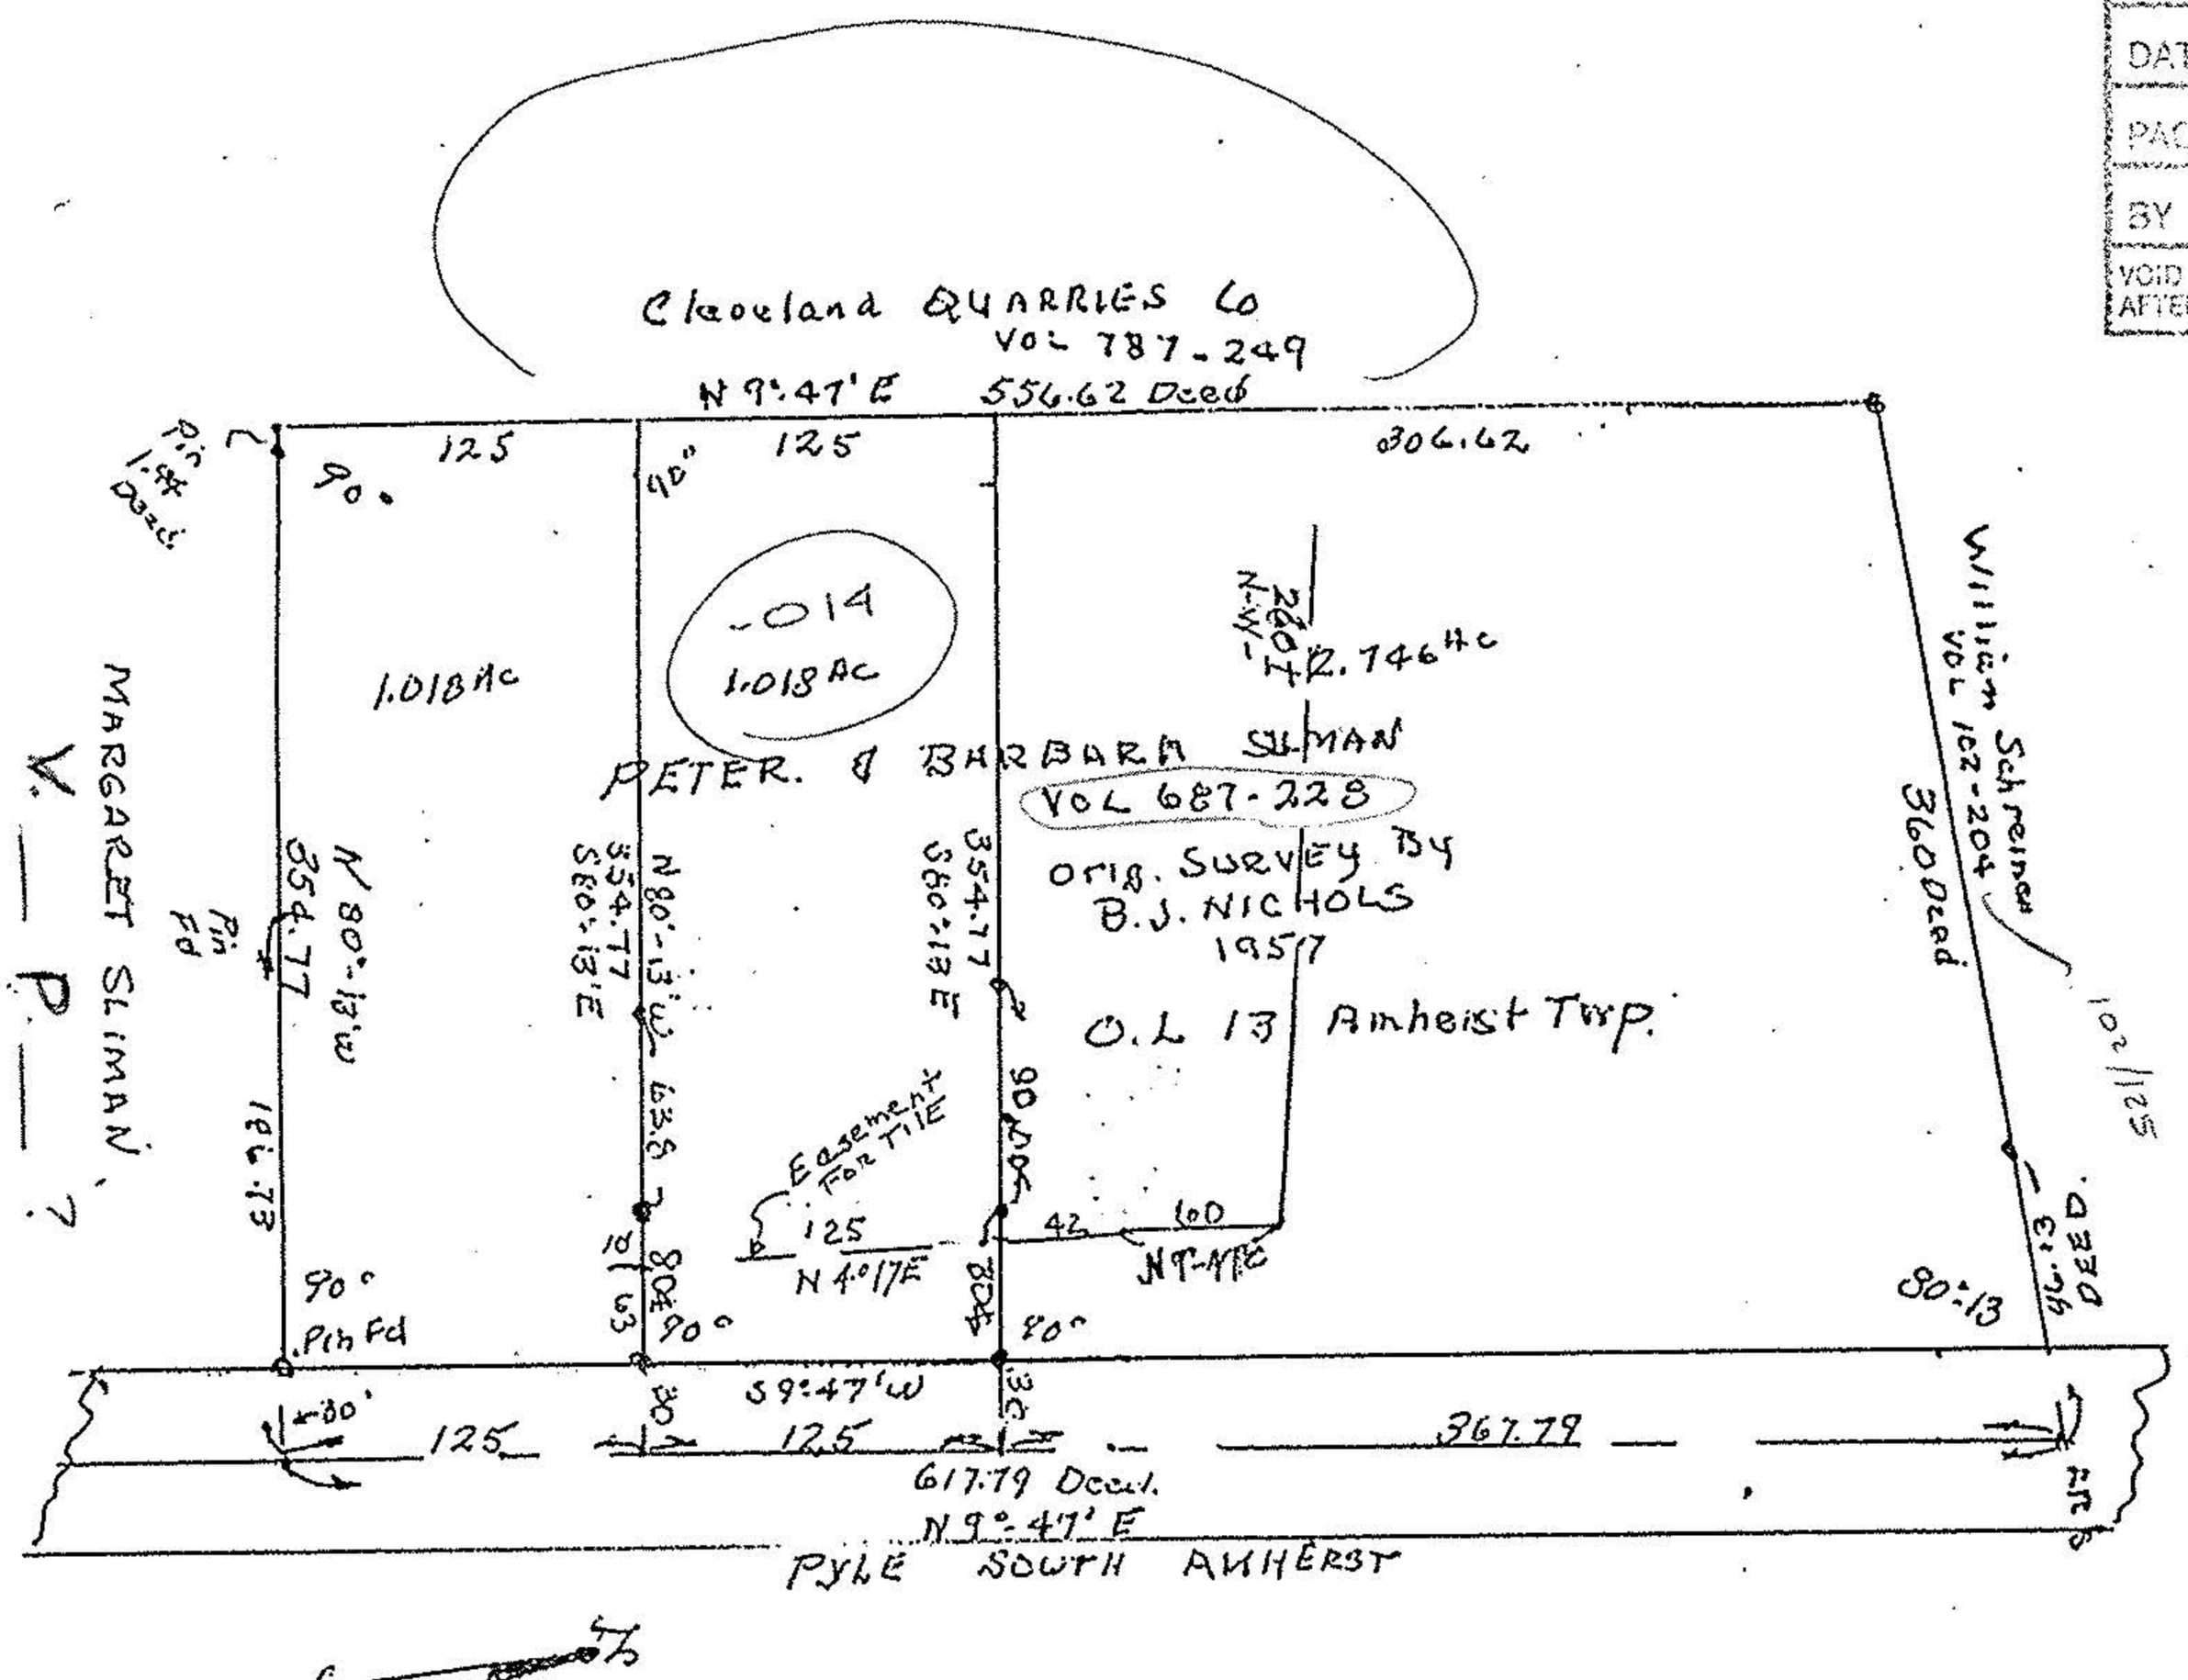
ARNOLD F. KOEPP
REGISTERED SURVEYOR
629 BRENNAN DRIVE
AMHERST, OHIO 44001
(216) 984-2158