Map of Part of O.L. 13 Amherst Twp Lorain Co Ohio
as described in Deed. Vol. 687 Page 228 Lorain Co Deeds
Scale 1"=100' SURVEYS June 1970 MAY 1978 Nov. 7-1992 April 27-1993 Set Pins.
By Arnold F. Koepp Reg. Surveyor No 4306
ORIGINAL SURVEY by Arnold Koepp JUNE 1970

Revised

20704

APPROVED
LORAIN CO.
MAP DEPT.
DATE 1-25-94
PAGE 5-00-013A
BY CAROLYN FRANCIS
VOID AFTER # 20704

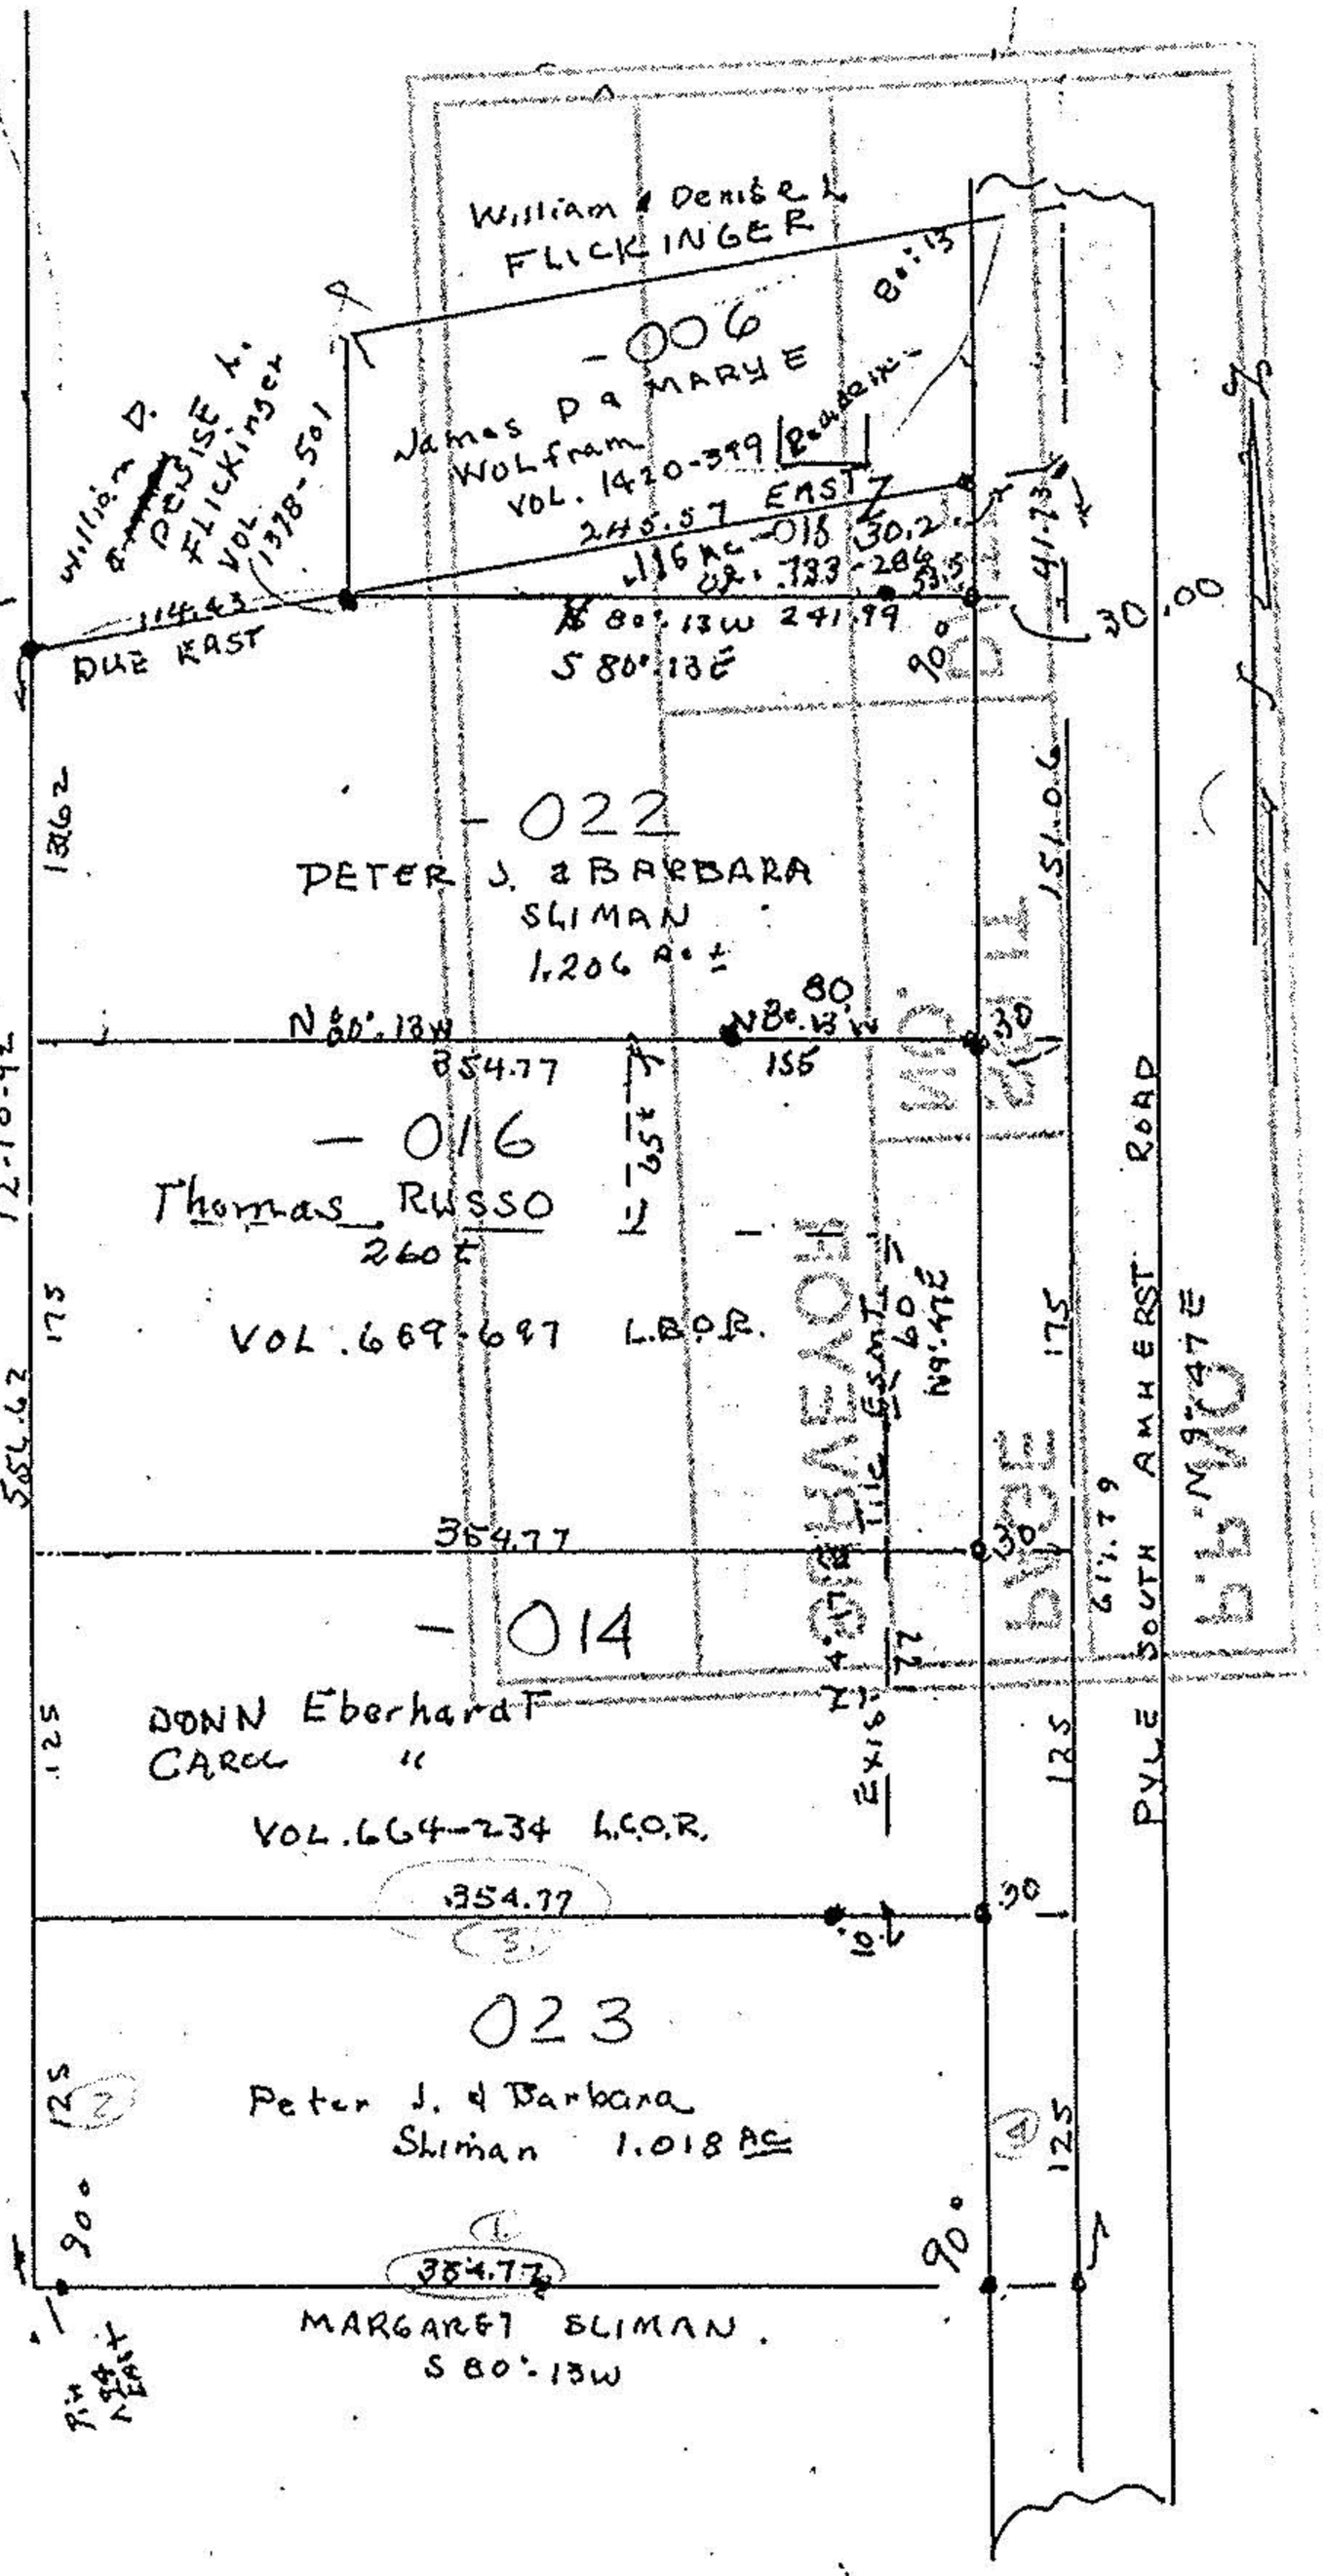

ARNOLD F. KOEPP
REGISTERED SURVEYOR
629 BRENNAN DRIVE
AMHERST, OHIO 44001
(216) 984-2158