-025

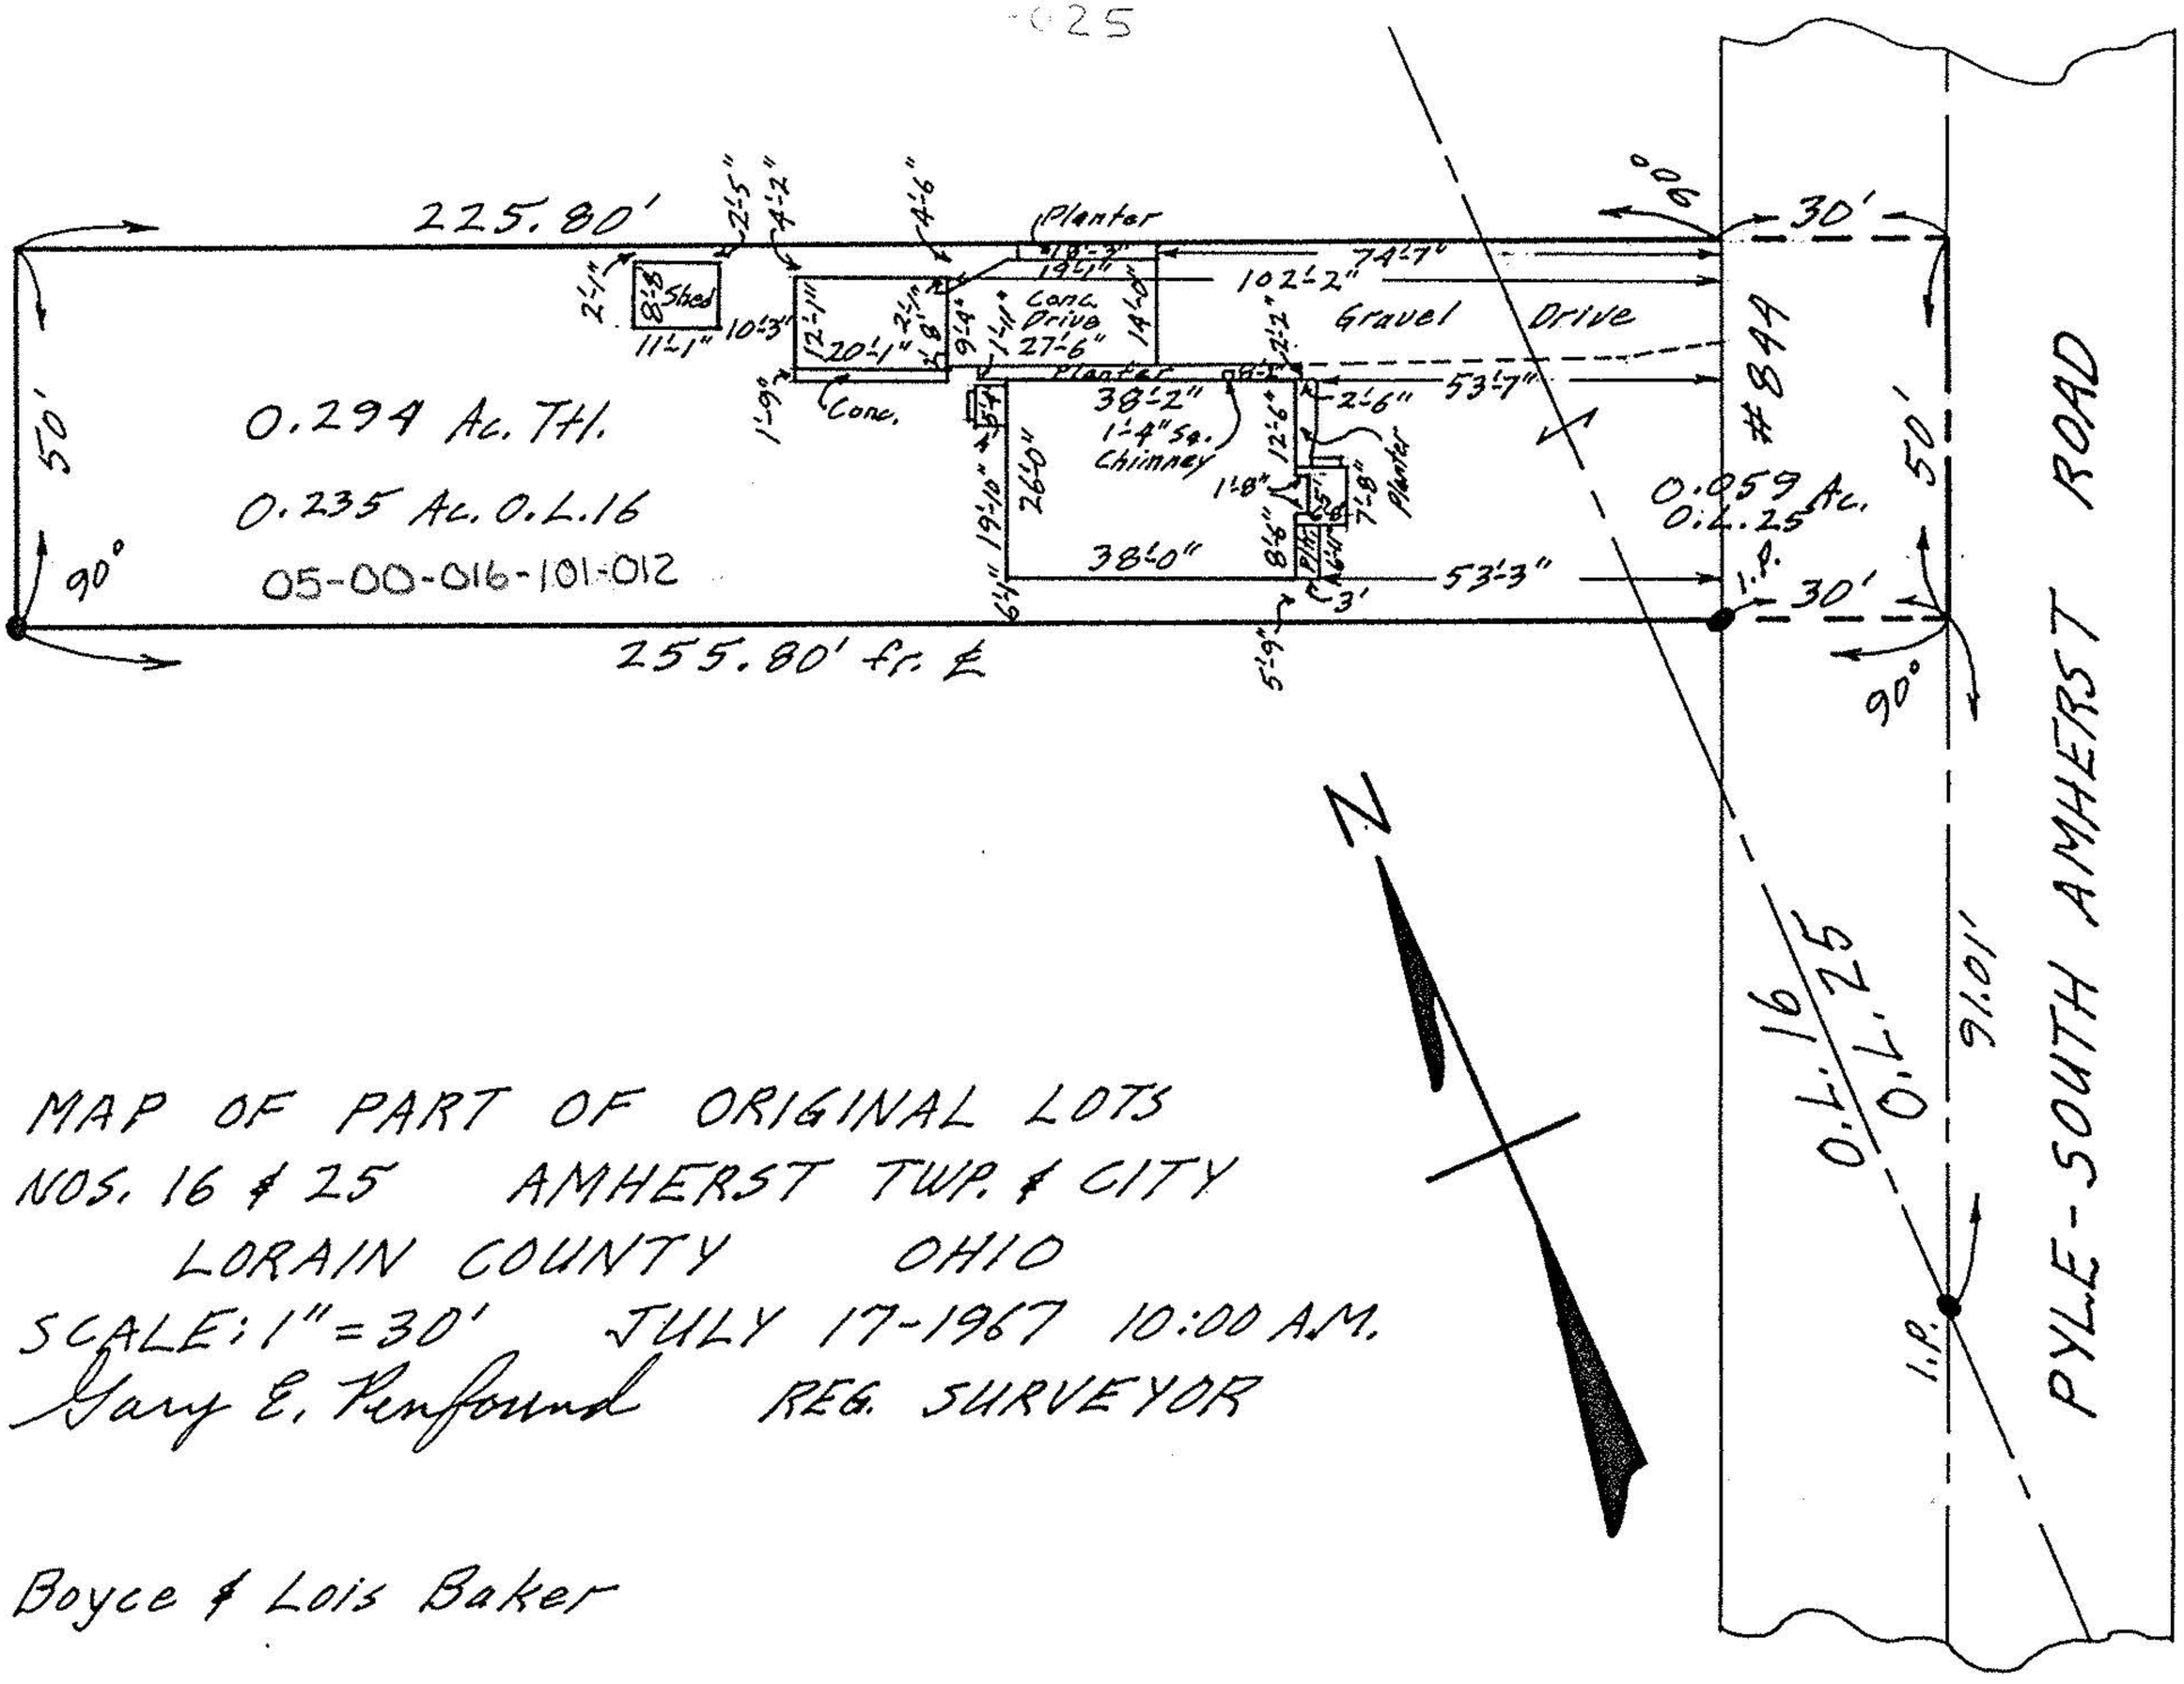

MAP OF PART OF ORIGINAL LOTS
NOS. 16 & 25 AMHERST TWP. & CITY
LORAIN COUNTY OHIO
SCALE: 1" = 30' JULY 17-1967 10:00 A.M.
Gary E. Penfound REG. SURVEYOR

Boyce & Lois Baker