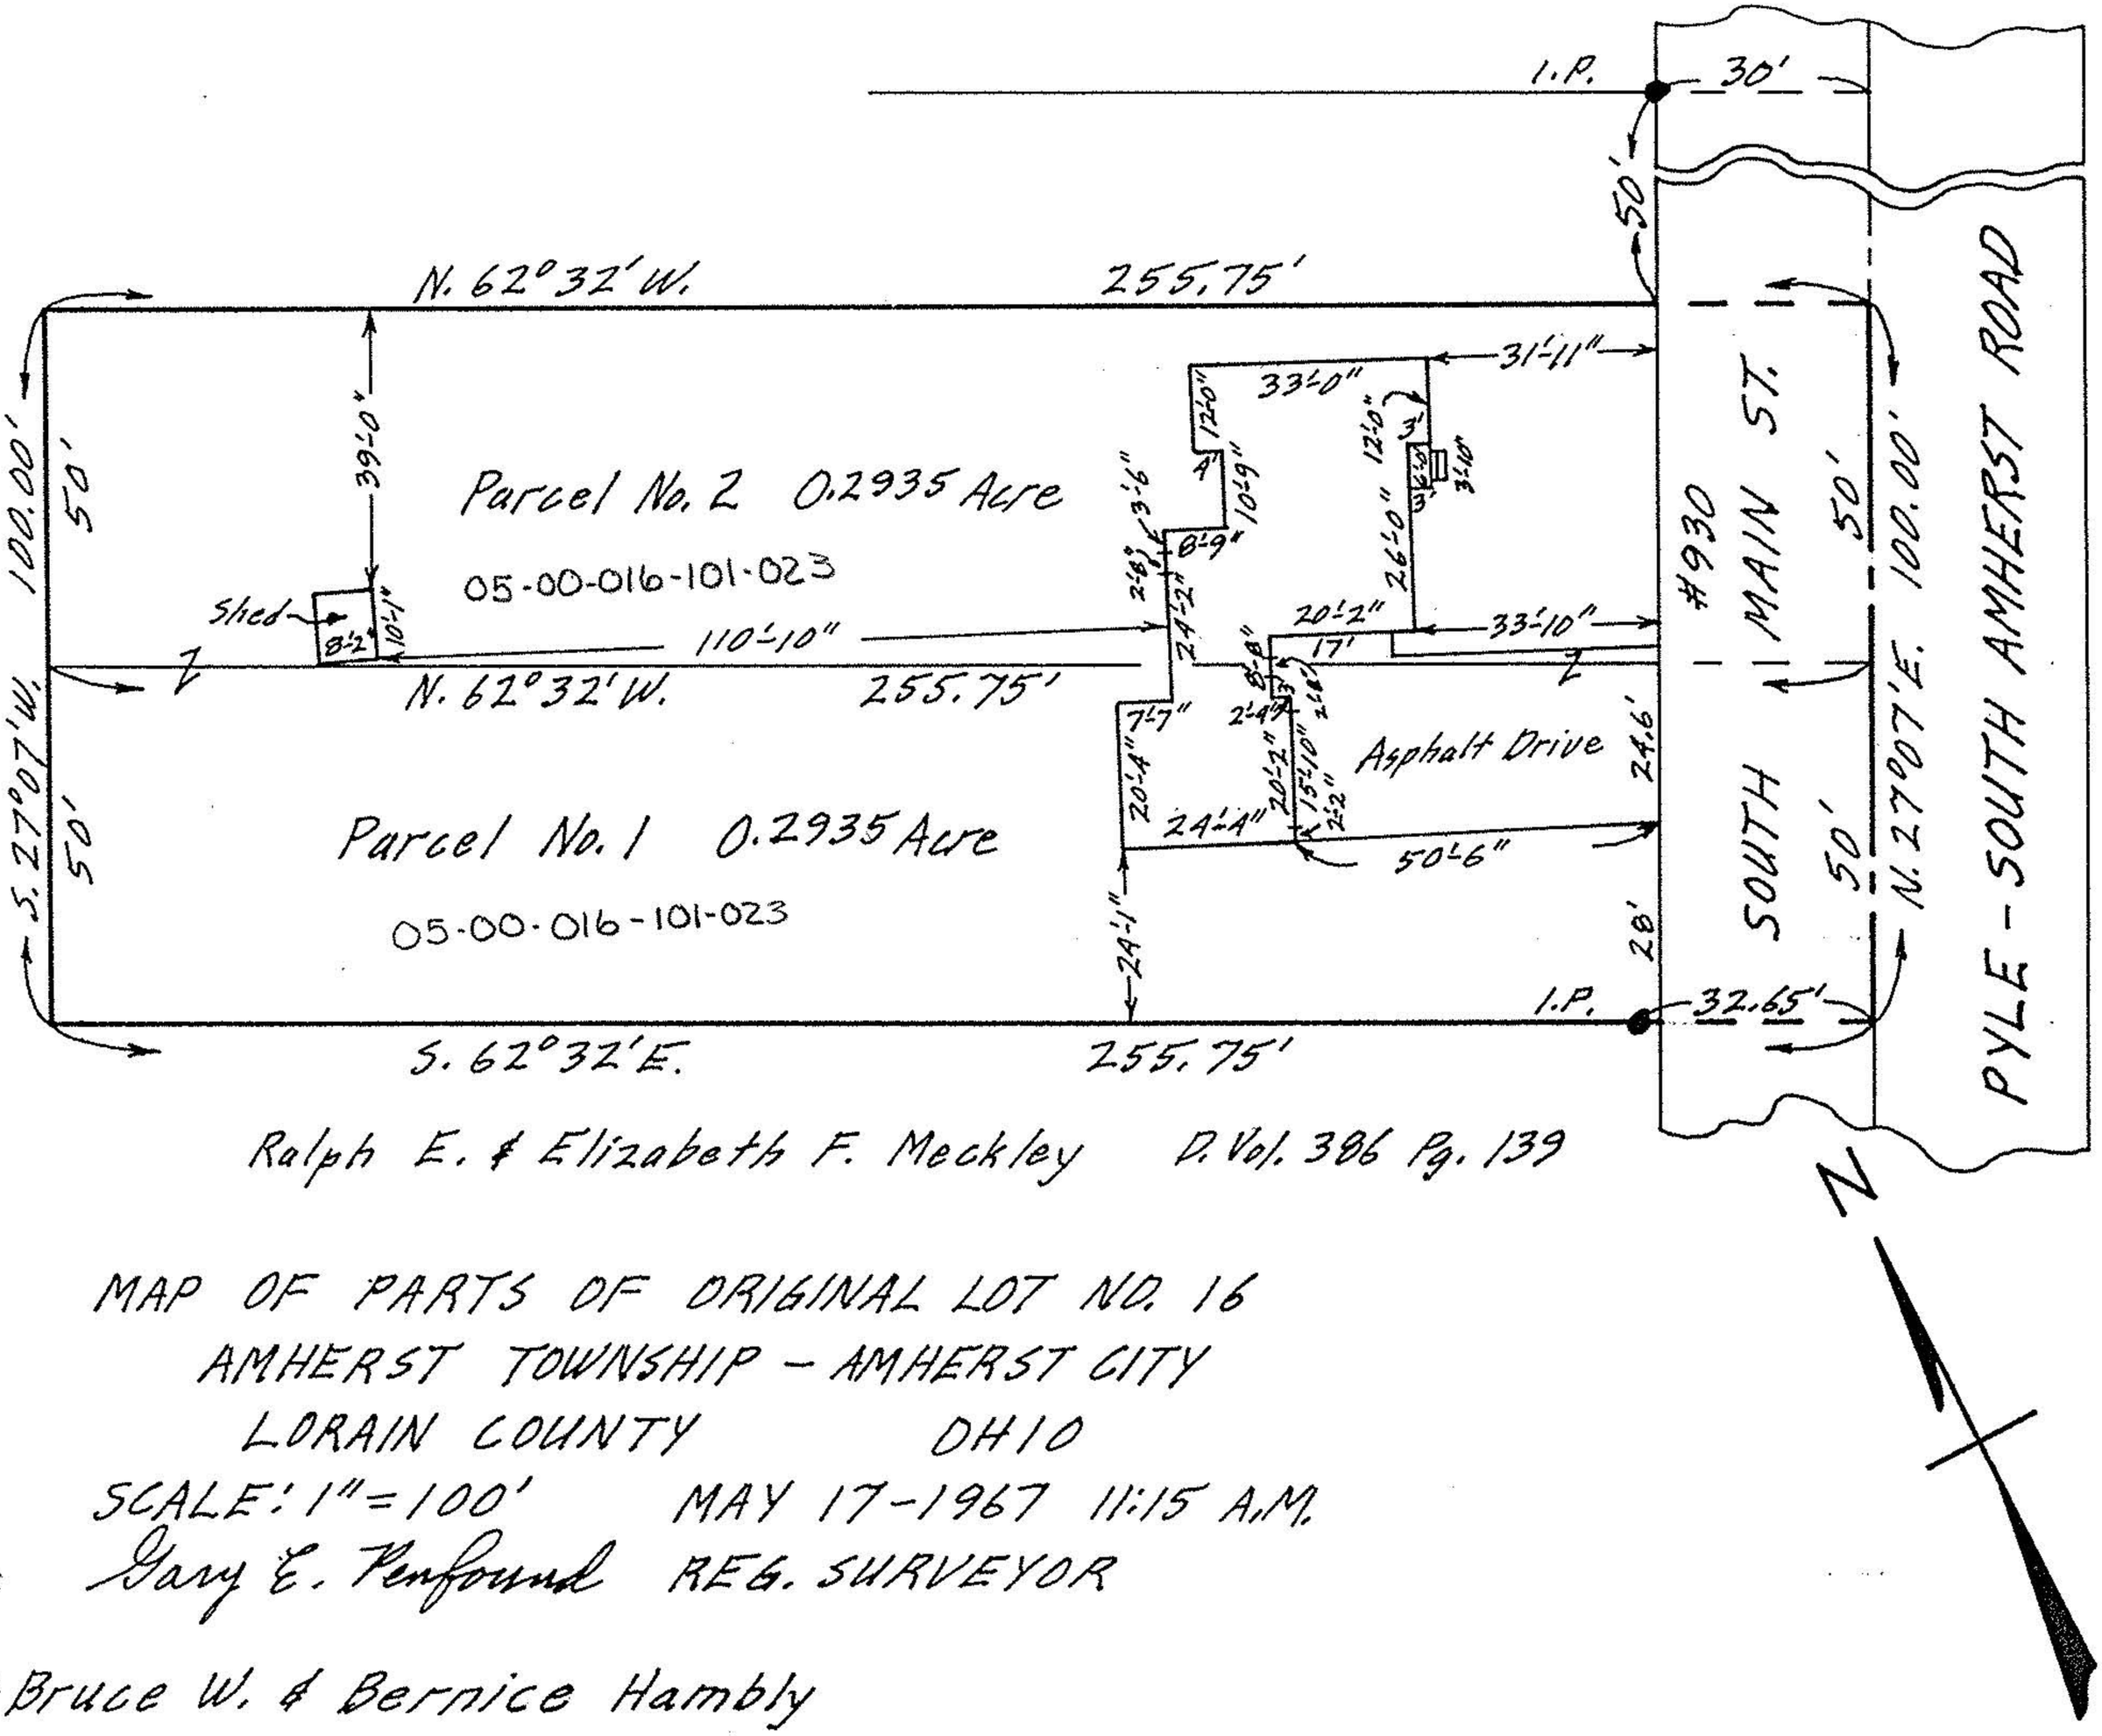

Ralph E. & Elizabeth F. Meckley D. Vol. 386 Pg. 139

MAP OF PARTS OF ORIGINAL LOT NO. 16
AMHERST TOWNSHIP - AMHERST CITY
LORAIN COUNTY OHIO
SCALE: 1" = 100' MAY 17-1967 11:15 A.M.
Gary E. Penfound REG. SURVEYOR

Bruce W. & Bernice Hambly