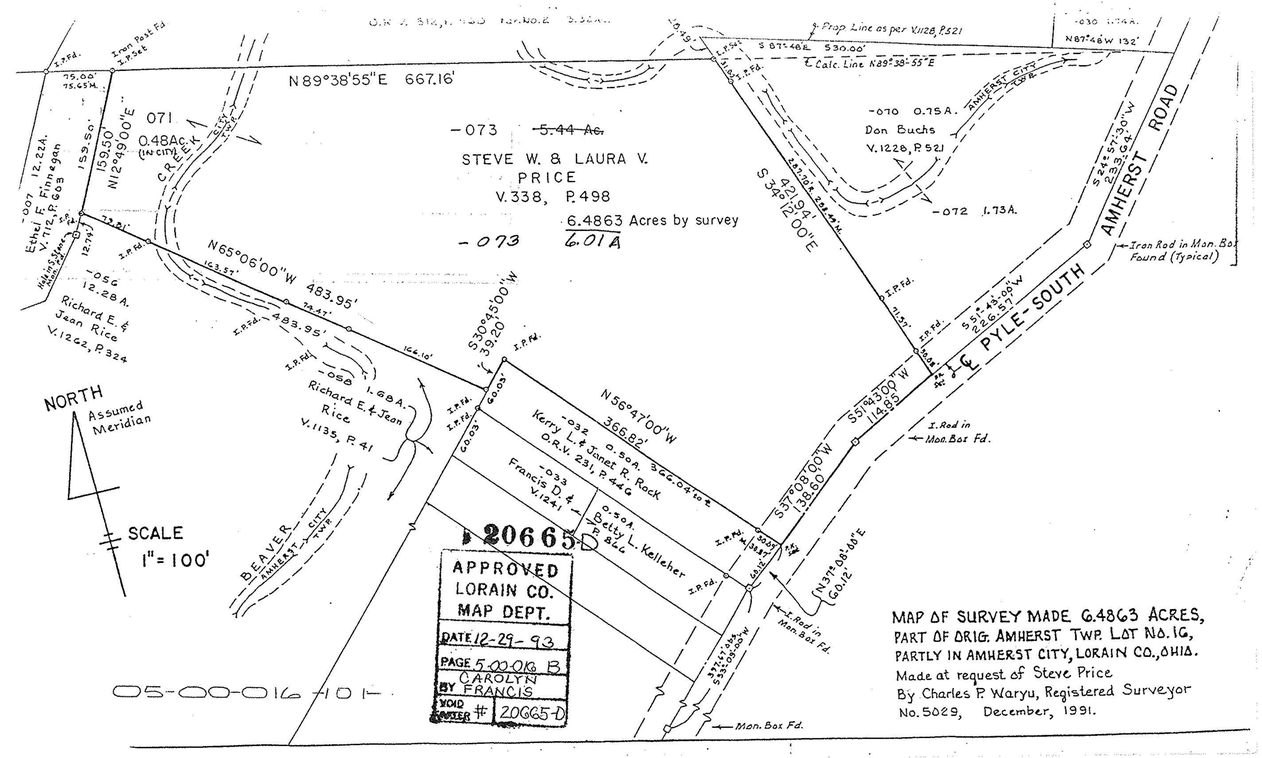
N89°38'55"E 667.16'
-073 5.44 Ac.
STEVE W. & LAURA V. PRICE
V. 338, P. 498
6.4863 Acres by survey
6.01A
071 0.48Ac. (In city)
-070 0.75A. Don Buchs V. 1228, P. 521
-072 1.73A.
-056 12.28A. Richard E. & Jean Rice V. 1262, P. 324
-058 1.68A. Richard E. & Jean Rice V. 1135, P. 41
-032 Kerry L. & Janet R. Rock O.R.V. 231, P. 446
-033 Francis D. & Betty L. Kelleher V. 1241
0.50A. P. 824
Ethel E. Finnegan V. 712, P. 609
Ernest J. & Dorothy M. Papay O.R.V. 312, P. 560 Par. No. 2 3.32Ac.
Geo. E. & Alberta M. Bach V. 1367 P. 567 -030 1.74A.
Prop. Line as per V. 1128, P. 521
Calc. Line N89°38'55"E
S 87°48'E 530.00'
N87°48'W 132'
S 34°12'00"E 421.94'
S 24°57'30"W 233.64'
S 51°43'00"W 114.95'
S 37°08'00"W 138.80'
N 56°47'00"W 366.82'
N 65°06'00"W 483.95'
S 30°45'00"W 39.20'
N 37°08'00"E 60.12'
AMHERST ROAD
PYLE-SOUTH
Iron Rod in Mon. Box Found (Typical)
I. Rod in Mon. Box Fd.
Mon. Box Fd.
NORTH
Assumed Meridian
SCALE 1" = 100'
BEAVER
AMHERST CITY TWP.
CREEK
20665-D
APPROVED
LORAIN CO.
MAP DEPT.
DATE 12-29-93
PAGE 5-00-016 B
BY CAROLYN FRANCIS
VOID ORIGINAL # 20665-D
05-00-016-101
MAP OF SURVEY MADE 6.4863 ACRES,
PART OF ORIG. AMHERST TWP. LOT NO. 16,
PARTLY IN AMHERST CITY, LORAIN CO., OHIO.
Made at request of Steve Price
By Charles P. Waryu, Registered Surveyor
No. 5029, December, 1991.

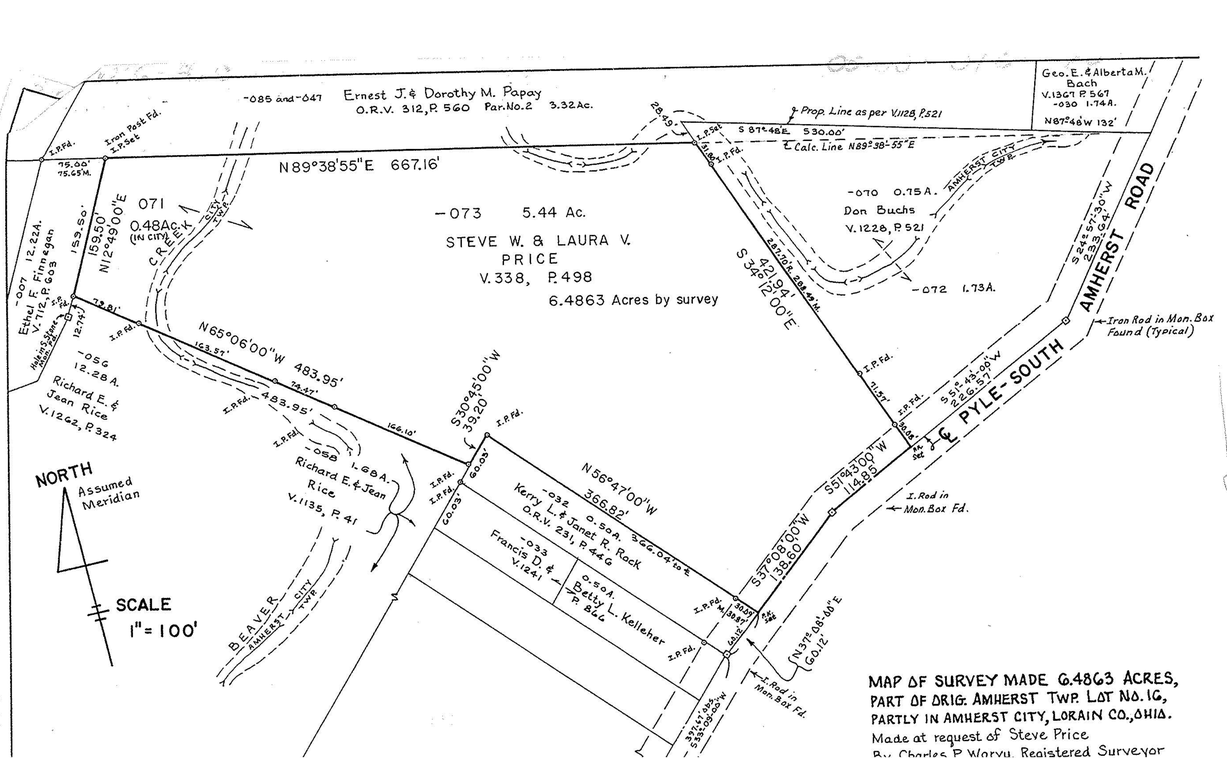
N89°38'55"E 667.16'
-073 5.44 Ac.
STEVE W. & LAURA V. PRICE
V. 338, P. 498
6.4863 Acres by survey
071 0.48Ac. (In city)
-070 0.75A. Don Buchs V. 1228, P. 521
-072 1.73A.
-056 12.28A. Richard E. & Jean Rice V. 1262, P. 324
-058 1.68A. Richard E. & Jean Rice V. 1135, P. 41
-032 Kerry L. & Janet R. Rock O.R.V. 231, P. 446
-033 Francis D. & Betty L. Kelleher V. 1241
0.50A. P. 824
Ethel E. Finnegan V. 712, P. 609
Ernest J. & Dorothy M. Papay O.R.V. 312, P. 560 Par. No. 2 3.32Ac.
Geo. E. & Alberta M. Bach V. 1367 P. 567 -030 1.74A.
Prop. Line as per V. 1128, P. 521
Calc. Line N89°38'55"E
S 87°48'E 530.00'
N87°48'W 132'
S 34°12'00"E 421.94'
S 24°57'30"W 233.64'
S 51°43'00"W 114.95'
S 37°08'00"W 138.80'
N 56°47'00"W 366.82'
N 65°06'00"W 483.95'
S 30°45'00"W 39.20'
N 37°08'00"E 60.12'
AMHERST ROAD
PYLE-SOUTH
Iron Rod in Mon. Box Found (Typical)
I. Rod in Mon. Box Fd.
NORTH
Assumed Meridian
SCALE 1" = 100'
BEAVER
AMHERST CITY TWP.
CREEK
MAP OF SURVEY MADE 6.4863 ACRES,
PART OF ORIG. AMHERST TWP. LOT NO. 16,
PARTLY IN AMHERST CITY, LORAIN CO., OHIO.
Made at request of Steve Price
By Charles P. Waryu, Registered Surveyor