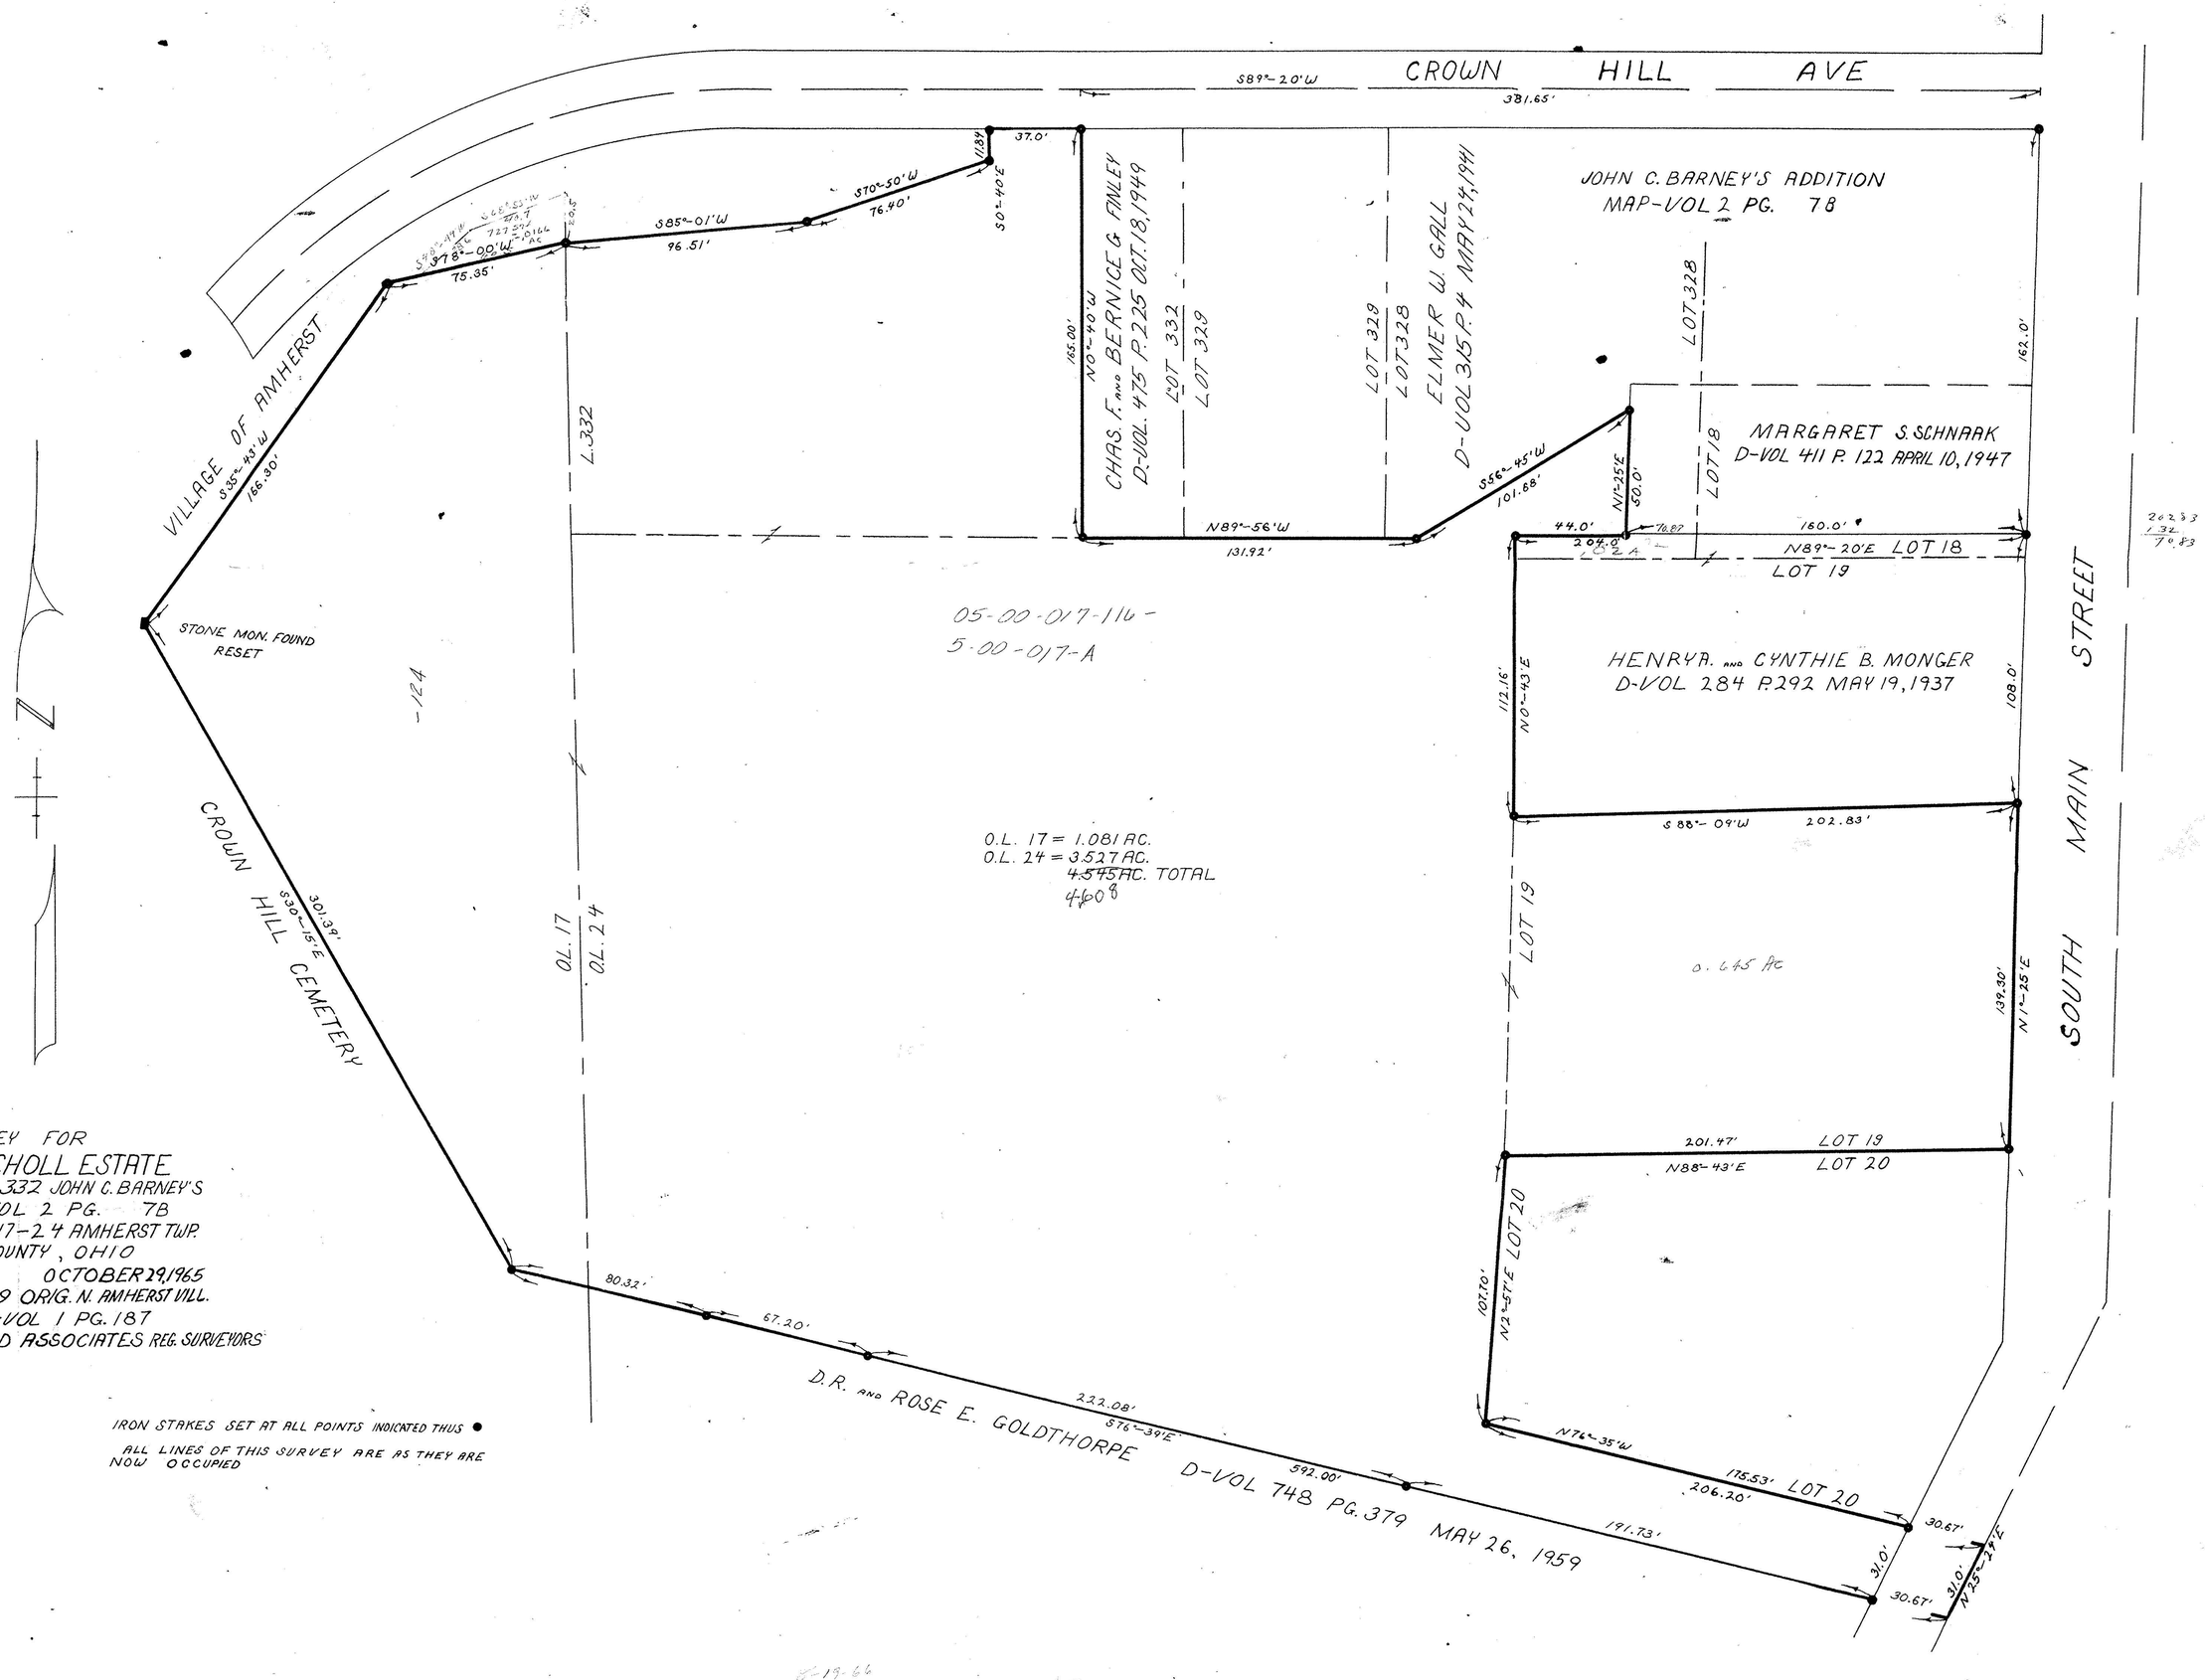

SURVEY FOR
HARRY NICHOLL ESTATE
PART OF LOT 332 JOHN C. BARNEY'S
ADDN. MAP-VOL 2 PG. 78
PART OF O.L. 17-24 AMHERST TWP.
LORAIN COUNTY, OHIO
SCALE 1"=30" OCTOBER 29, 1965
PART OF LOT 19 ORIG. N. AMHERST VILL.
PLAT. D-VOL 1 PG. 187
D.D. ANDRUS AND ASSOCIATES REG. SURVEYORS

IRON STAKES SET AT ALL POINTS INDICATED THUS ●

ALL LINES OF THIS SURVEY ARE AS THEY ARE NOW OCCUPIED

8-19-66
Please return survey to
Auditor's Office for land title &