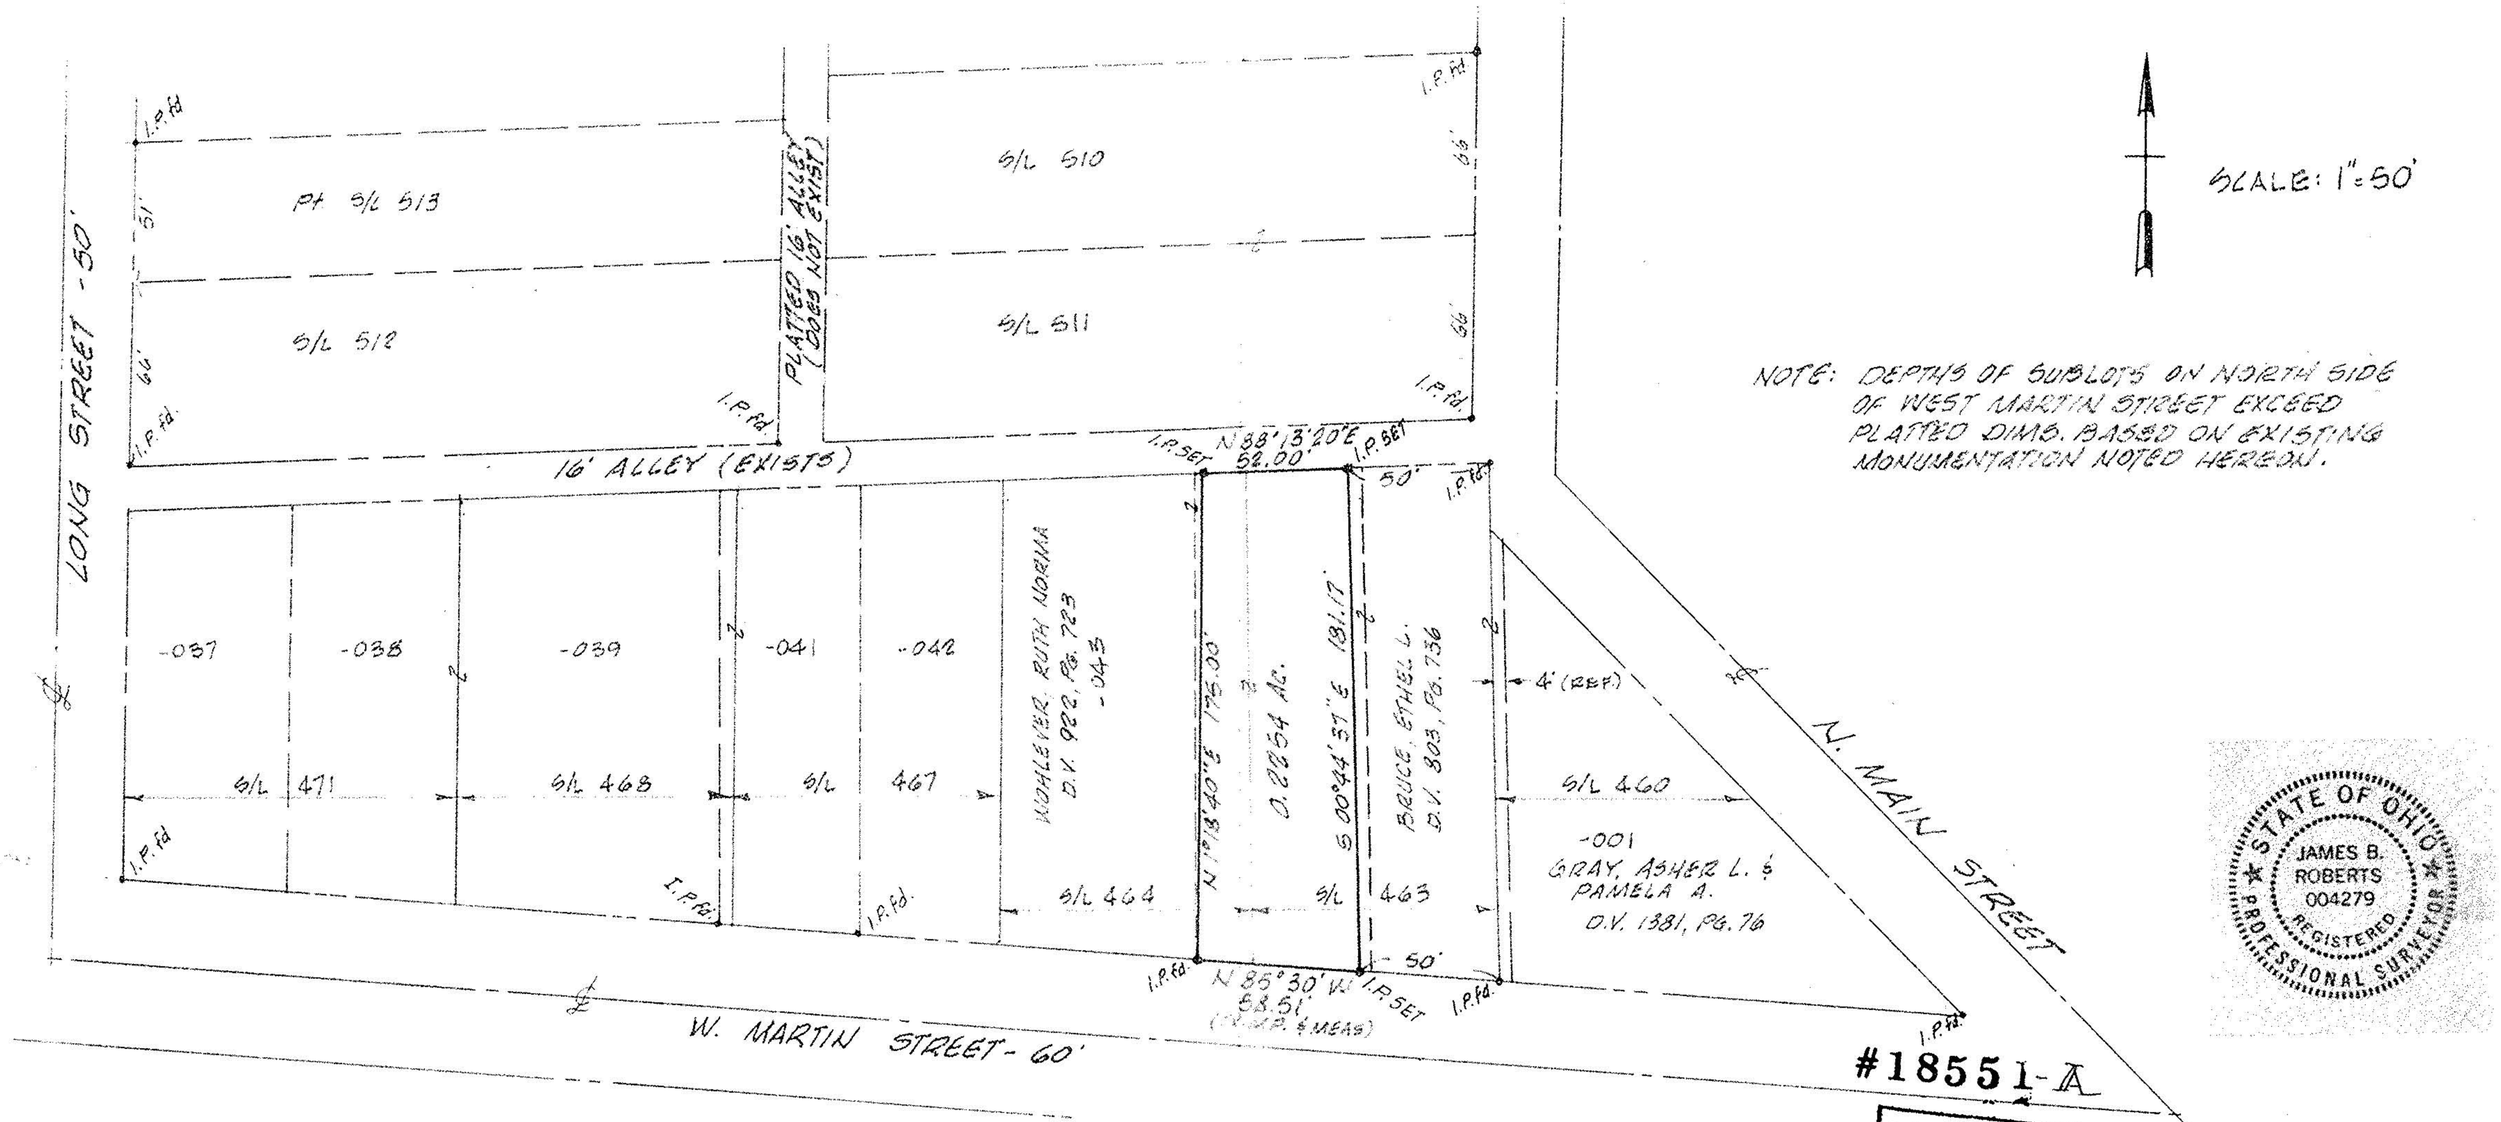

NOTE: DEPTHS OF SUBLOTS ON NORTH SIDE OF WEST MARTIN STREET EXCEED PLATTED DIMS. BASED ON EXISTING MONUMENTATION NOTED HEREON.

STATE OF OHIO
JAMES B. ROBERTS
004279
REGISTERED
PROFESSIONAL SURVEYOR

#18551-A

APPROVED
LORAIN CO.
MAP DEPT.
DATE 7-28-89
PAGE 5-00-018-B
BY T. McClain
VOID AFTER 18551-A

MAP of BOUNDARY SURVEY

PREPARED FOR MIDLAND TITLE SECURITY INC.

PARTS of SUBLOT NOS. 463 & 464 of GEORGE ASHENBACH'S ADDITIONAL TOWN PLAT of NORTH AMHERST - PLAT VOL. 2, PG. 12

PART of ORIGINAL AMHERST TOWNSHIP LOT No. 13
NOW in CITY of AMHERST, LORAIN COUNTY, OHIO

K.E. McCARTNEY & ASSOCIATES
PROFESSIONAL ENGINEERS & SURVEYORS
ELYRIA OHIO
JULY, 1989 #892701