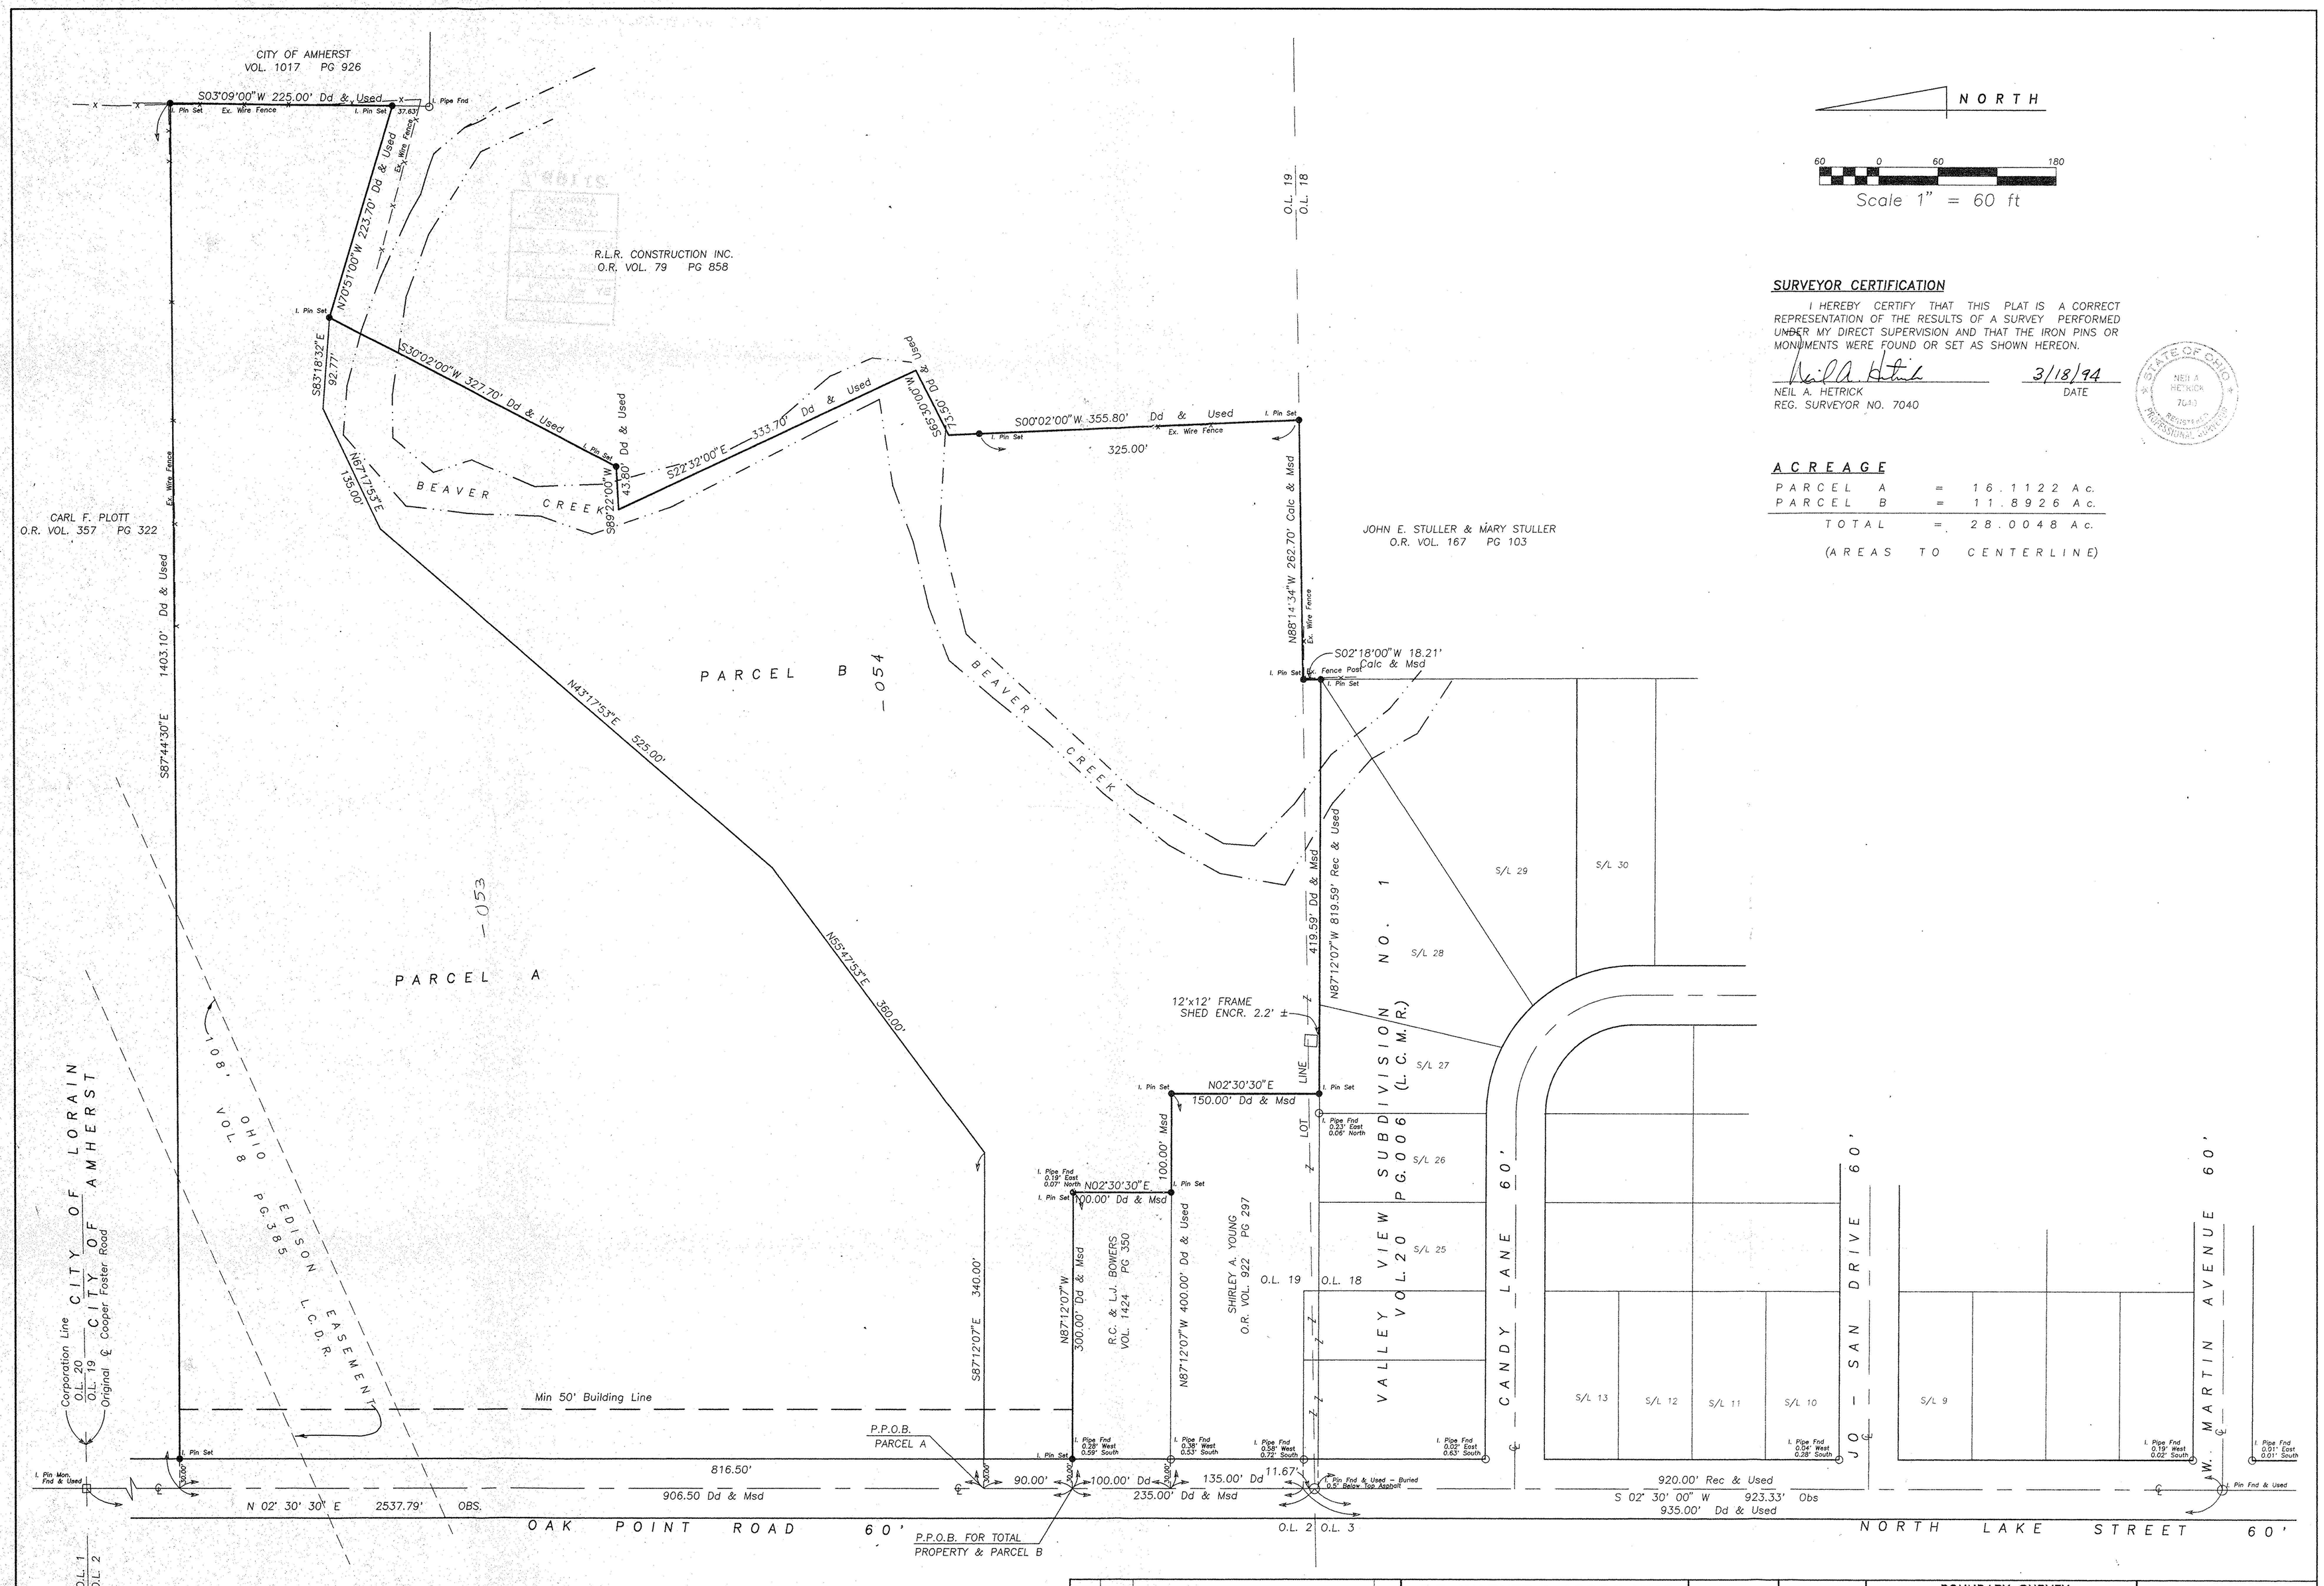

SURVEYOR CERTIFICATION

I HEREBY CERTIFY THAT THIS PLAT IS A CORRECT REPRESENTATION OF THE RESULTS OF A SURVEY PERFORMED UNDER MY DIRECT SUPERVISION AND THAT THE IRON PINS OR MONUMENTS WERE FOUND OR SET AS SHOWN HEREON.

NEIL A. HETRICK
REG. SURVEYOR NO. 7040

3/18/94
DATE

STATE OF OHIO — NEIL A. HETRICK 7040 — REGISTERED PROFESSIONAL SURVEYOR

ACREAGE

PARCEL A	=	16.1122 Ac.
PARCEL B	=	11.8926 Ac.
TOTAL	=	28.0048 Ac.

(AREAS TO CENTERLINE)

NO.	DATE	DESCRIPTION	BY

REVISIONS

R.E. WARNER & ASSOCIATES
ENGINEERS
GEMINI TOWERS II
2001 CROCKER ROAD
WESTLAKE, OHIO 44145
216-835-9400

DR. BY LAH
CHK. BY NAH
APR. BY EAD
DATE MAY 20, 1994
SCALE 1" = 60'
JOB NO. 86293
DWG NAME POLICPLT

BOUNDARY SURVEY
CITY OF AMHERST
POLICE & JAIL FACILITY
BEING PART OF ORIGINAL AMHERST TOWNSHIP LOT NOS. 18. & 19, NOW IN THE CITY OF AMHERST OUNTY OF LORAIN AND STATE OF OHIO

PREPARED FOR/
THE CITY OF AMHERST

DRAWING NUMBER
86293 - 1