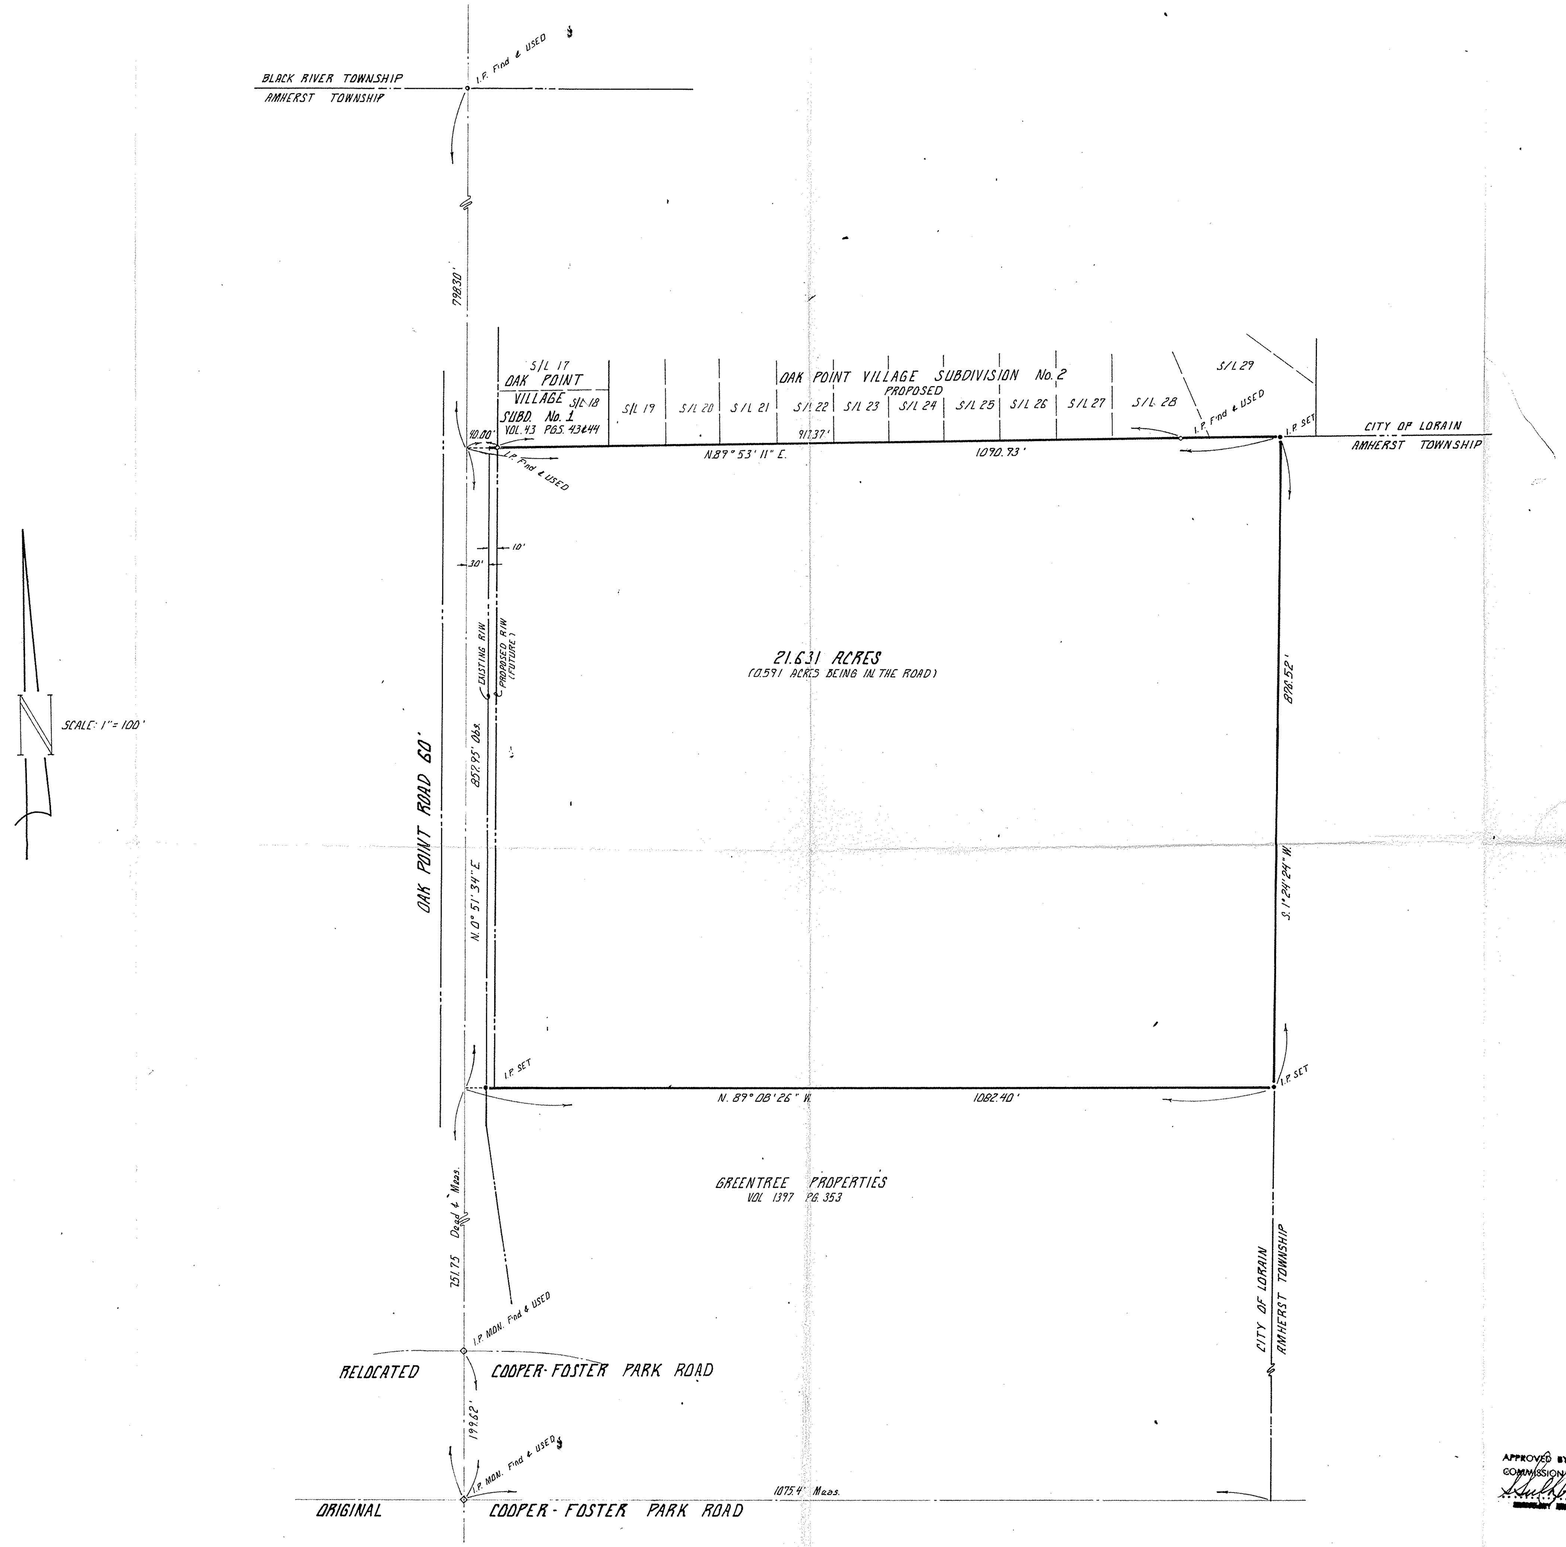

-05-00-020-000-

#18490

APPROVED
LORAIN CO.
MAP DEPT.
DATE 6-20-89
PAGE 5-00-020-A
BY Carolyn Francis
VOID AFTER # 18490

APPROVED BY THE LORAIN CITY PLANNING COMMISSION AS A L.S.D. NO PLAT REQUIRED
Date June 15 1989
SECRETARY, CITY OF LORAIN PLANNING COMMISSION

APPROVED
AS TO DESCRIPTION ONLY
Date June 15 1989
City of Lorain
Per
Engineering Dept.

PRINTED
JUN 12 1989
CT CONSULTANTS, INC.

COLPETZER-THOMAS, INC.
AN ENGINEERING GROUP
WILLOUGHBY • MENTOR • NORTH CANTON • STEUBENVILLE • LORAIN

REV. NO.	DESCRIPTION	DATE	BY	CH'K'D.

DESIGN CERTIFICATION
THIS PLAT WAS PREPARED BY ME, AND IS CORRECT TO THE BEST OF MY KNOWLEDGE AND BELIEF.
REG. SURVEYOR NO 5244

STATE OF OHIO
RICHARD BILSKI
5244
REGISTERED SURVEYOR

DATE: JUNE, 5 1989
DRAWN BY: D.A.G.
CHECKED BY:
APPROVED BY:
F.B. No. PG.

PLAT OF SURVEY
for
A.S.N. PARTNERSHIP
BEING A PART OF ORIGINAL AMHERST TOWNSHIP LOT NO. 20
CITY OF LORAIN, COUNTY OF LORAIN, OHIO

SCALES	
HOR.	1" = 100'
VERT.	
CONTRACT No.	89-134
SHEET NO.	OF
ONE	ONE