

PLAT OF BOUNDARY SURVEY
THOMAS R. THEADO

PART OF ORIGINAL LOT NOS. 17 & 24

CITY OF AMHERST, TOWNSHIP OF AMHERST, LORAIN COUNTY, OHIO



Legend

- X Property Corner, No Monumentation found or set
- Iron Pipe Found
- ⊙ Iron pin In Monument Box Found
- Lath Set
- ⊙ Magnetic PK Spike Set
- ▲ 5/8" Iron Pin Set with Cap Stamped "Kelser 7871"

BEARINGS
 ARE
 ASSUMED.

ERROR OF CLOSURE IS
 LESS THAN 1:10,000.

SCALE 1"=60'

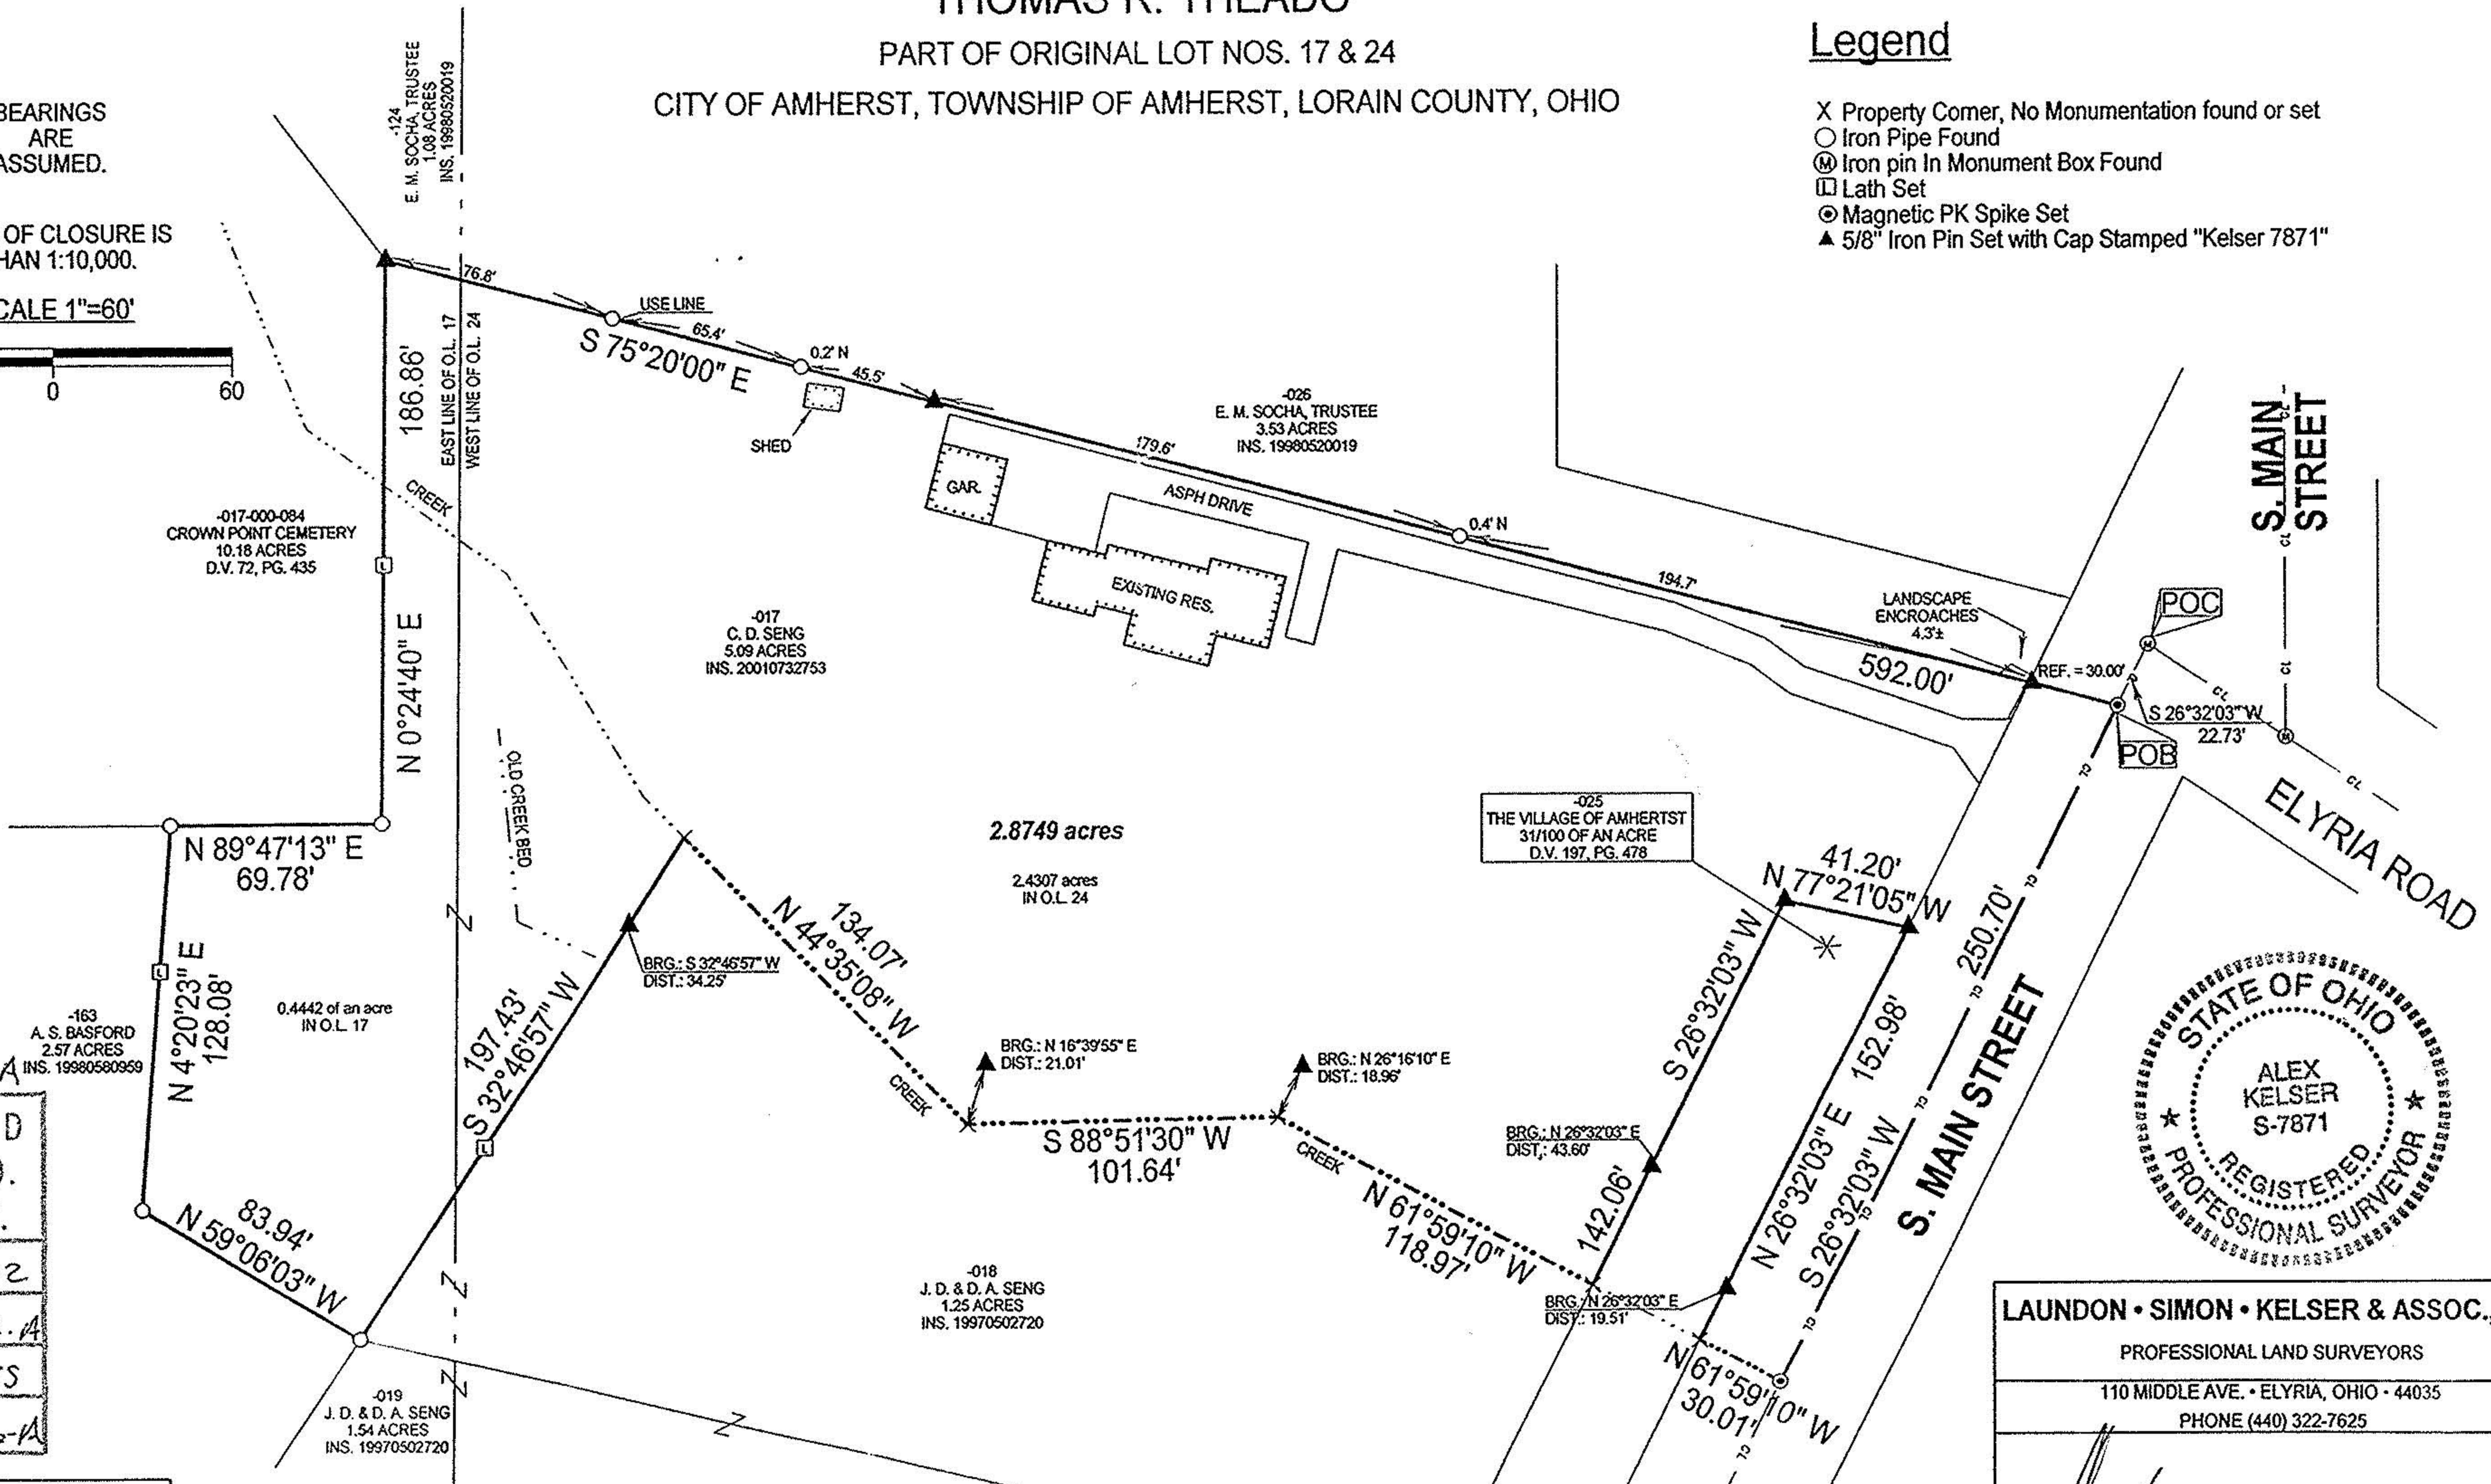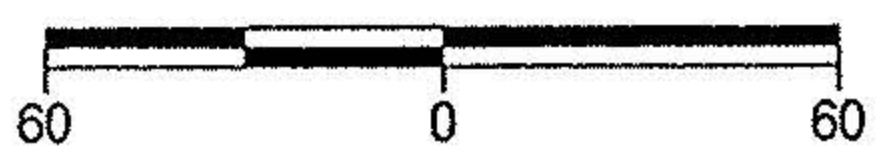

No 00746-A

APPROVED
 LORAIN CO.
 MAP DEPT.

DATE 7-27-02

PAGE S-00-024-A

BY R. MAWES

02-00746-A



LAUNDON • SIMON • KELSER & ASSOC., INC.

PROFESSIONAL LAND SURVEYORS

110 MIDDLE AVE. • ELYRIA, OHIO • 44035

PHONE (440) 322-7625

Alex Kelser

RLS #7871

DATE:	8/15/02
JOB NO.:	02-3483