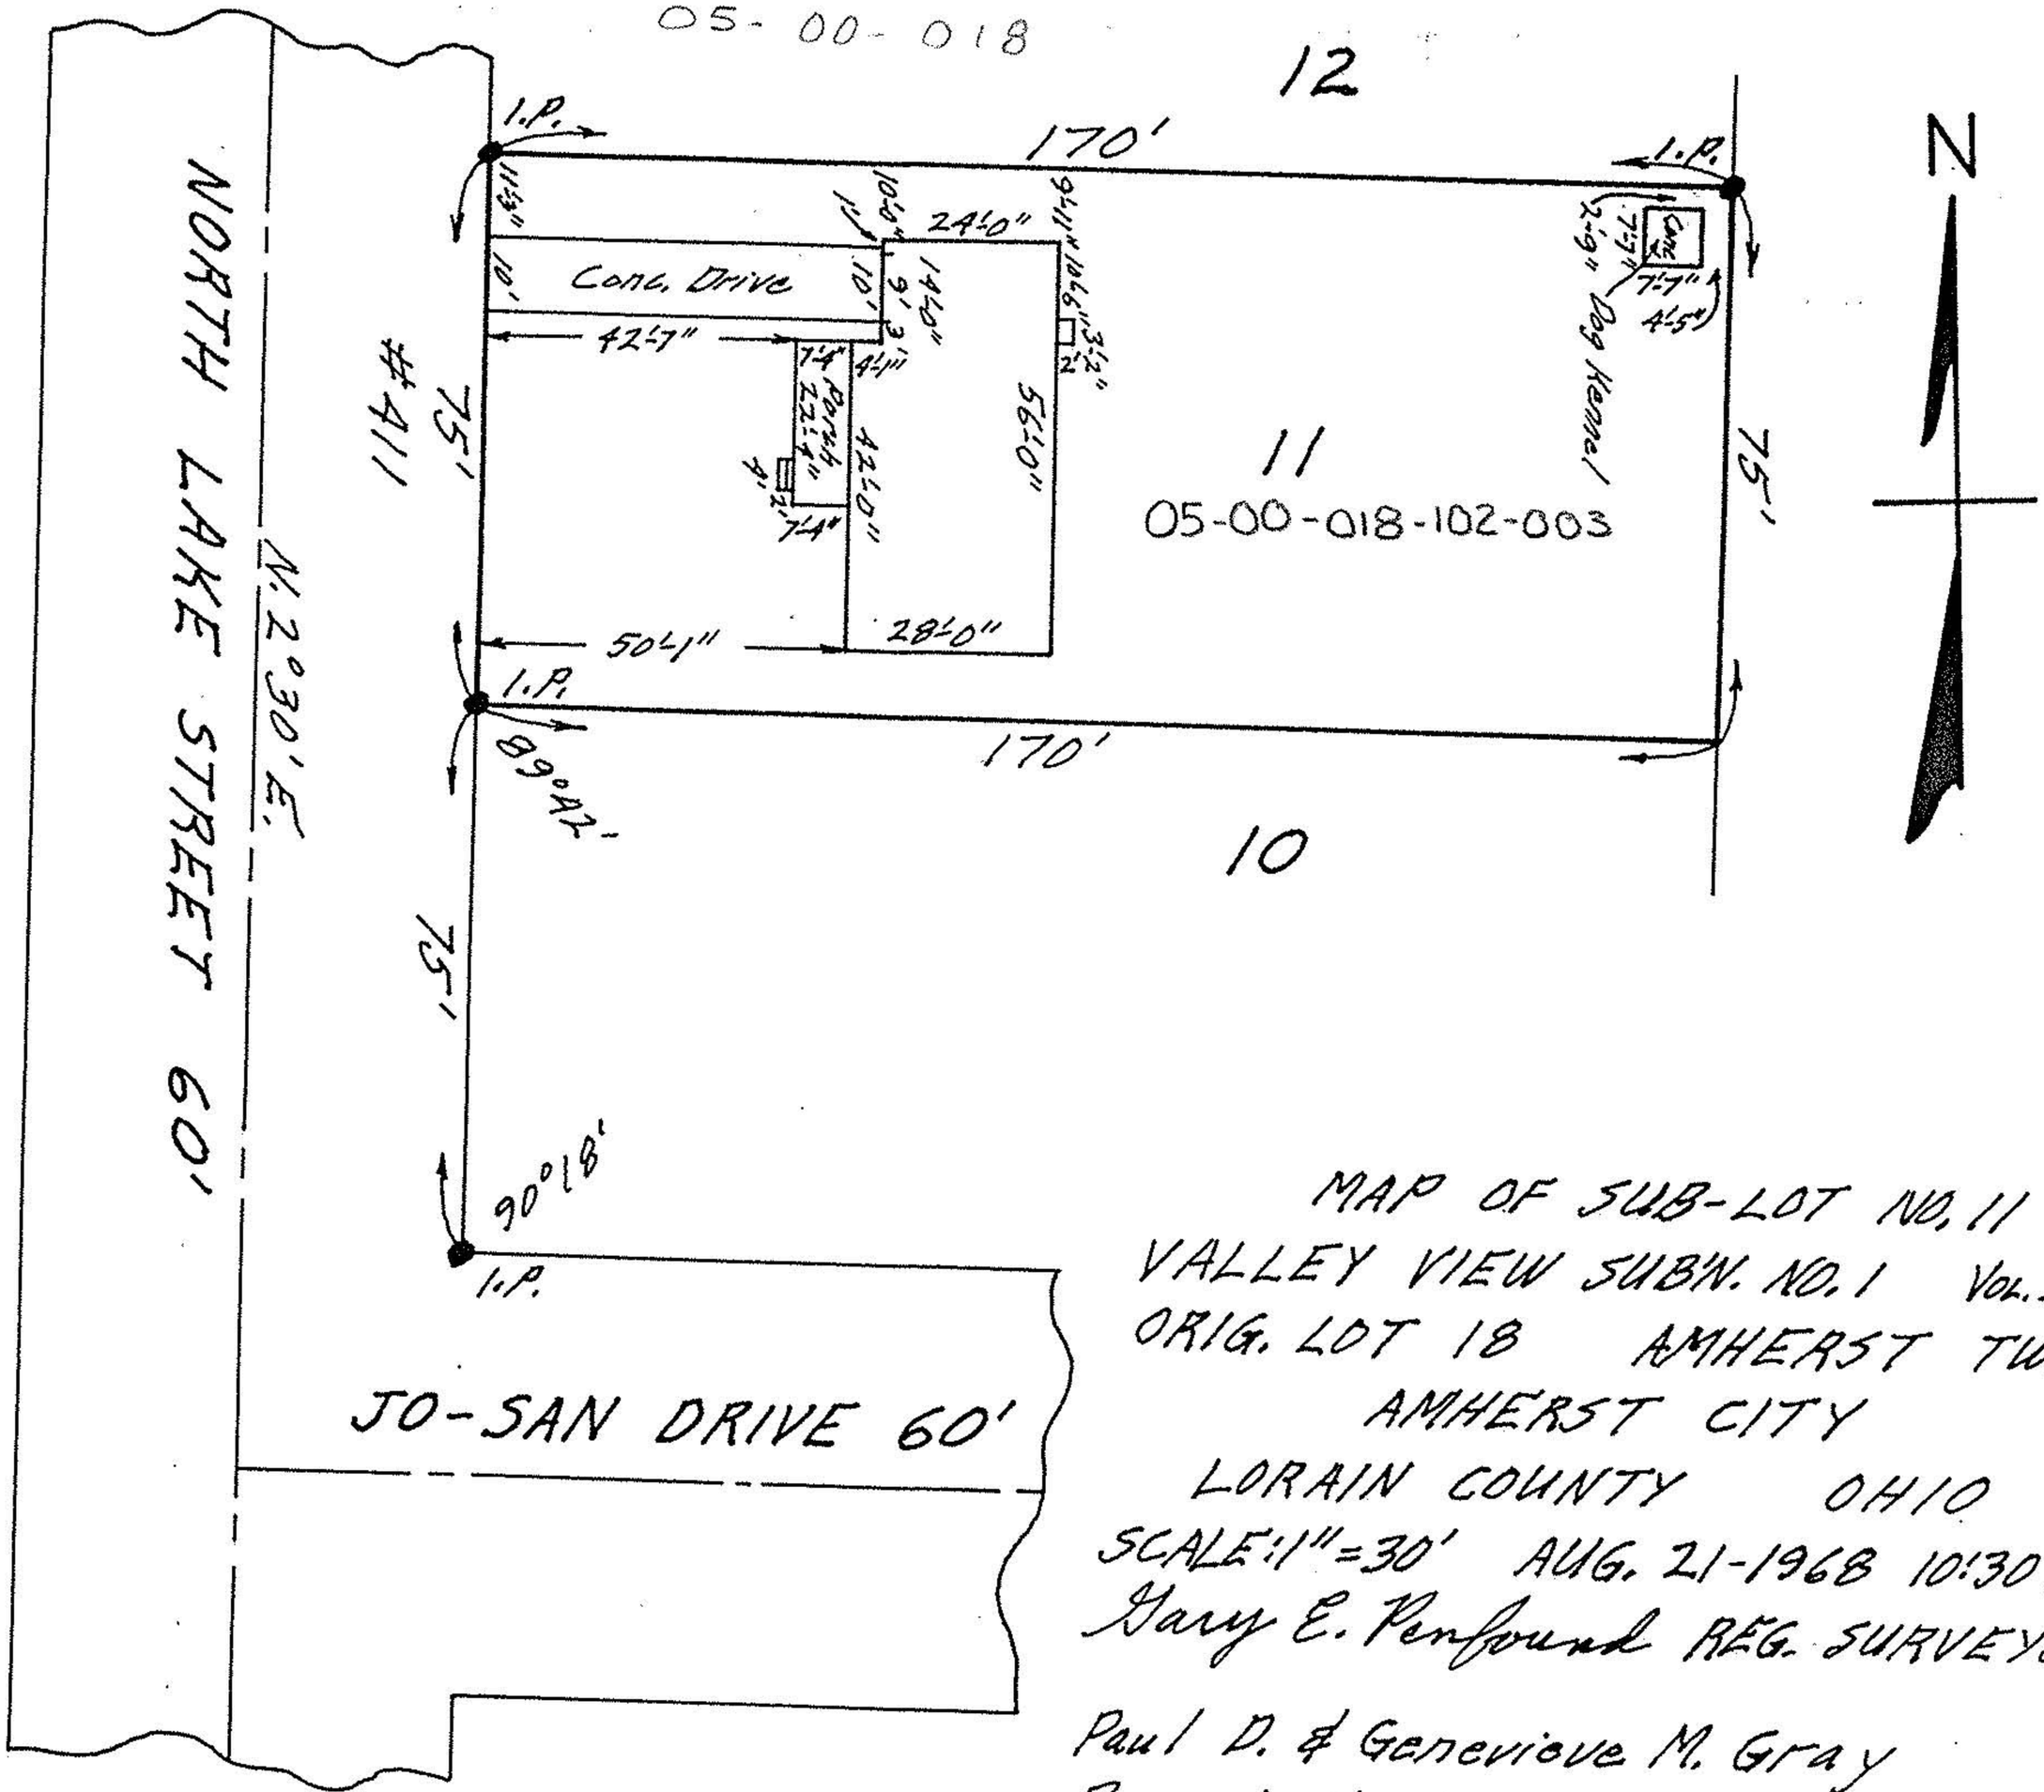

MAP OF SUB-LOT NO. 11
VALLEY VIEW SUB'N. NO. 1 Vol. 20 Pg. 6
ORIG. LOT 18 AMHERST TWP.
AMHERST CITY
LORAIN COUNTY OHIO
SCALE: 1" = 30' AUG. 21-1968 10:30 A.M.
Gary E. Penfound REG. SURVEYOR

Paul D. & Genevieve M. Gray
Parcel No. 2