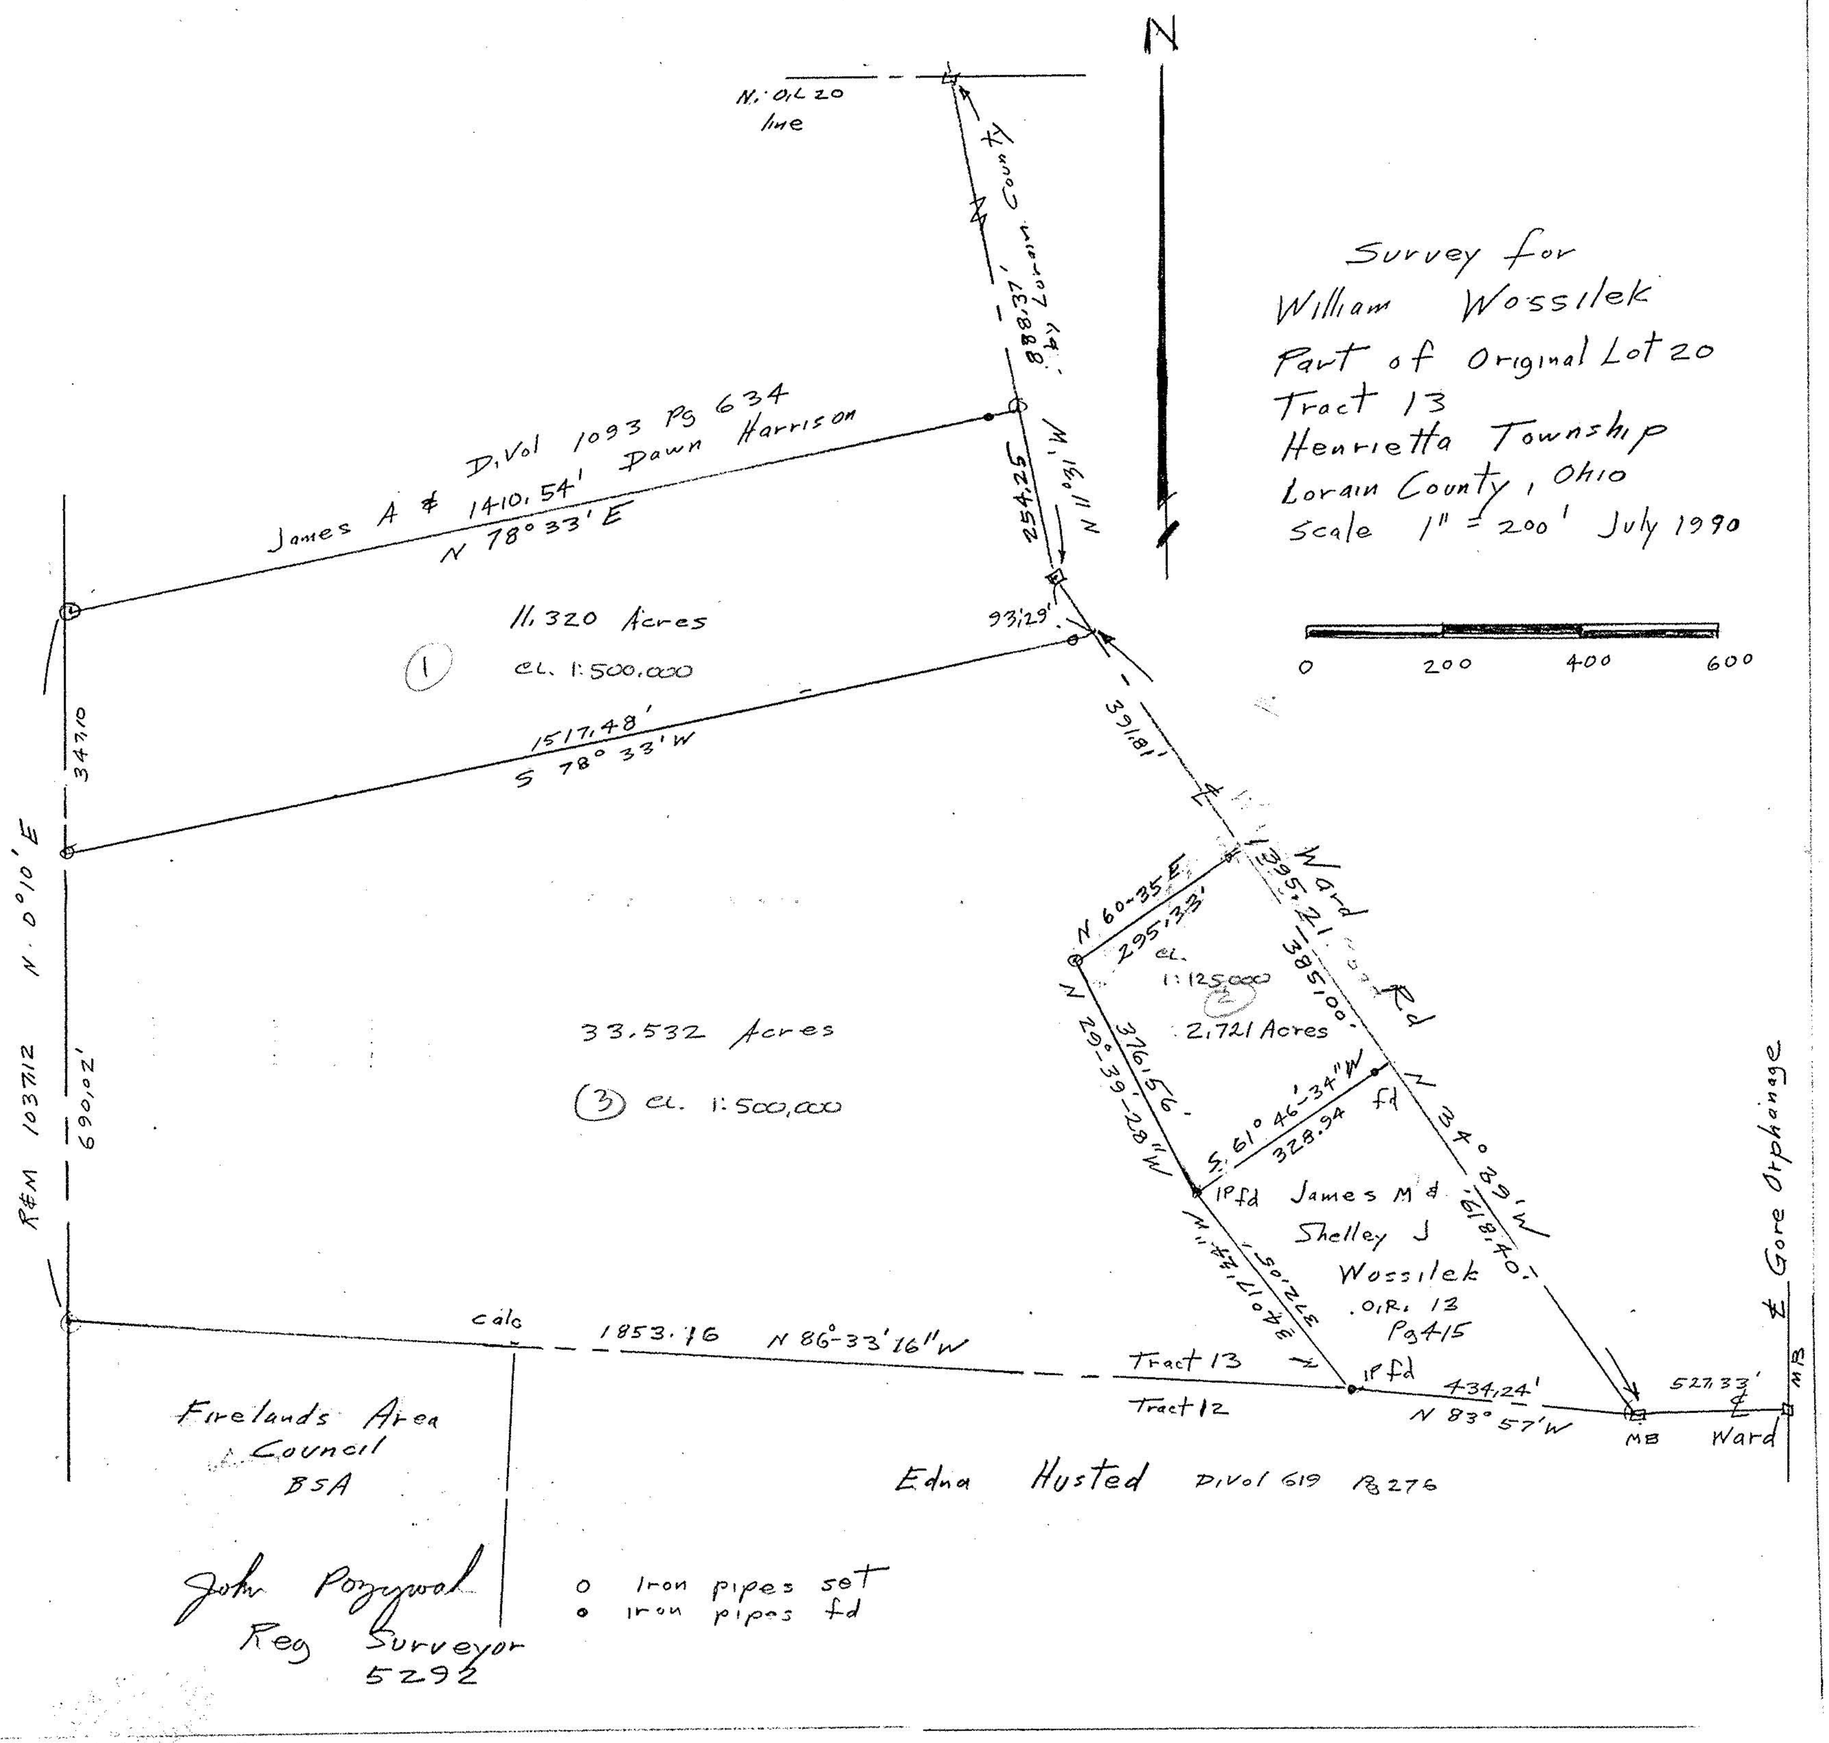

Survey for
William Wossilek
Part of Original Lot 20
Tract 13
Henrietta Township
Lorain County, Ohio
Scale 1" = 200' July 1990

9-13-90 #19126 Ck

#19100-A

APPROVED
LORAIN CO.
MAP DEPT.
DATE 8-30-90
PAGE 8-E
BY C.E. FRANCIS
VOID AFTER 19100-A