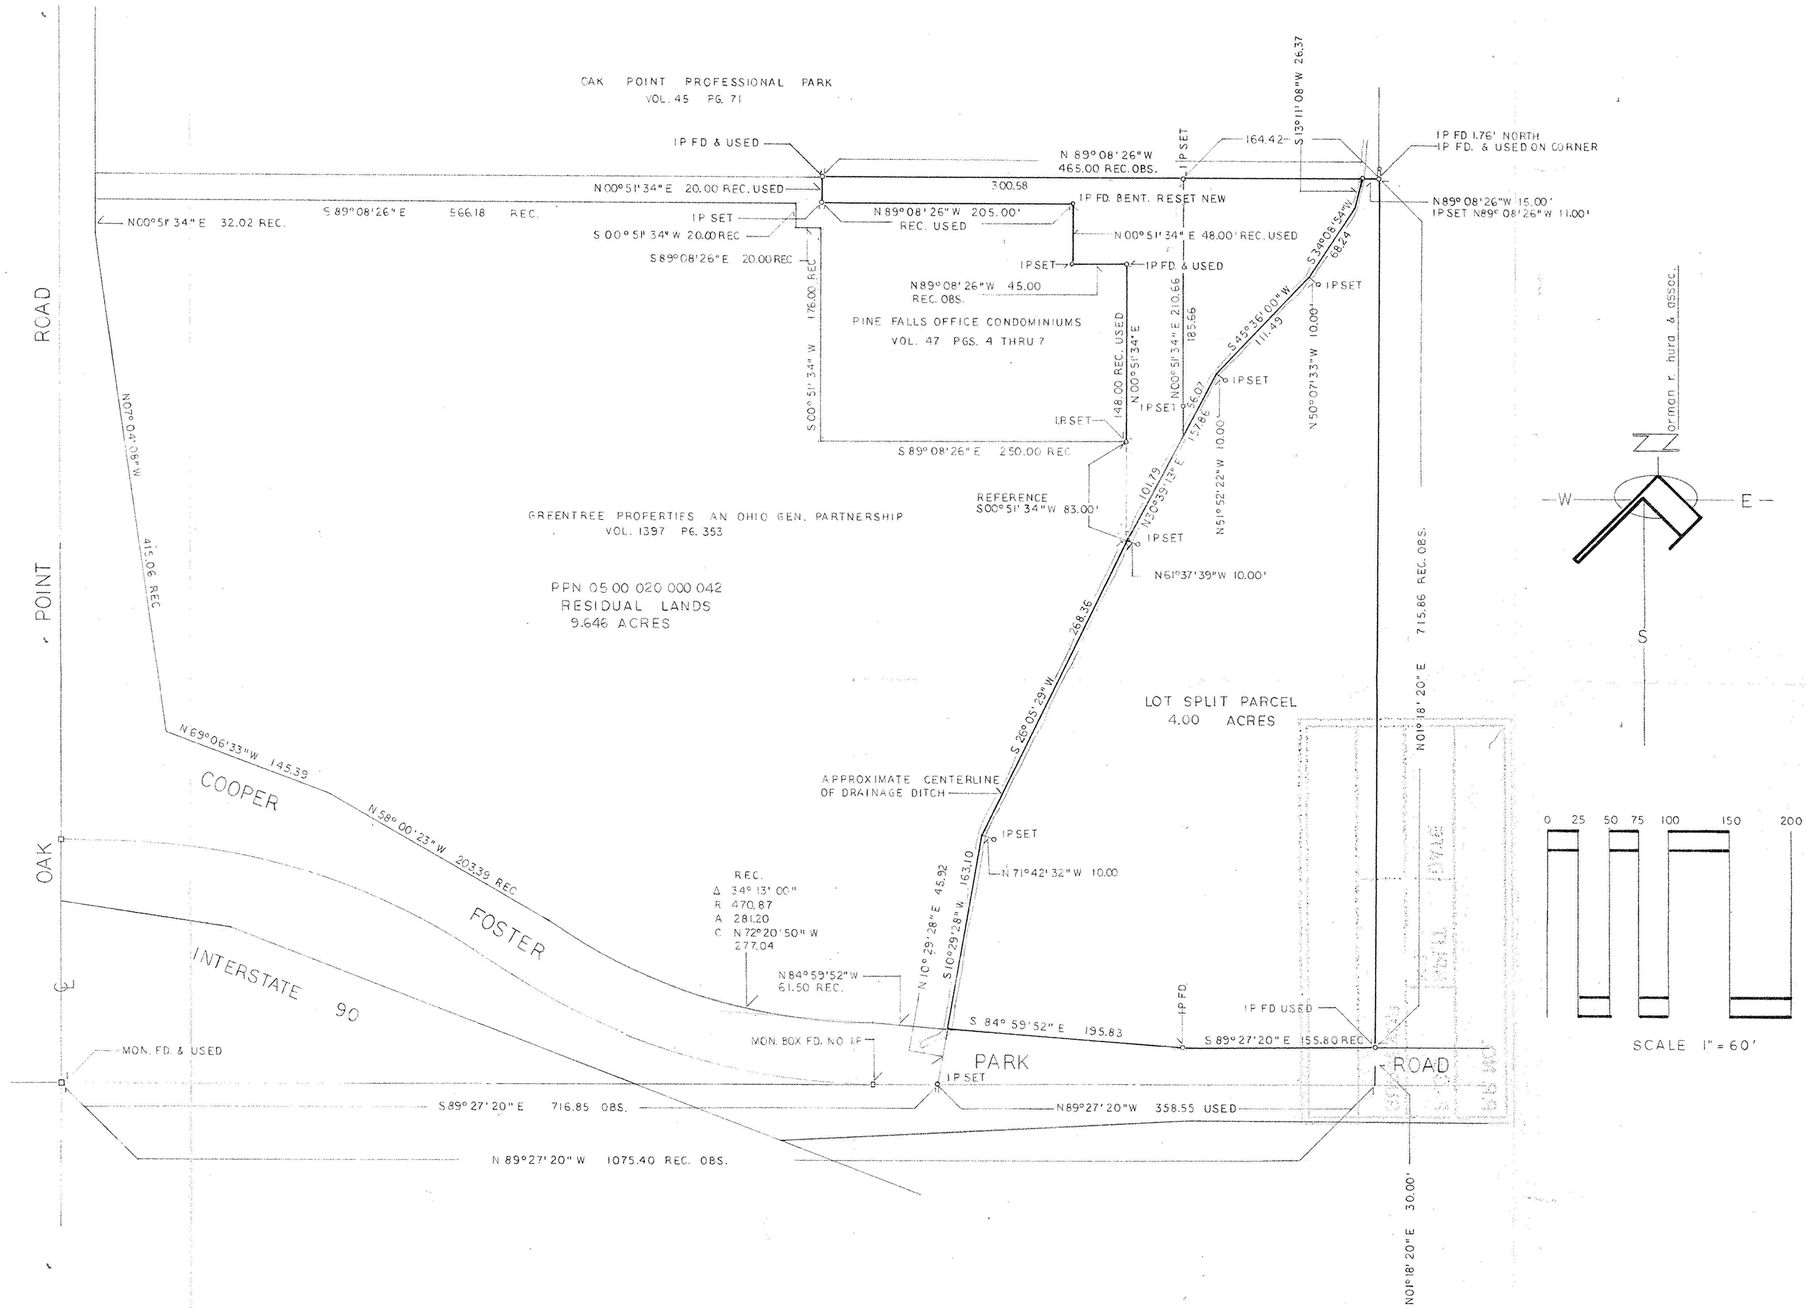

REVISED MAY 12 1996
REVISED APRIL 20 1996

STATE OF OHIO
N. R. HURA
S-5208
REGISTERED PROFESSIONAL SURVEYOR

PART OF ORIGINAL AMHERST TOWNSHIP LOT NO. 20
CITY OF LORAIN — LORAIN COUNTY—OHIO

APRIL 1996

PLAT OF LOT SPLIT

GREENTREE PROPERTIES
AN OHIO CORPORATION

21891
APPROVED
LORAIN CO.
MAP DEPT.
DATE 8-16-96
PAGE 5-00-020-A
BY K.DYE
VOID AFTER 21891

APPROVED BY THE LORAIN CITY PLANNING COMMISSION..... NO PLAT REQUIRED
William E. Ade AUG 23 1996
SECRETARY LORAIN CITY PLANNING COMMISSION

APPROVED
AS TO DESCRIPTION ONLY
Date Aug. 6, 1996
Per Patrick B. McGlynn City of Lorain Engineering Dept.