


5-00-023-B


5-00-023-105

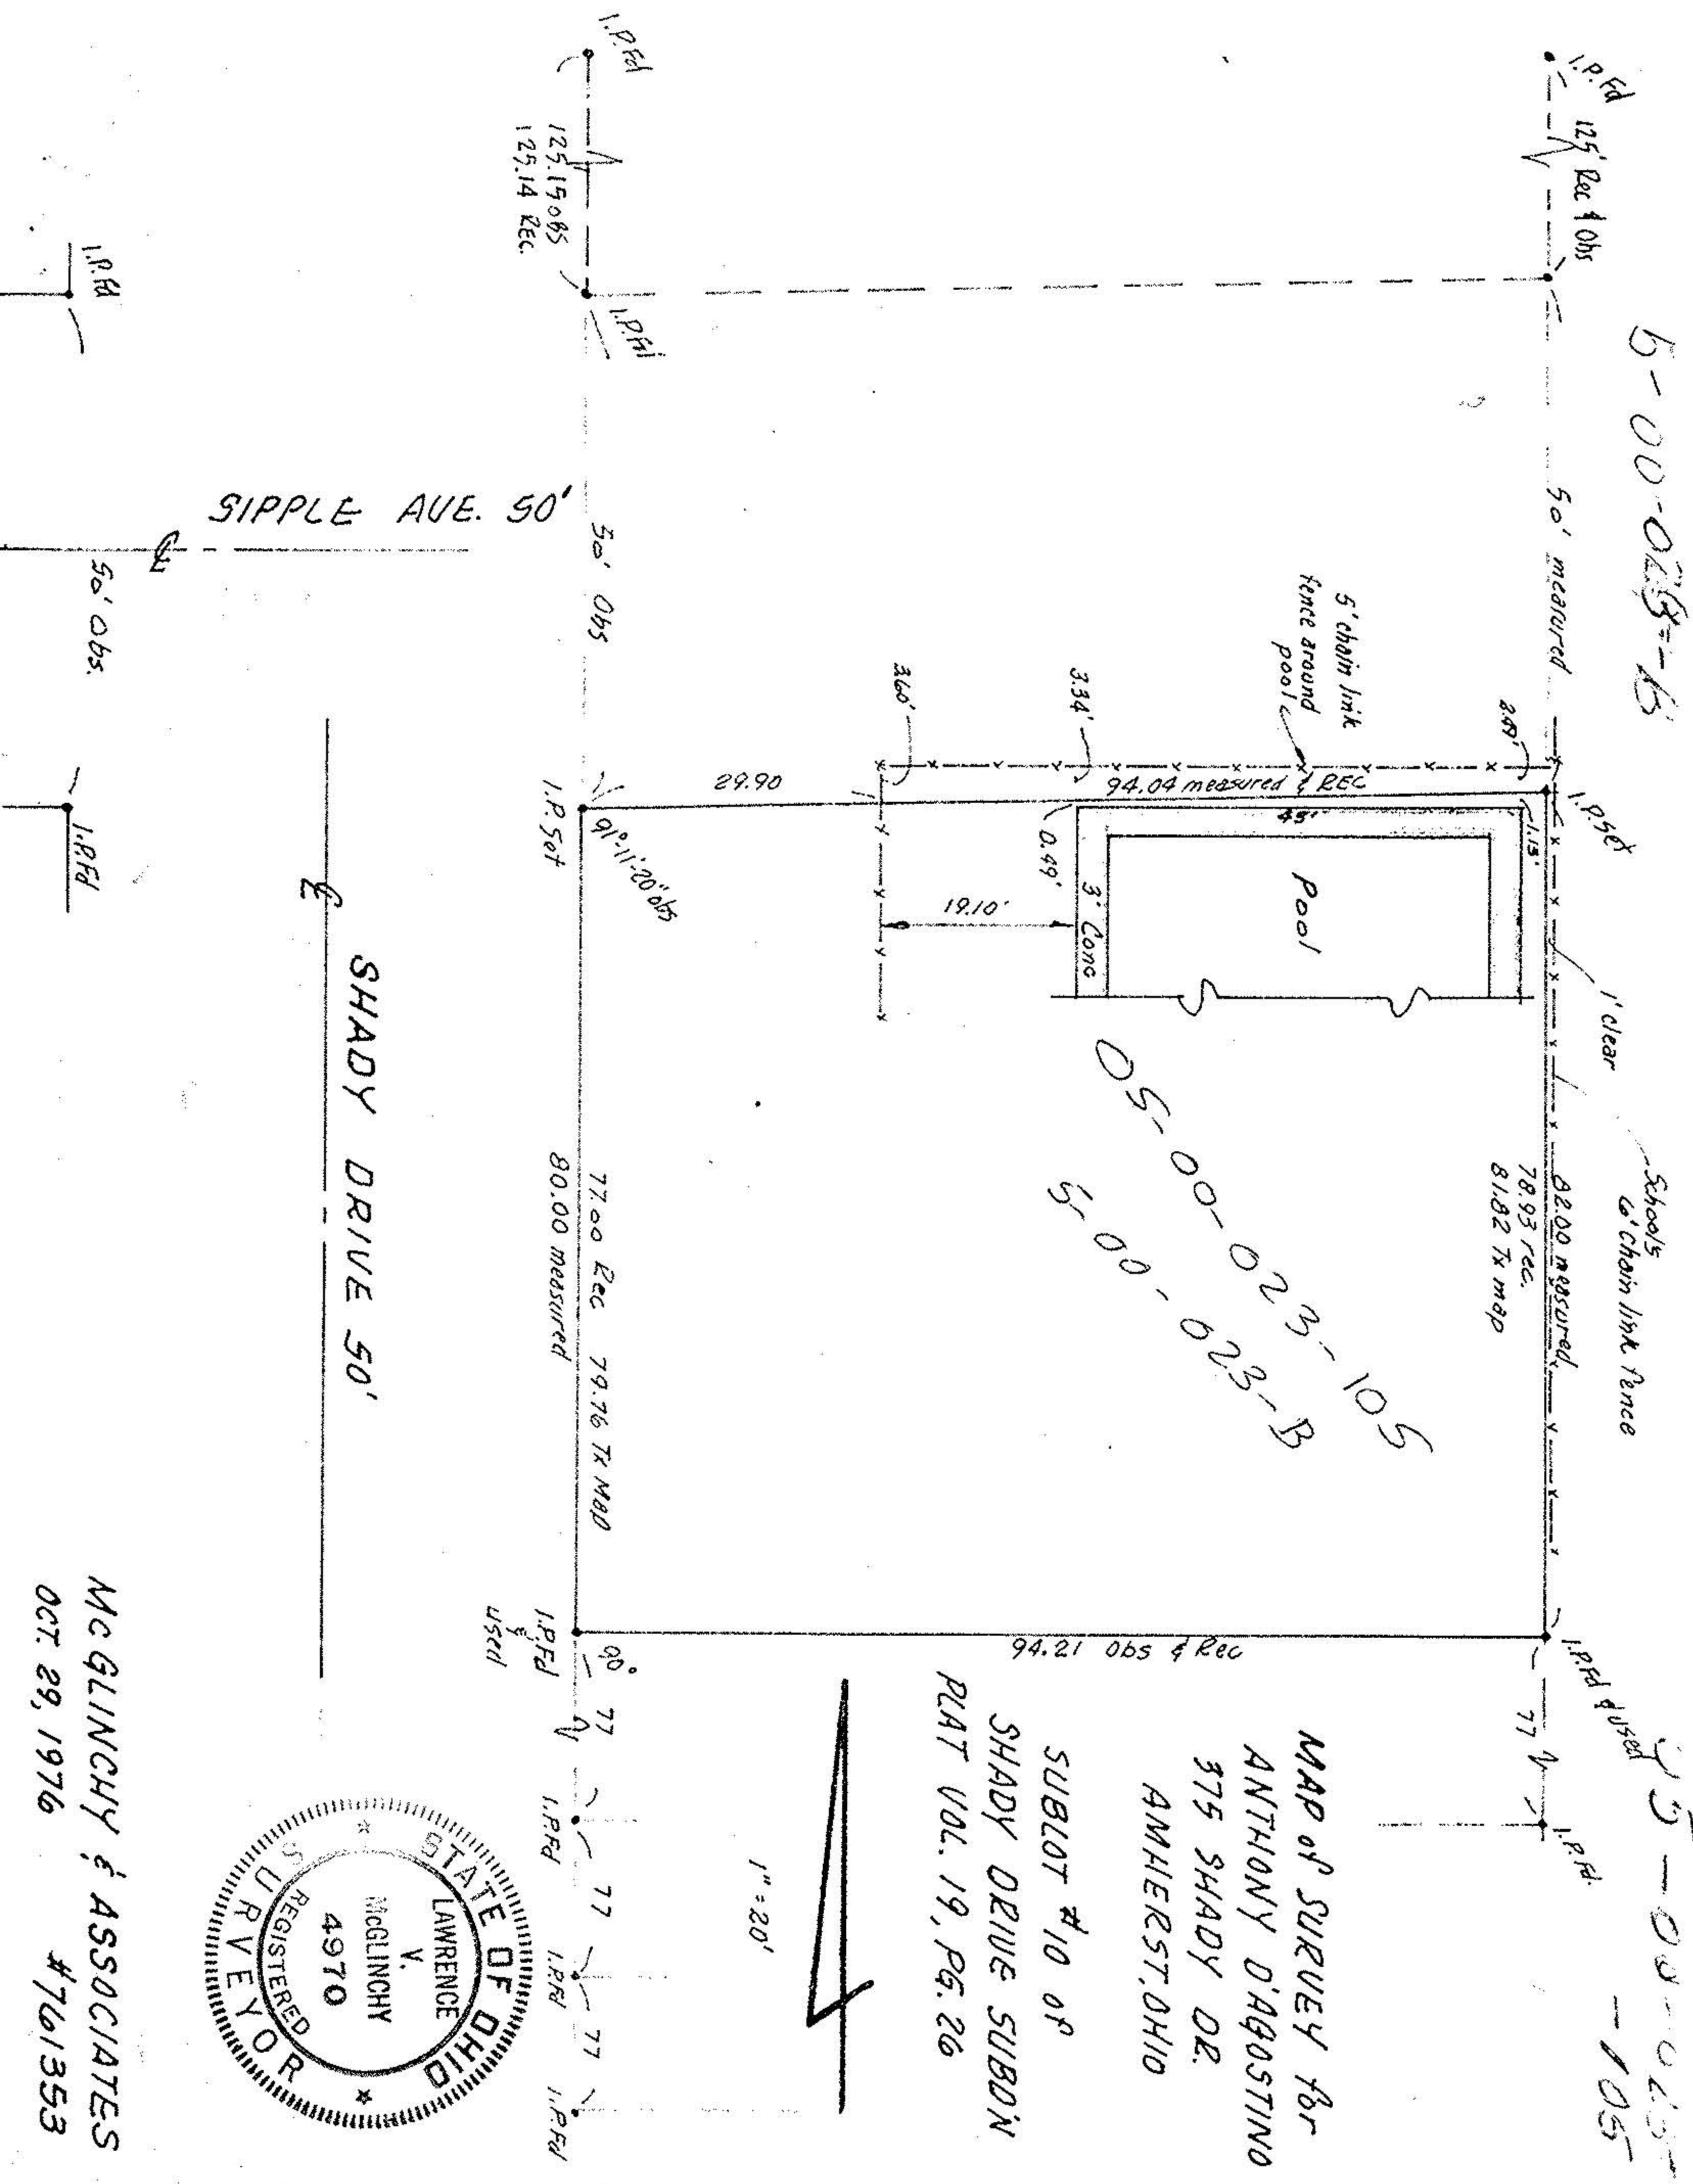

MAP OF SURVEY FOR
 ANTHONY DIAGOSTINO
 375 SHADY DR.
 AMHERST, OHIO

SUBLOT #10 OF
 SHADY DRIVE SUBDN
 PLAT VOL. 19, PG. 26

1" = 20'

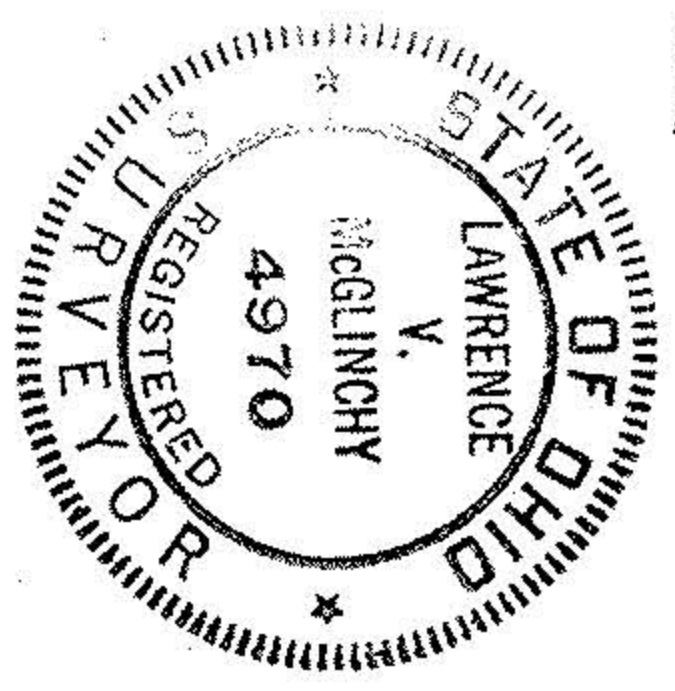

McGLINCHY & ASSOCIATES
 OCT. 29, 1976 #761353