

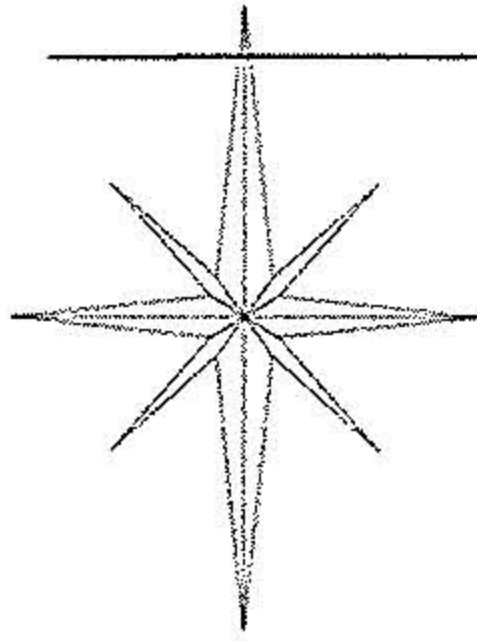


Earl H. Hunter
 Feb 12 / Hunter
 F No. 19, 1996

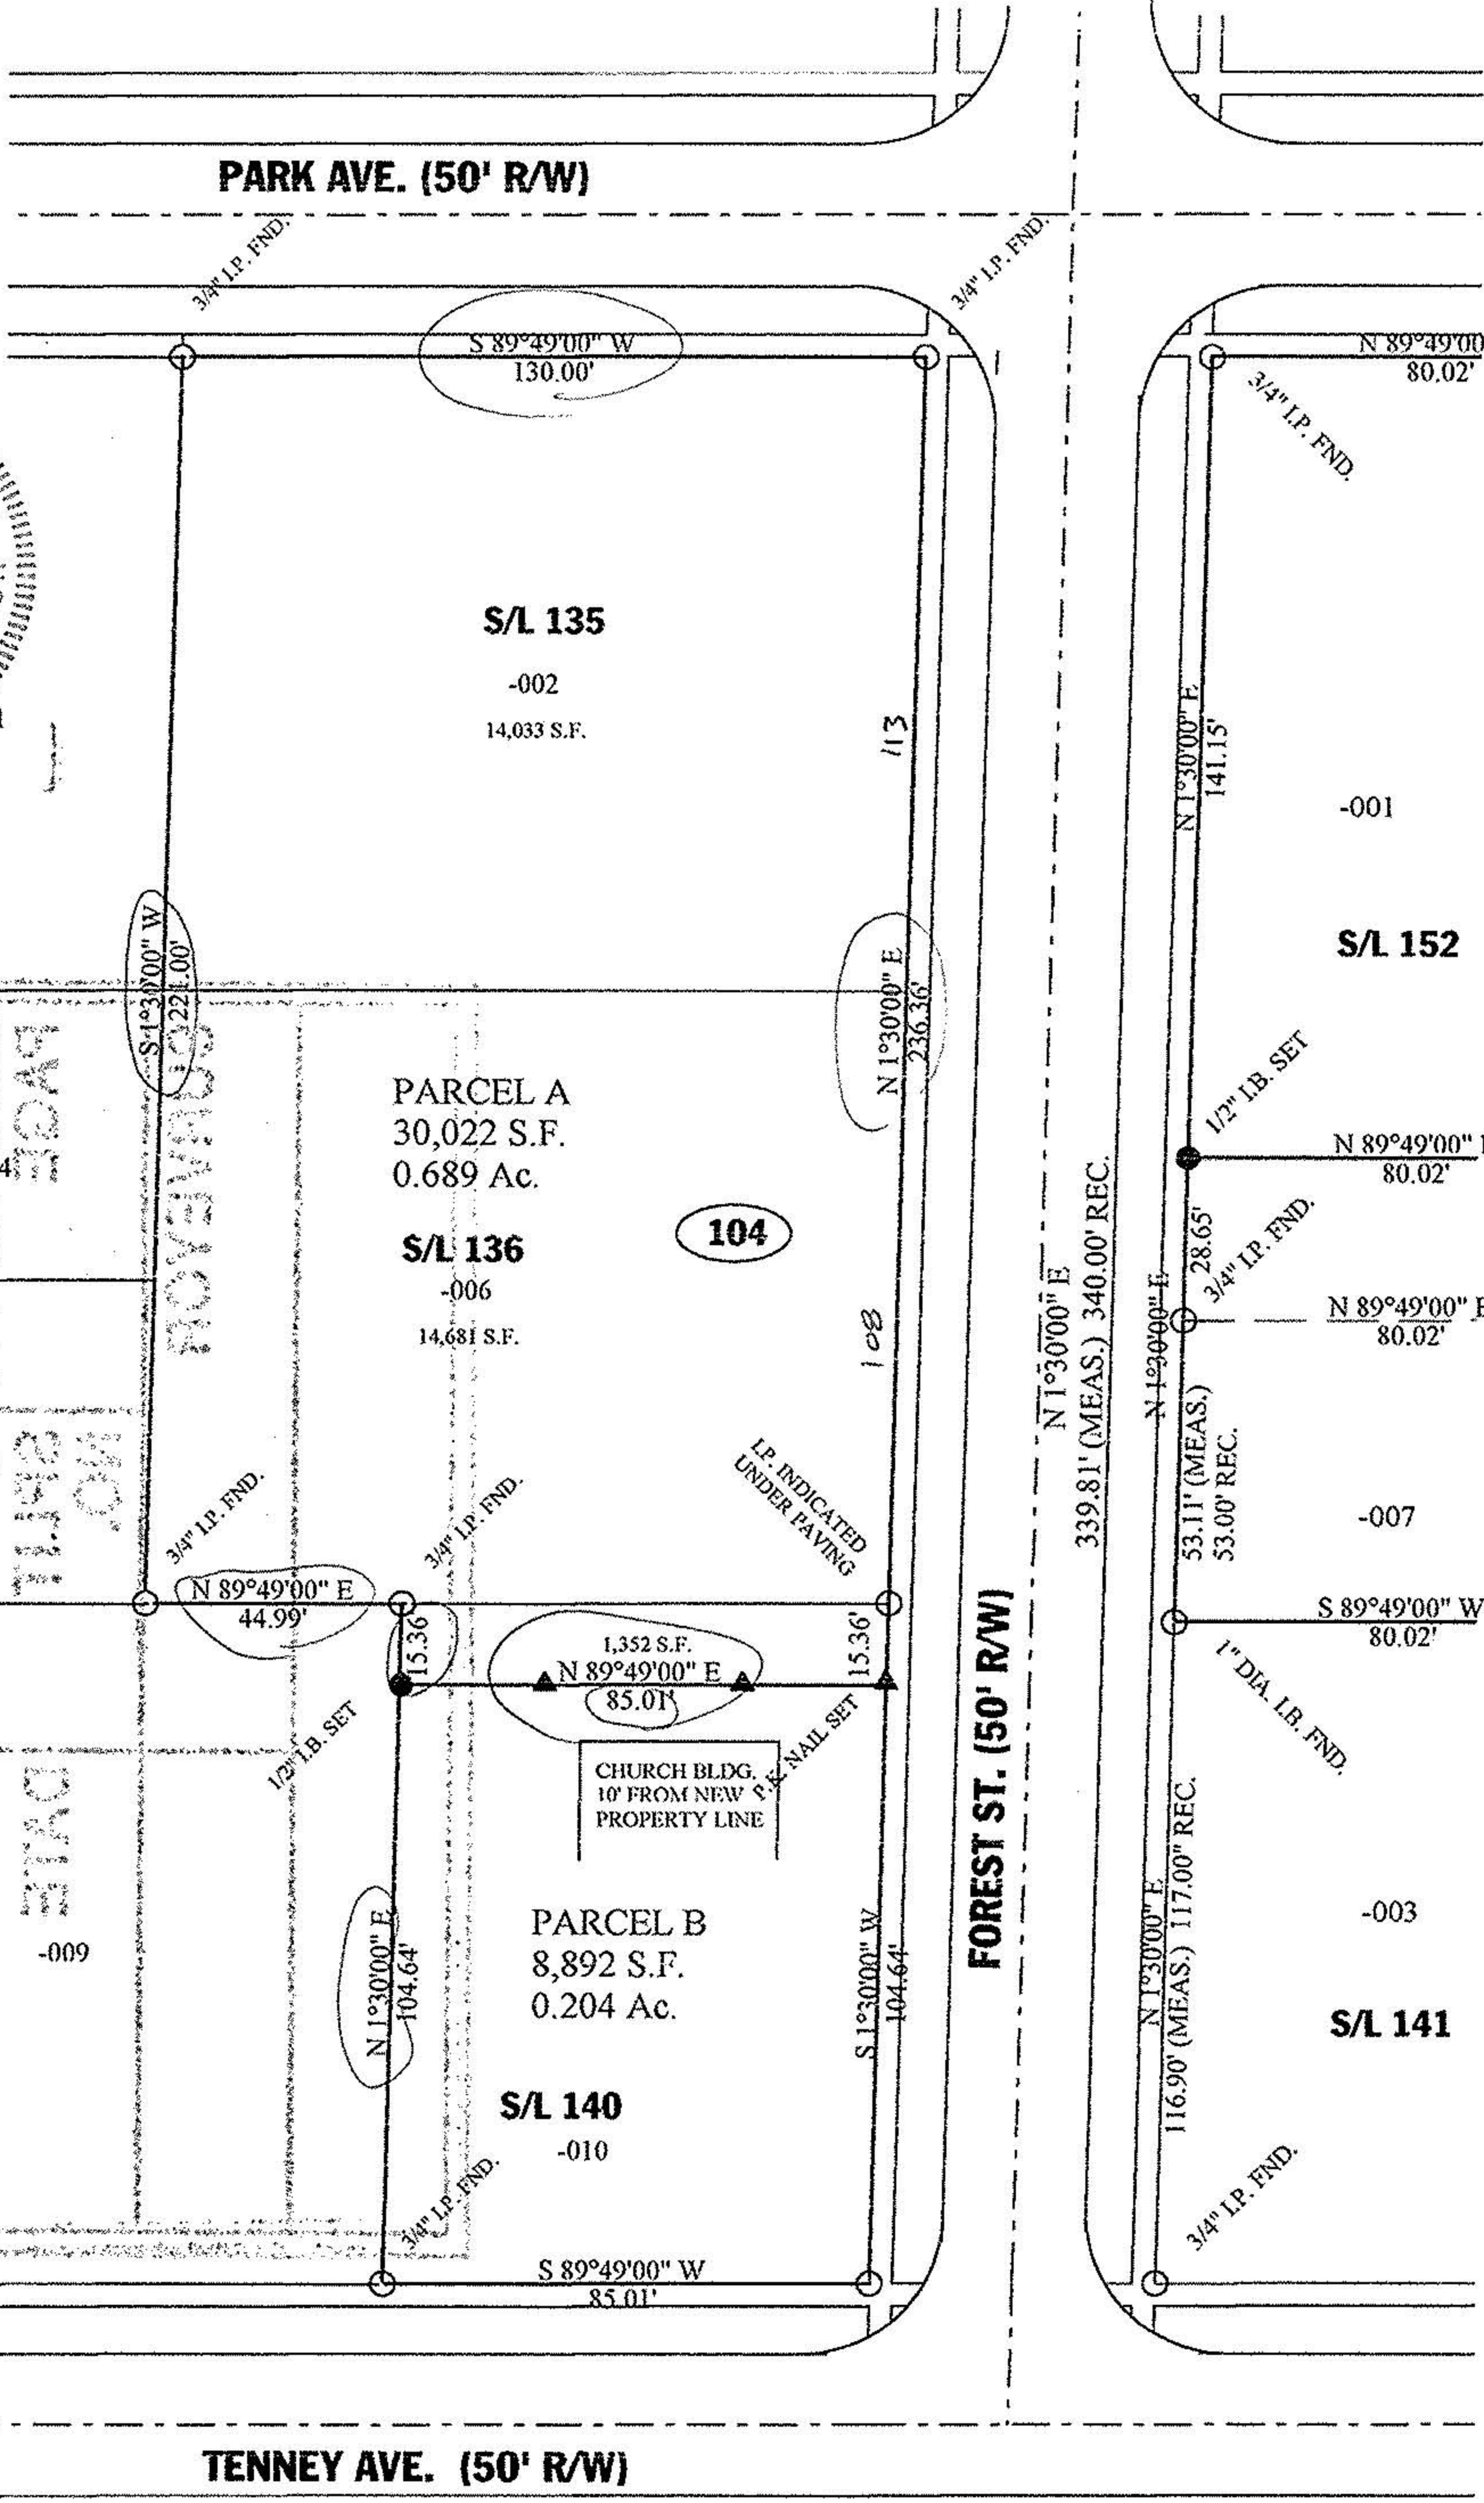

PLAT OF SURVEY FOR
SAN SPRING CO.
 TENNEY AVE.
 &
 FOREST ST.
 CITY OF AMHERST
 AMHERST TOWNSHIP
 LORAIN COUNTY, OHIO

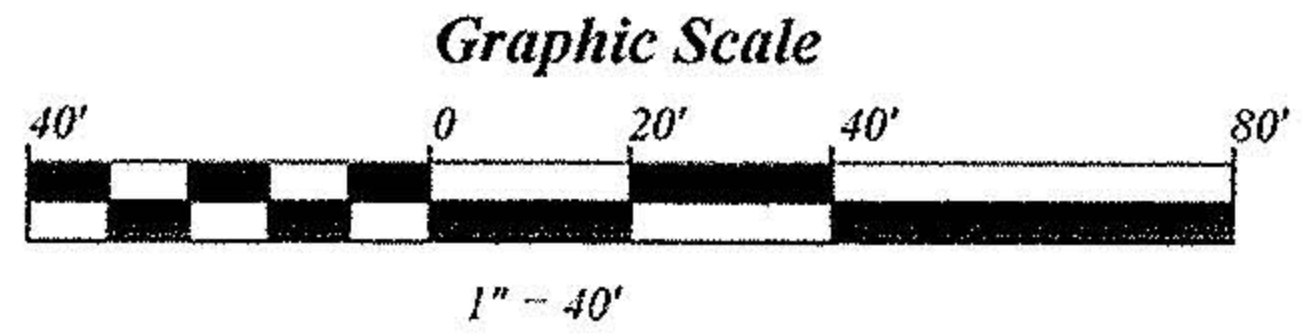

EARL H. HUNTER, P.S.
 1503 SANFORD ST.
 VERMILION, OHIO 44089
 (216) 967-2037