5-00-023-B
5-8-78
D. Johnson
11628

05-00-023-B

Map of Part of Sublot 1 Axtell Homestead Addition Vol. 7 Page 9 .

Scale 1" 50' March 8, 1978

By Arnold F. Koepp Registered Surveyor No. 4306
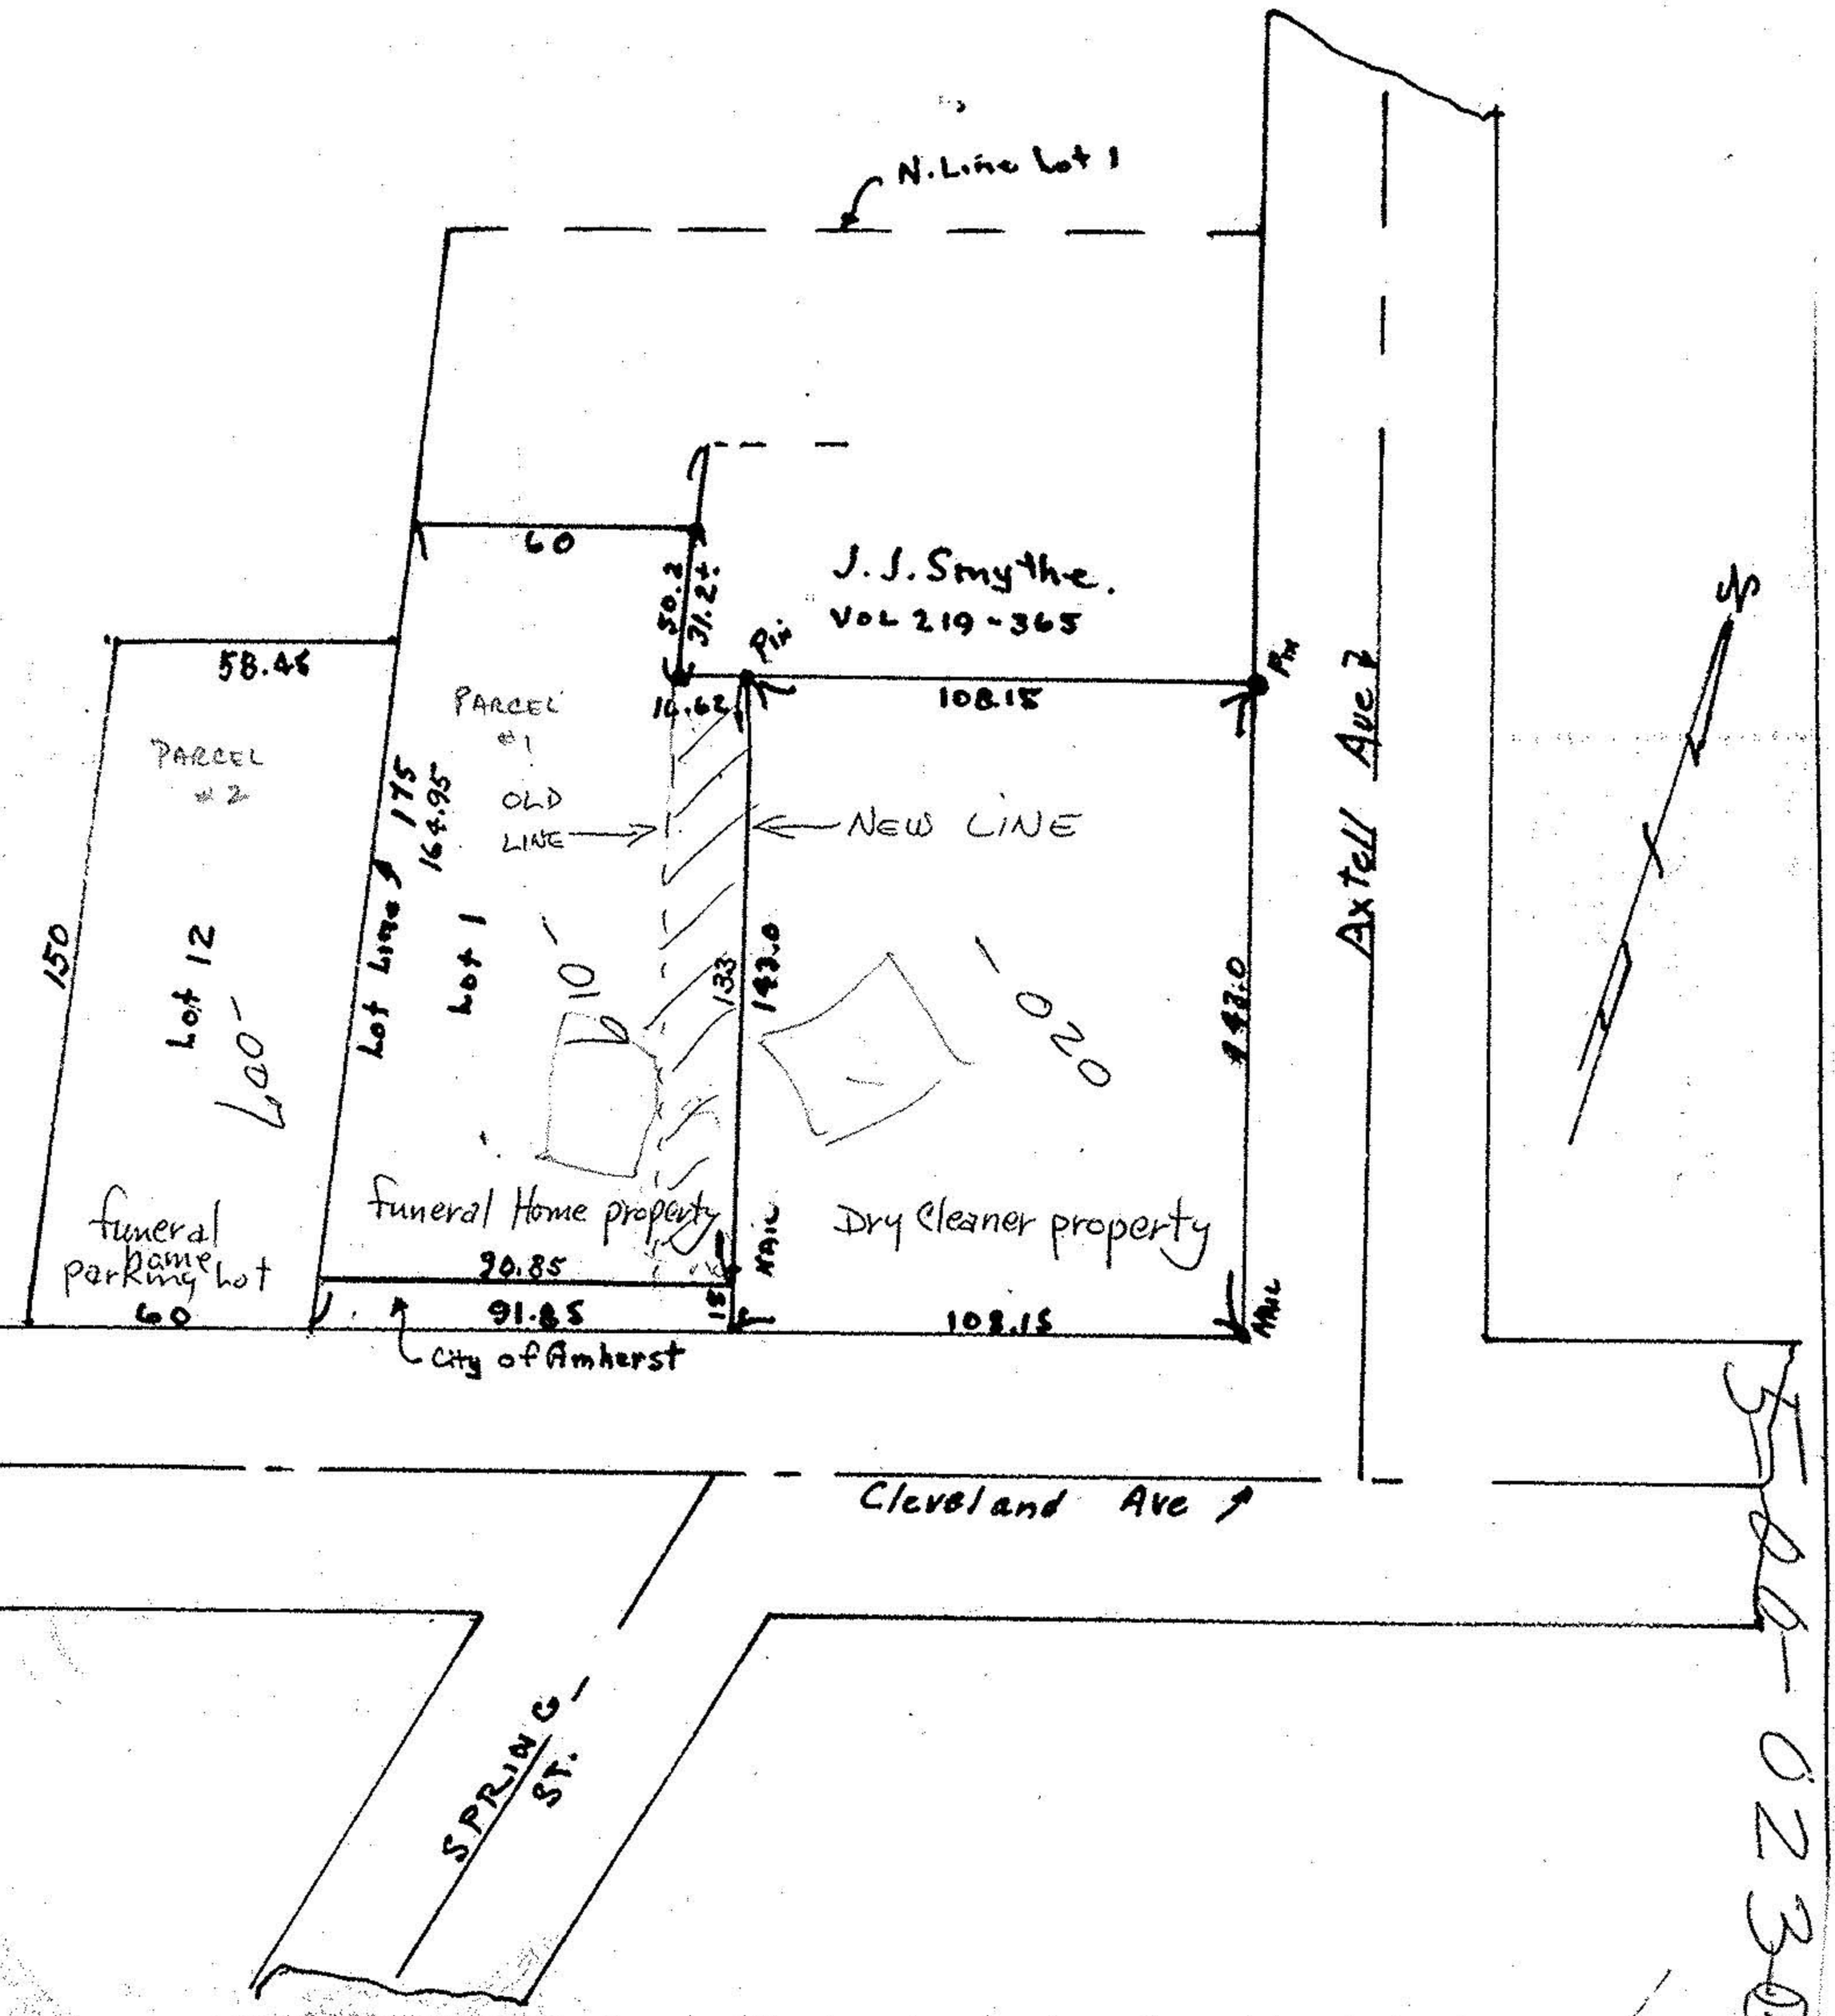
Map revised for 10 foot parcel March 31, 1978