


77

 

**TRANSFERRED**  
IN COMPLIANCE WITH SEC. 315202  
OHIO REV. CODE

MAR 15 1999

MARK R. STEWART  
FORN COUNTY SURVEYOR

12 MAP REC.

RECEIVED FOR RECORD  
MAR 15 1999  
VOL. 42 MARY ANN JAMISON  
PART 277 Lorain County Recorder  
79.00 172.70  
79.00 172.70  
210.80

Box 1579 (LMDA)

**KS ASSOCIATES, INC.**  
ENGINEERS/SURVEYORS  
4425 Main Street  
Elyria, Ohio 44036  
PHONE: (440) 322-6317 • FAX: (440) 284-0623

**THE ENGLISH LAKES CONDOMINIUMS**  
PHASE 20

CITY OF AMHERST \* COUNTY OF LORAIN \* STATE OF OHIO

PART OF AMHERST TOWNSHIP O.L.s 25 & 26

CERTIFICATION  
THIS IS TO CERTIFY THAT THE ATTACHED DRAWINGS CORRECTLY REPRESENT THE BUILDINGS AS CONSTRUCTED AND THAT THERE ARE NO ENCROACHMENTS ON ADJUTING PROPERTIES.

DAVID L. ELWELL  
REG. SURVEYOR NO. 6333

LYNN S. MIGGINS  
REG. ENGINEER NO. 46837

NOTE: AREA OF BASEMENTS ARE NOT USED IN DETERMINING CONDOMINIUM OWNERSHIP.

TOTAL AREA PHASE 20 = 0.2487  
TOTAL AREA REMAINDER = 4.8478 AC.

REVISIONS

DATE	BY	DESCRIPTION
1-8-99	AMK	
3-10-99	DLK	ADDED UNIT NUMBERS TO FOUNDATION PLAN
1-8-99	DLK	ORIGINAL ISSUE

AREA MAP

NO SCALE

REVISIONS

DATE: 1-8-99  
DRAWN BY: AMK  
CHKD BY: DLK  
F.B.  
DIVS. NAME: R.100224-200-2000








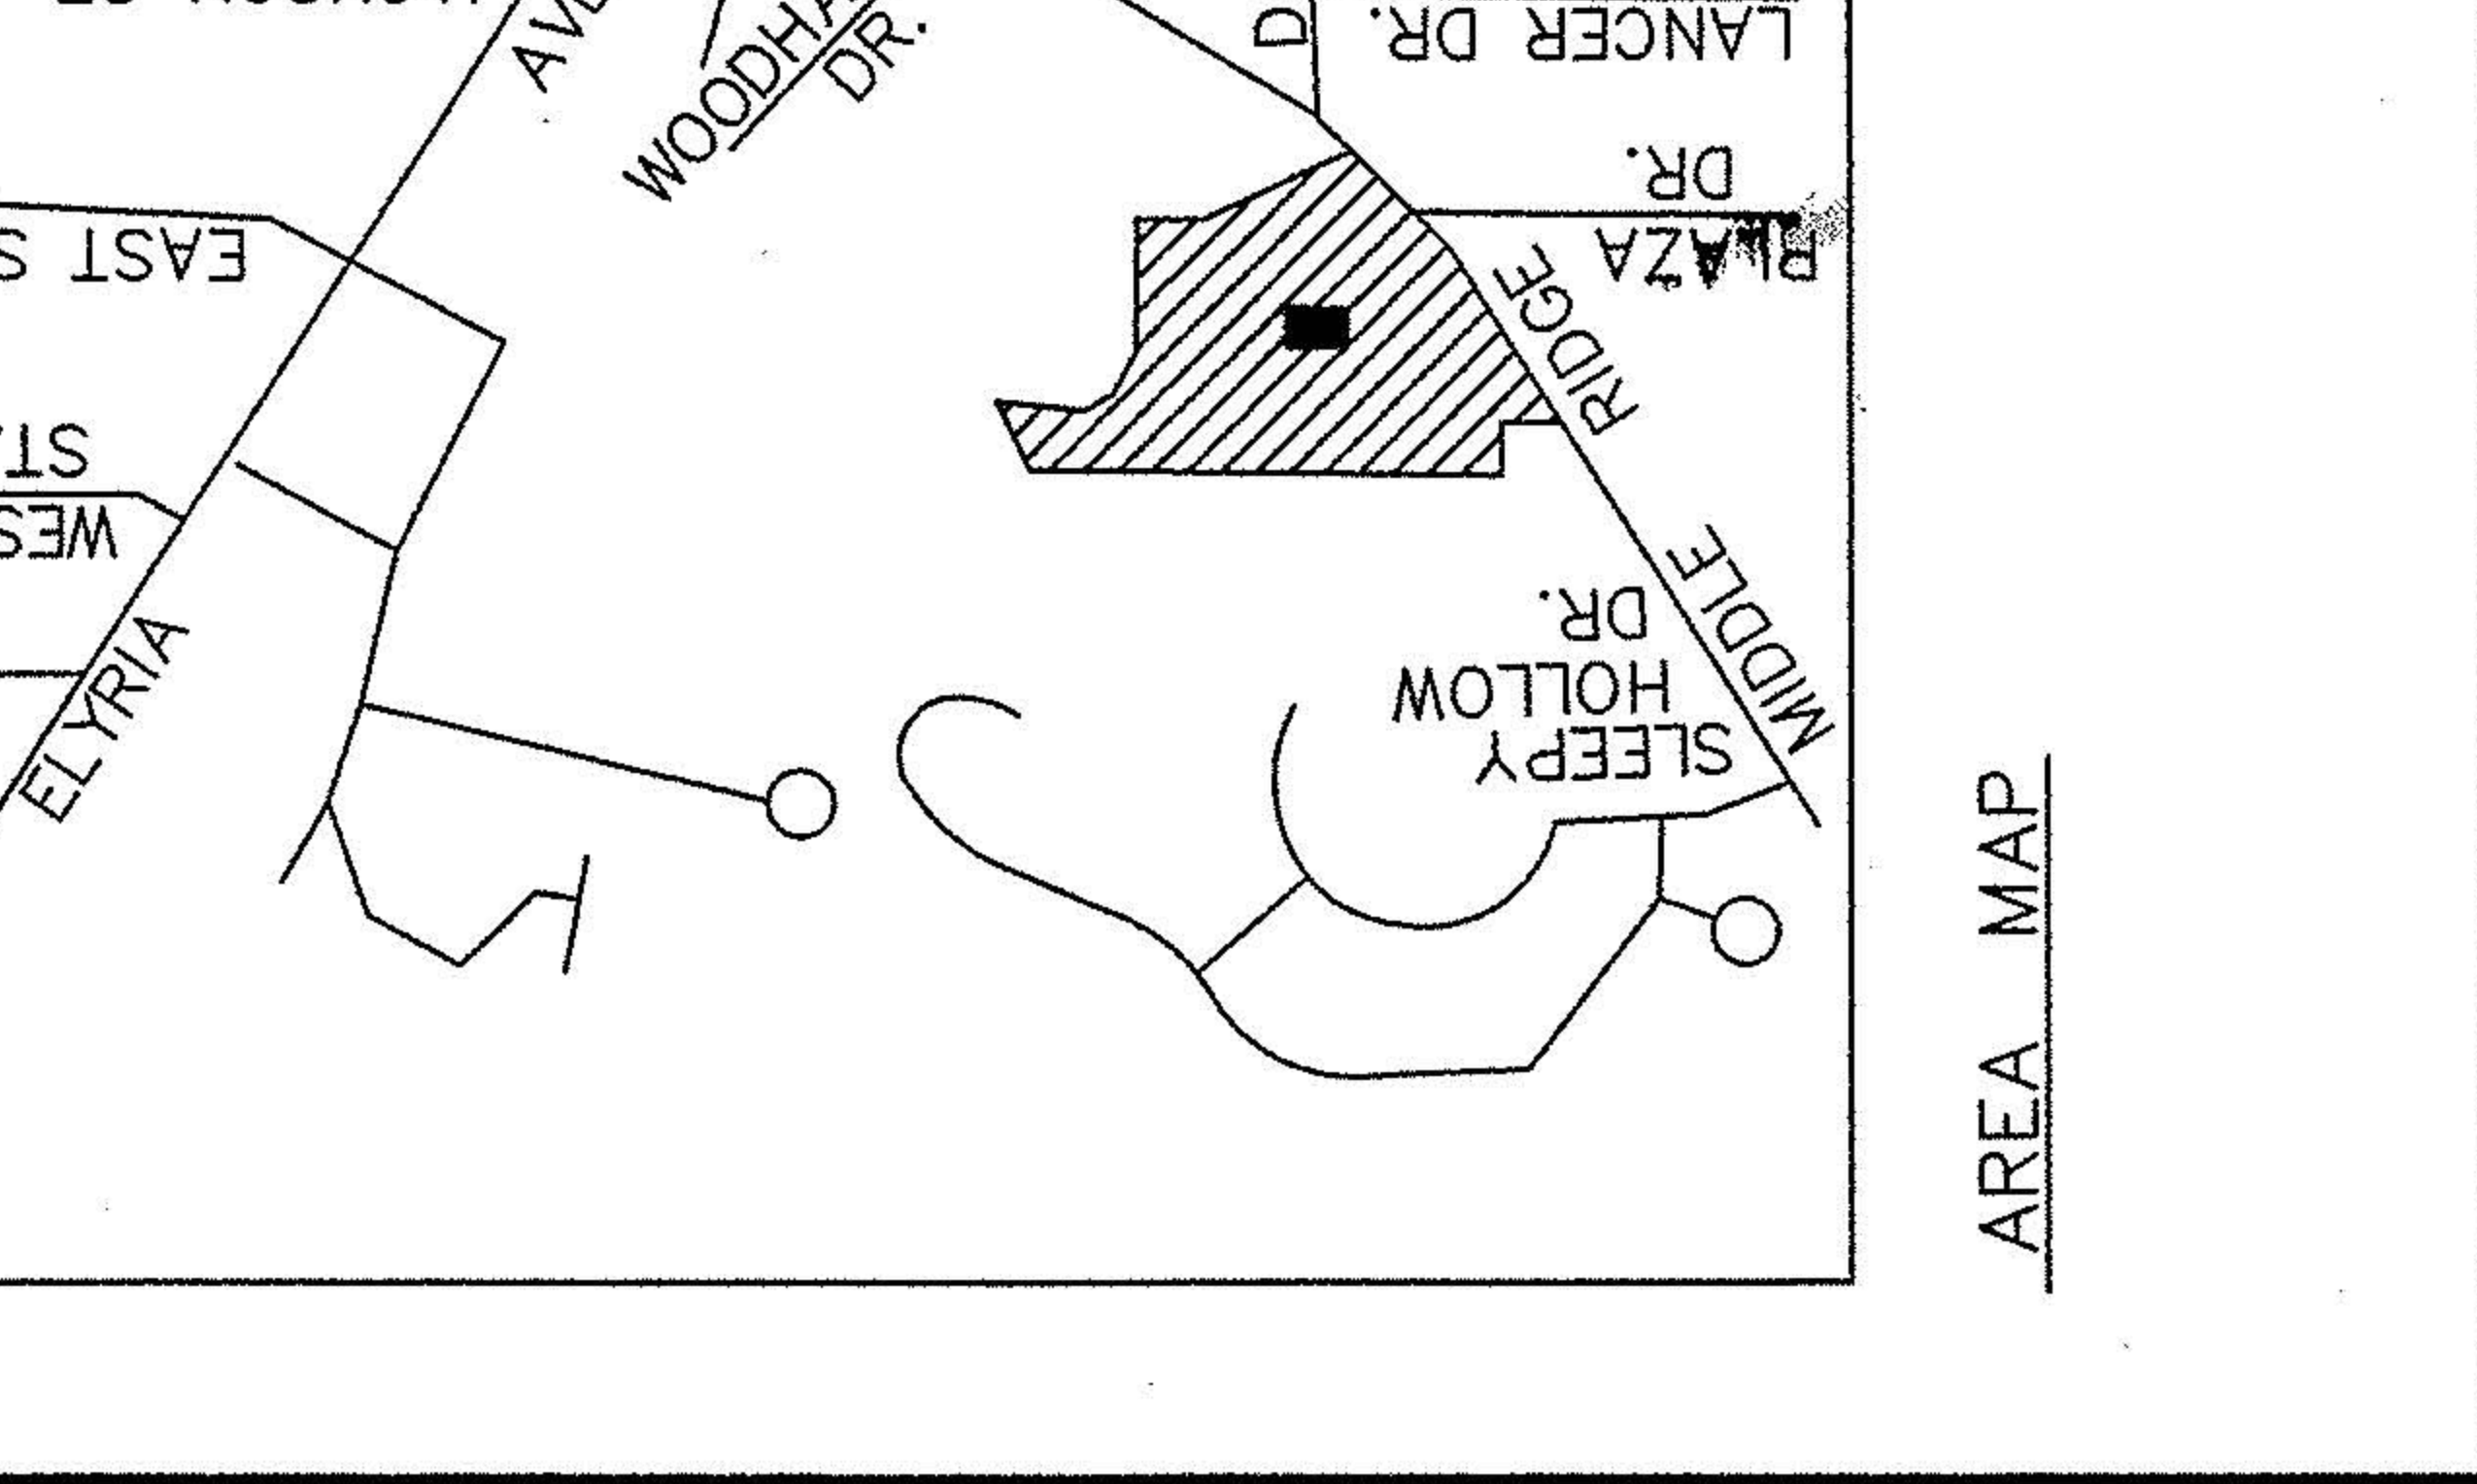


