

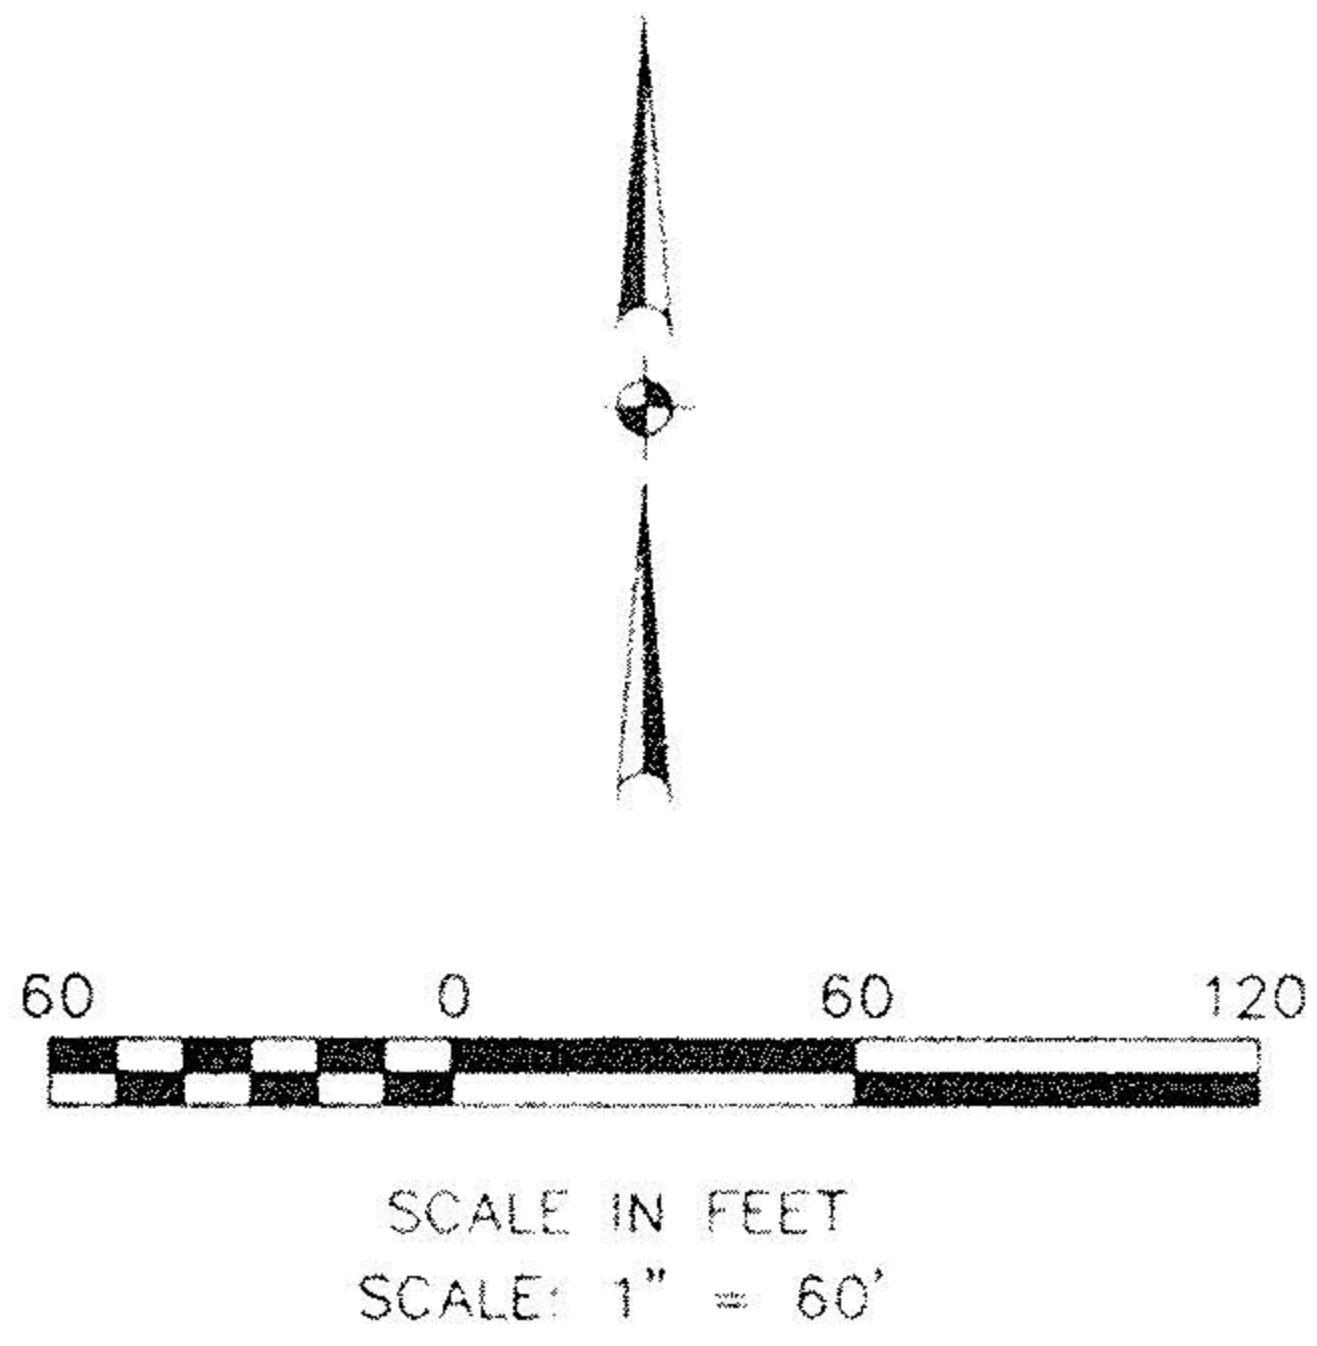


SURVEY AND SPLIT MAP

OF PART OF
ORIGINAL AMHERST TOWNSHIP LOT NO. 26
CITY OF AMHERST COUNTY OF LORAIN
STATE OF OHIO
JUNE 3, 1998

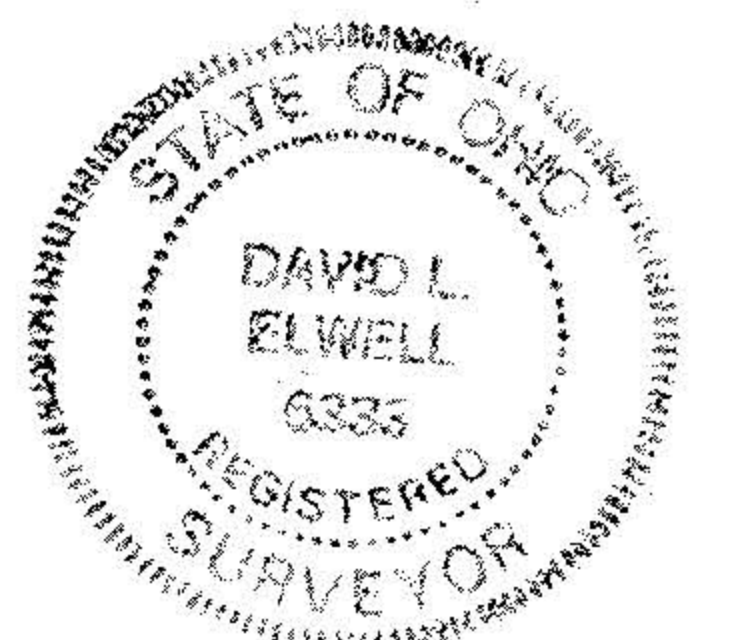

- ⊙ IRON PIPE FOUND
- 5/8" KS CAPPED IRON PIN SET

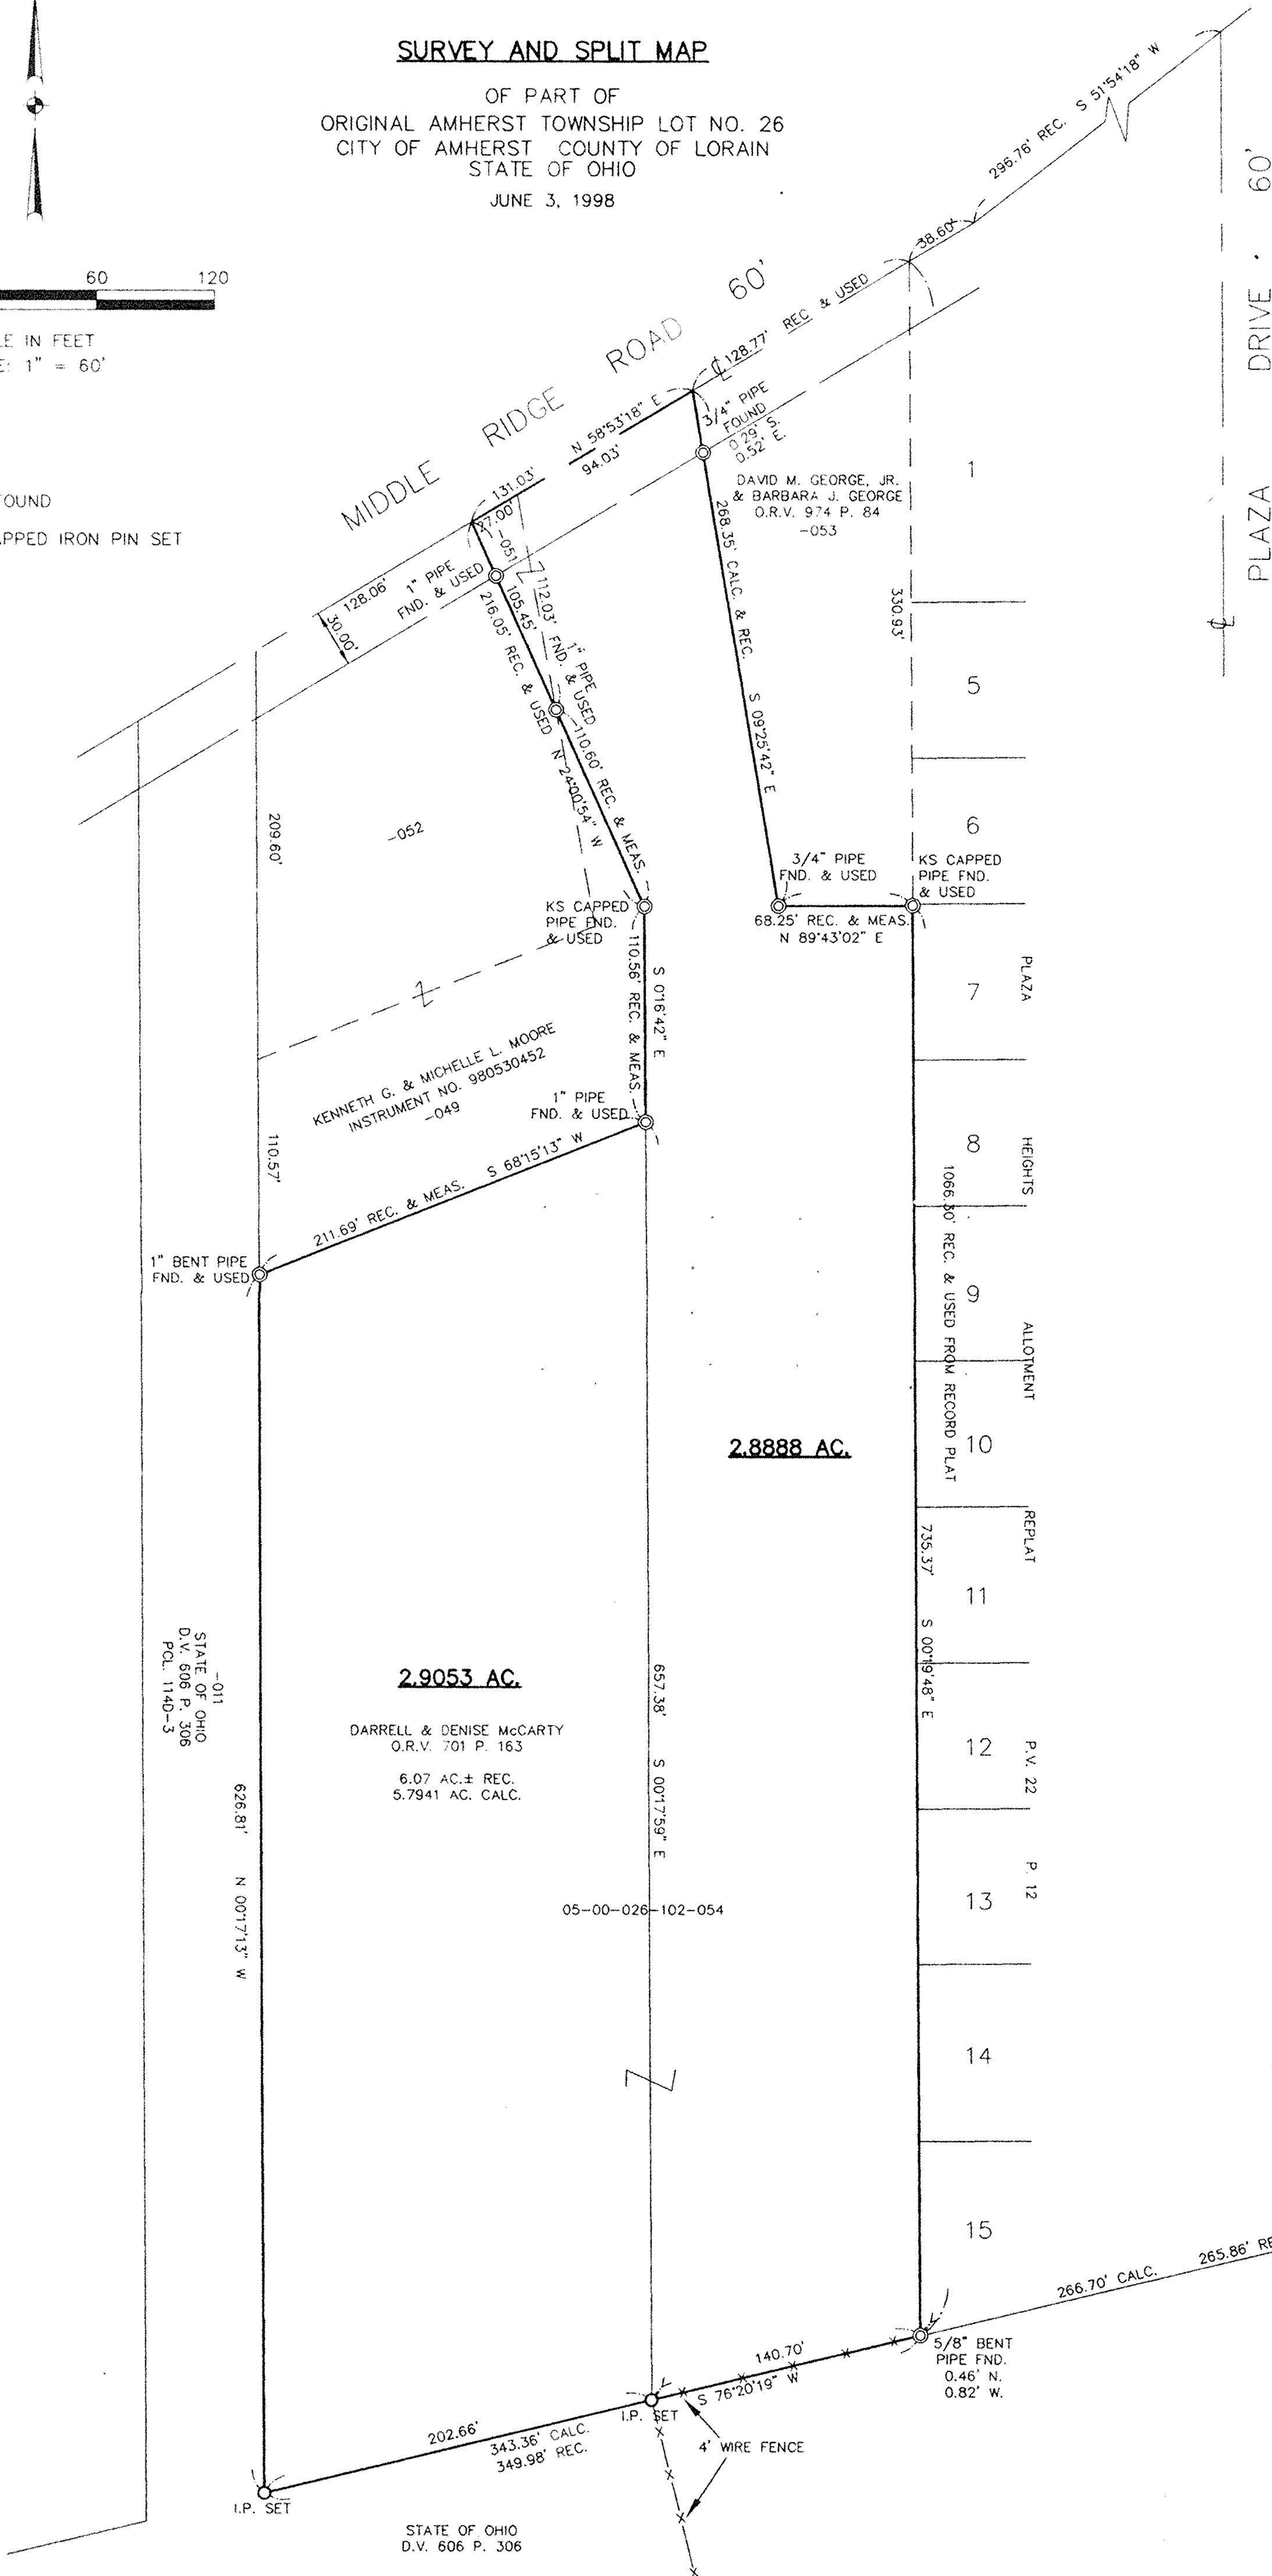

David L. Elwell
DAVID L. ELWELL, REG. SURVEYOR NO. 6333

#22625

APPROVED
LORAIN CO. MAP DEPT.
DATE 8-28-98
PAGE 5-00-026-B
BY TJS
WORD 22625

