MAP OF SURVEY

FOR

THE OHIO TURNPIKE COMMISSION

PARCEL ACQUISITION FROM KENNETH G & M. MOORE

SITUATED IN THE CITY OF AMHERST, COUNTY OF LORAIN, AND STATE OF OHIO
ANDKNOWN AS BEING PART OF ORIGINAL AMHERST TOWNSHIP LOT NO. 26

IRON PIN MONUMENTS WERE FOUND OR SET AS SHOWN HEREON.
ALL DIMENSIONS ARE EXPRESSED IN FEET AND DECIMAL PARTS.
BEARINGS ARE TO AN ASSUMED MERIDIAN AND ARE USED TO
SHOW ANGLES ONLY. I DECLARE THIS TO BE A TRUE RETURN OF
A FIELD SURVEY BY ME CORRECT TO THE BEST OF MY ABILITY AND BELIEF.

Western Reserve Engineering
and Surveying Company
5605 Valley Belt Road, Independence, Ohio 44131 (216) 398-6400

WILLIAM J. VONDRA
PROFESSIONAL SURVEYOR NO. 5849

STATE OF OHIO
WILLIAM J. VONDRA
5849
REGISTERED
PROFESSIONAL SURVEYOR

GRAPHIC SCALE
(IN FEET)
1 inch = 60 ft.

00661
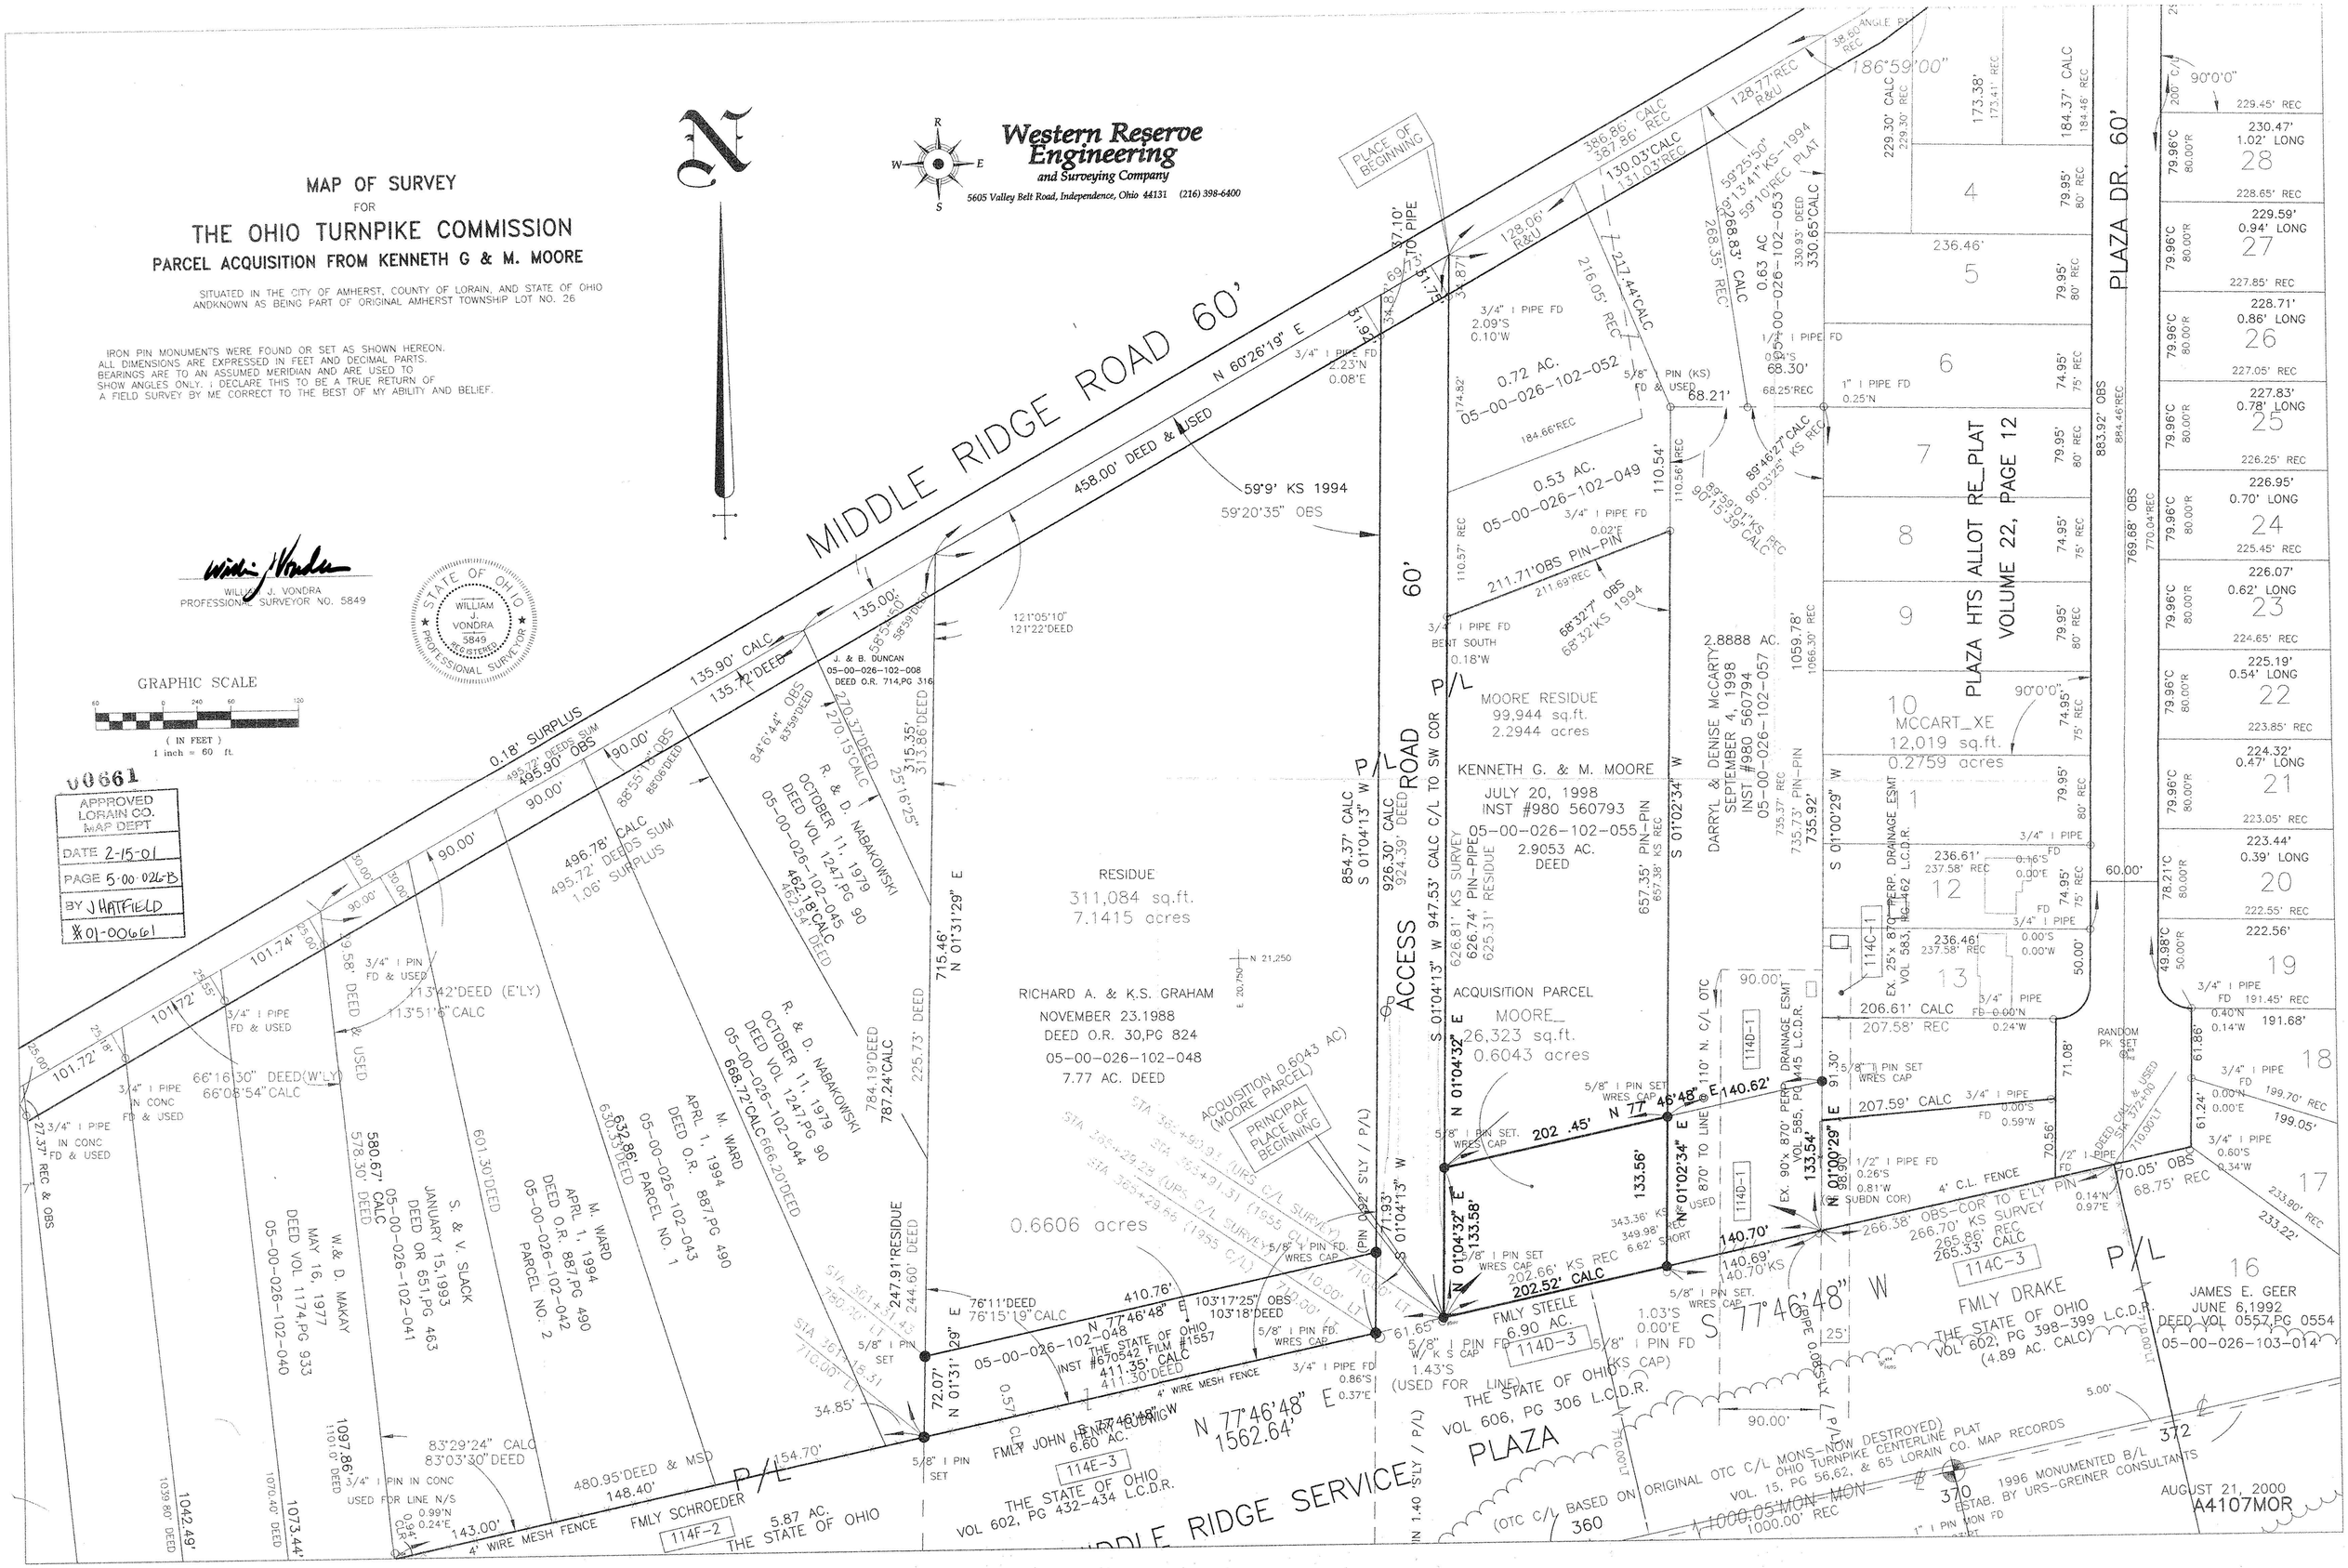
APPROVED
LORAIN CO.
MAP DEPT
DATE 2-15-01
PAGE 5-00-026B
BY J HATFIELD
#01-00661