



BUCHANAN  
744-585 & 587

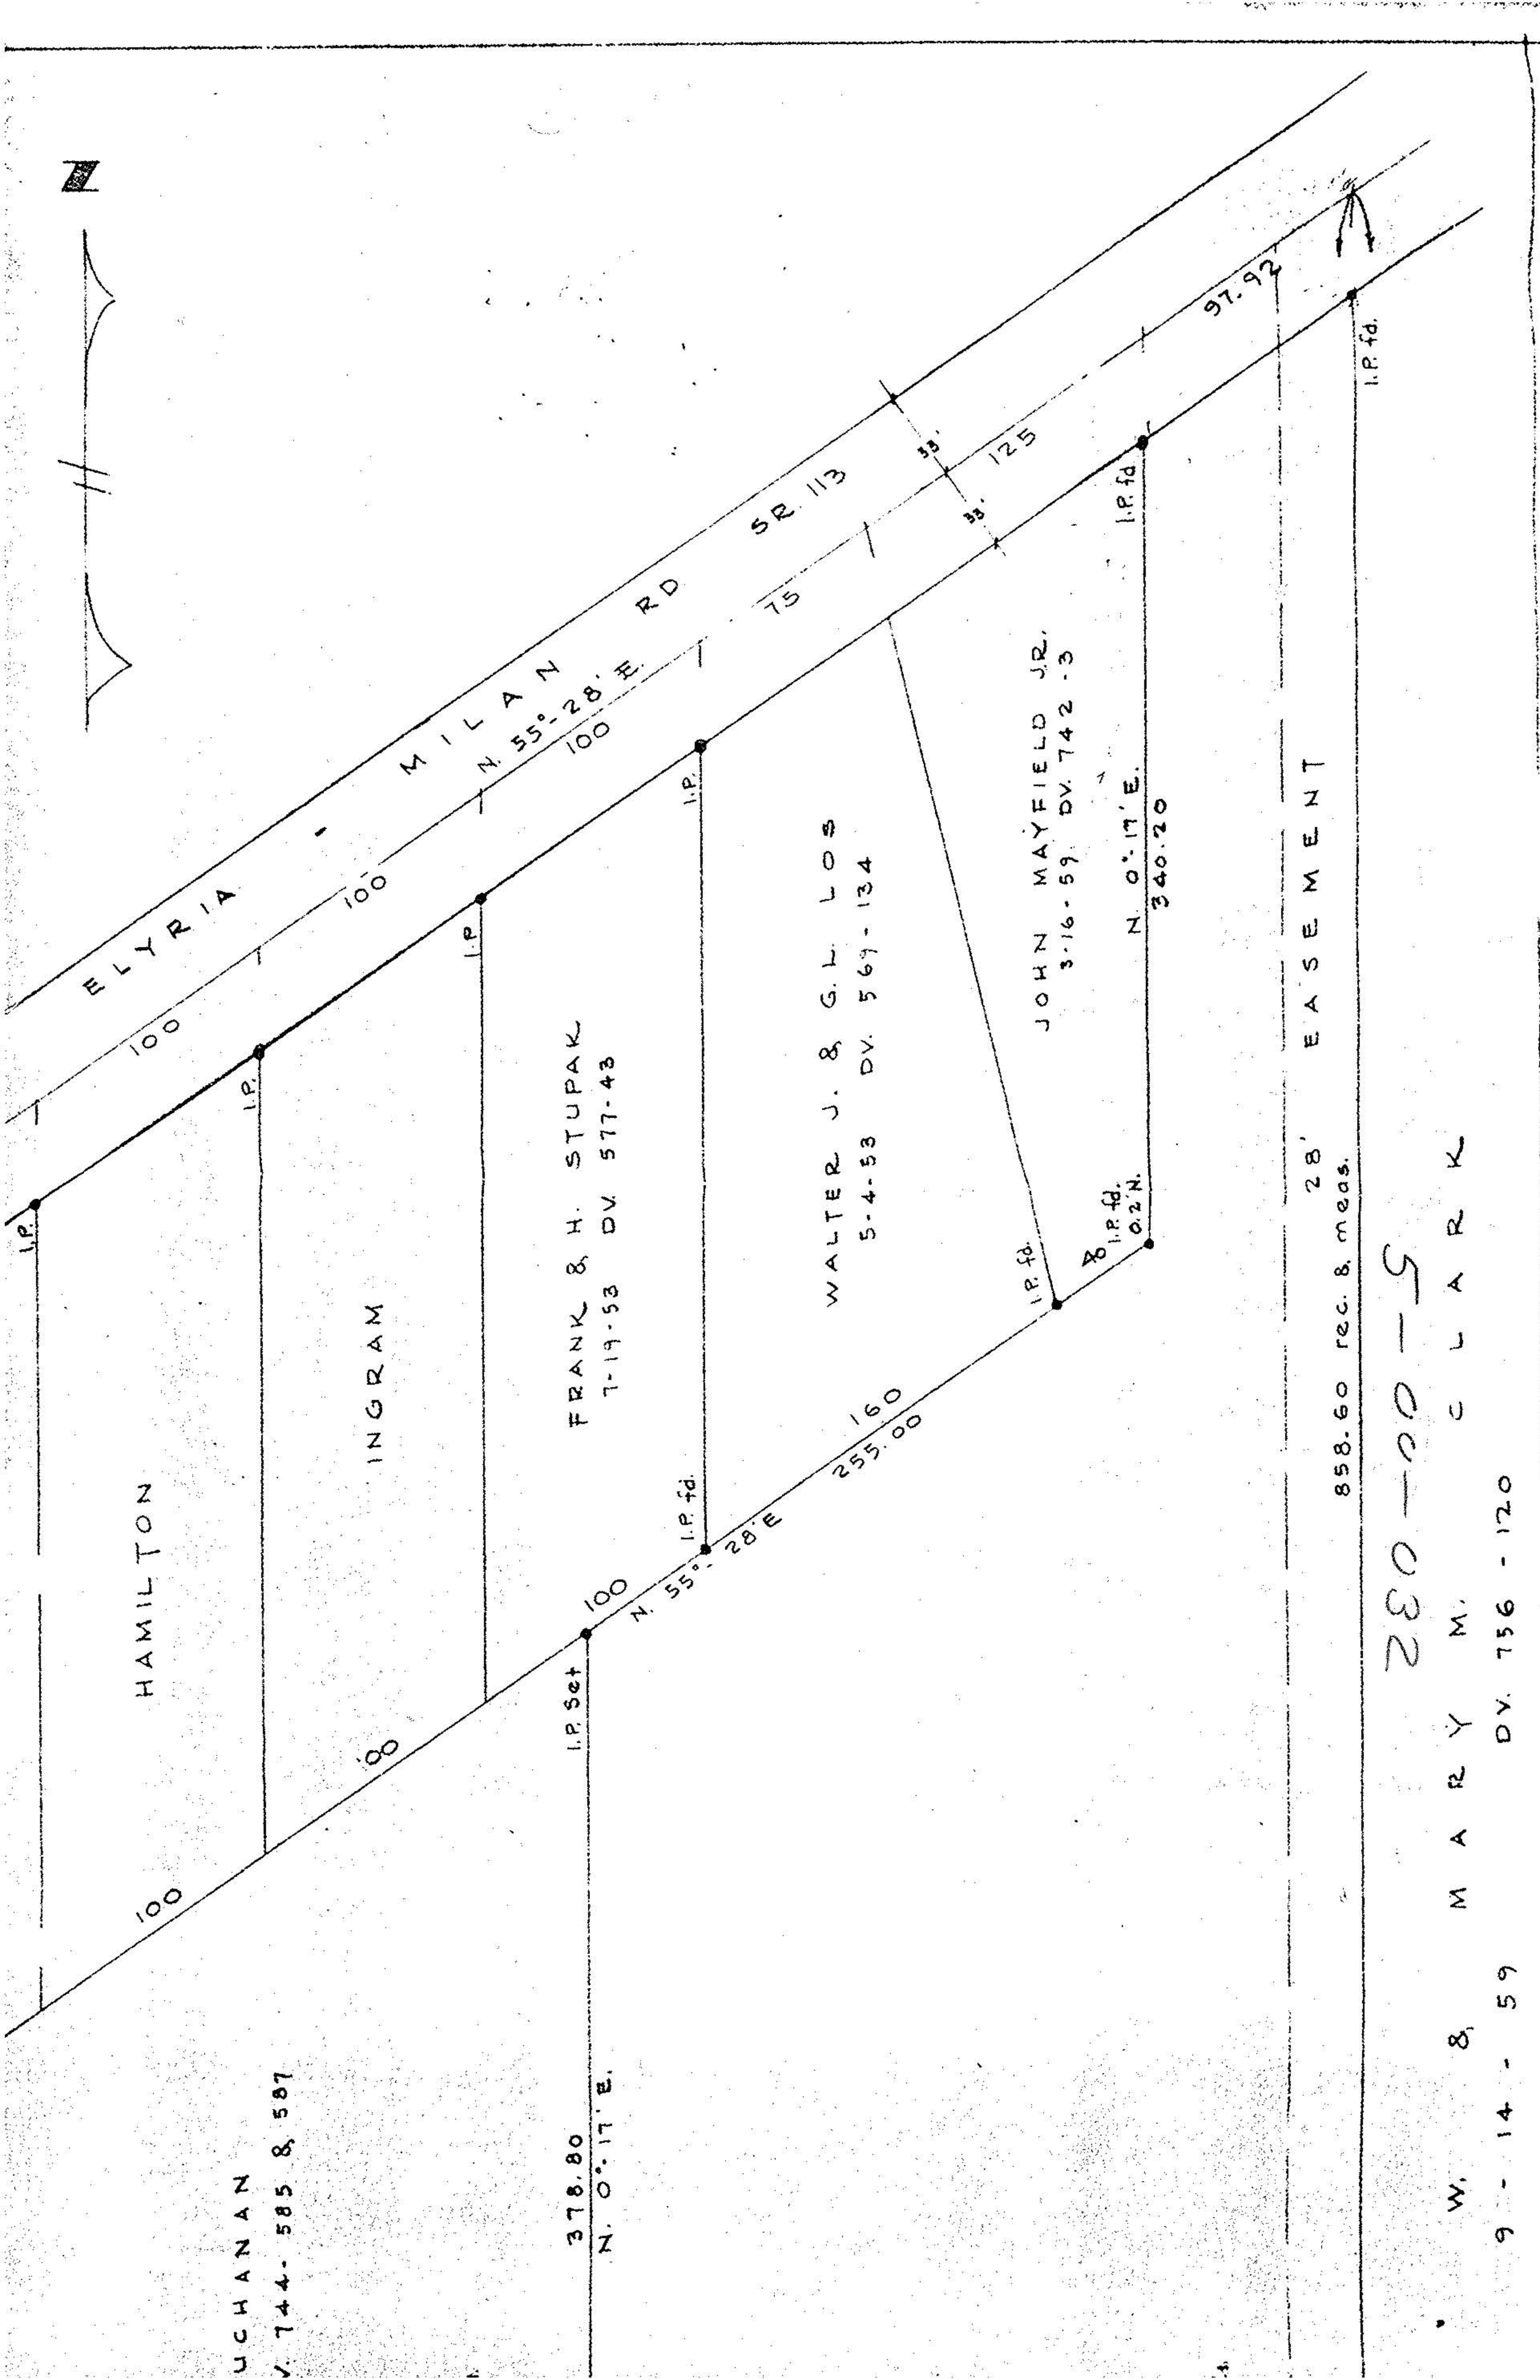


280-00-5

W. & MARY M. CLARK  
9-14-59 DV 756-120

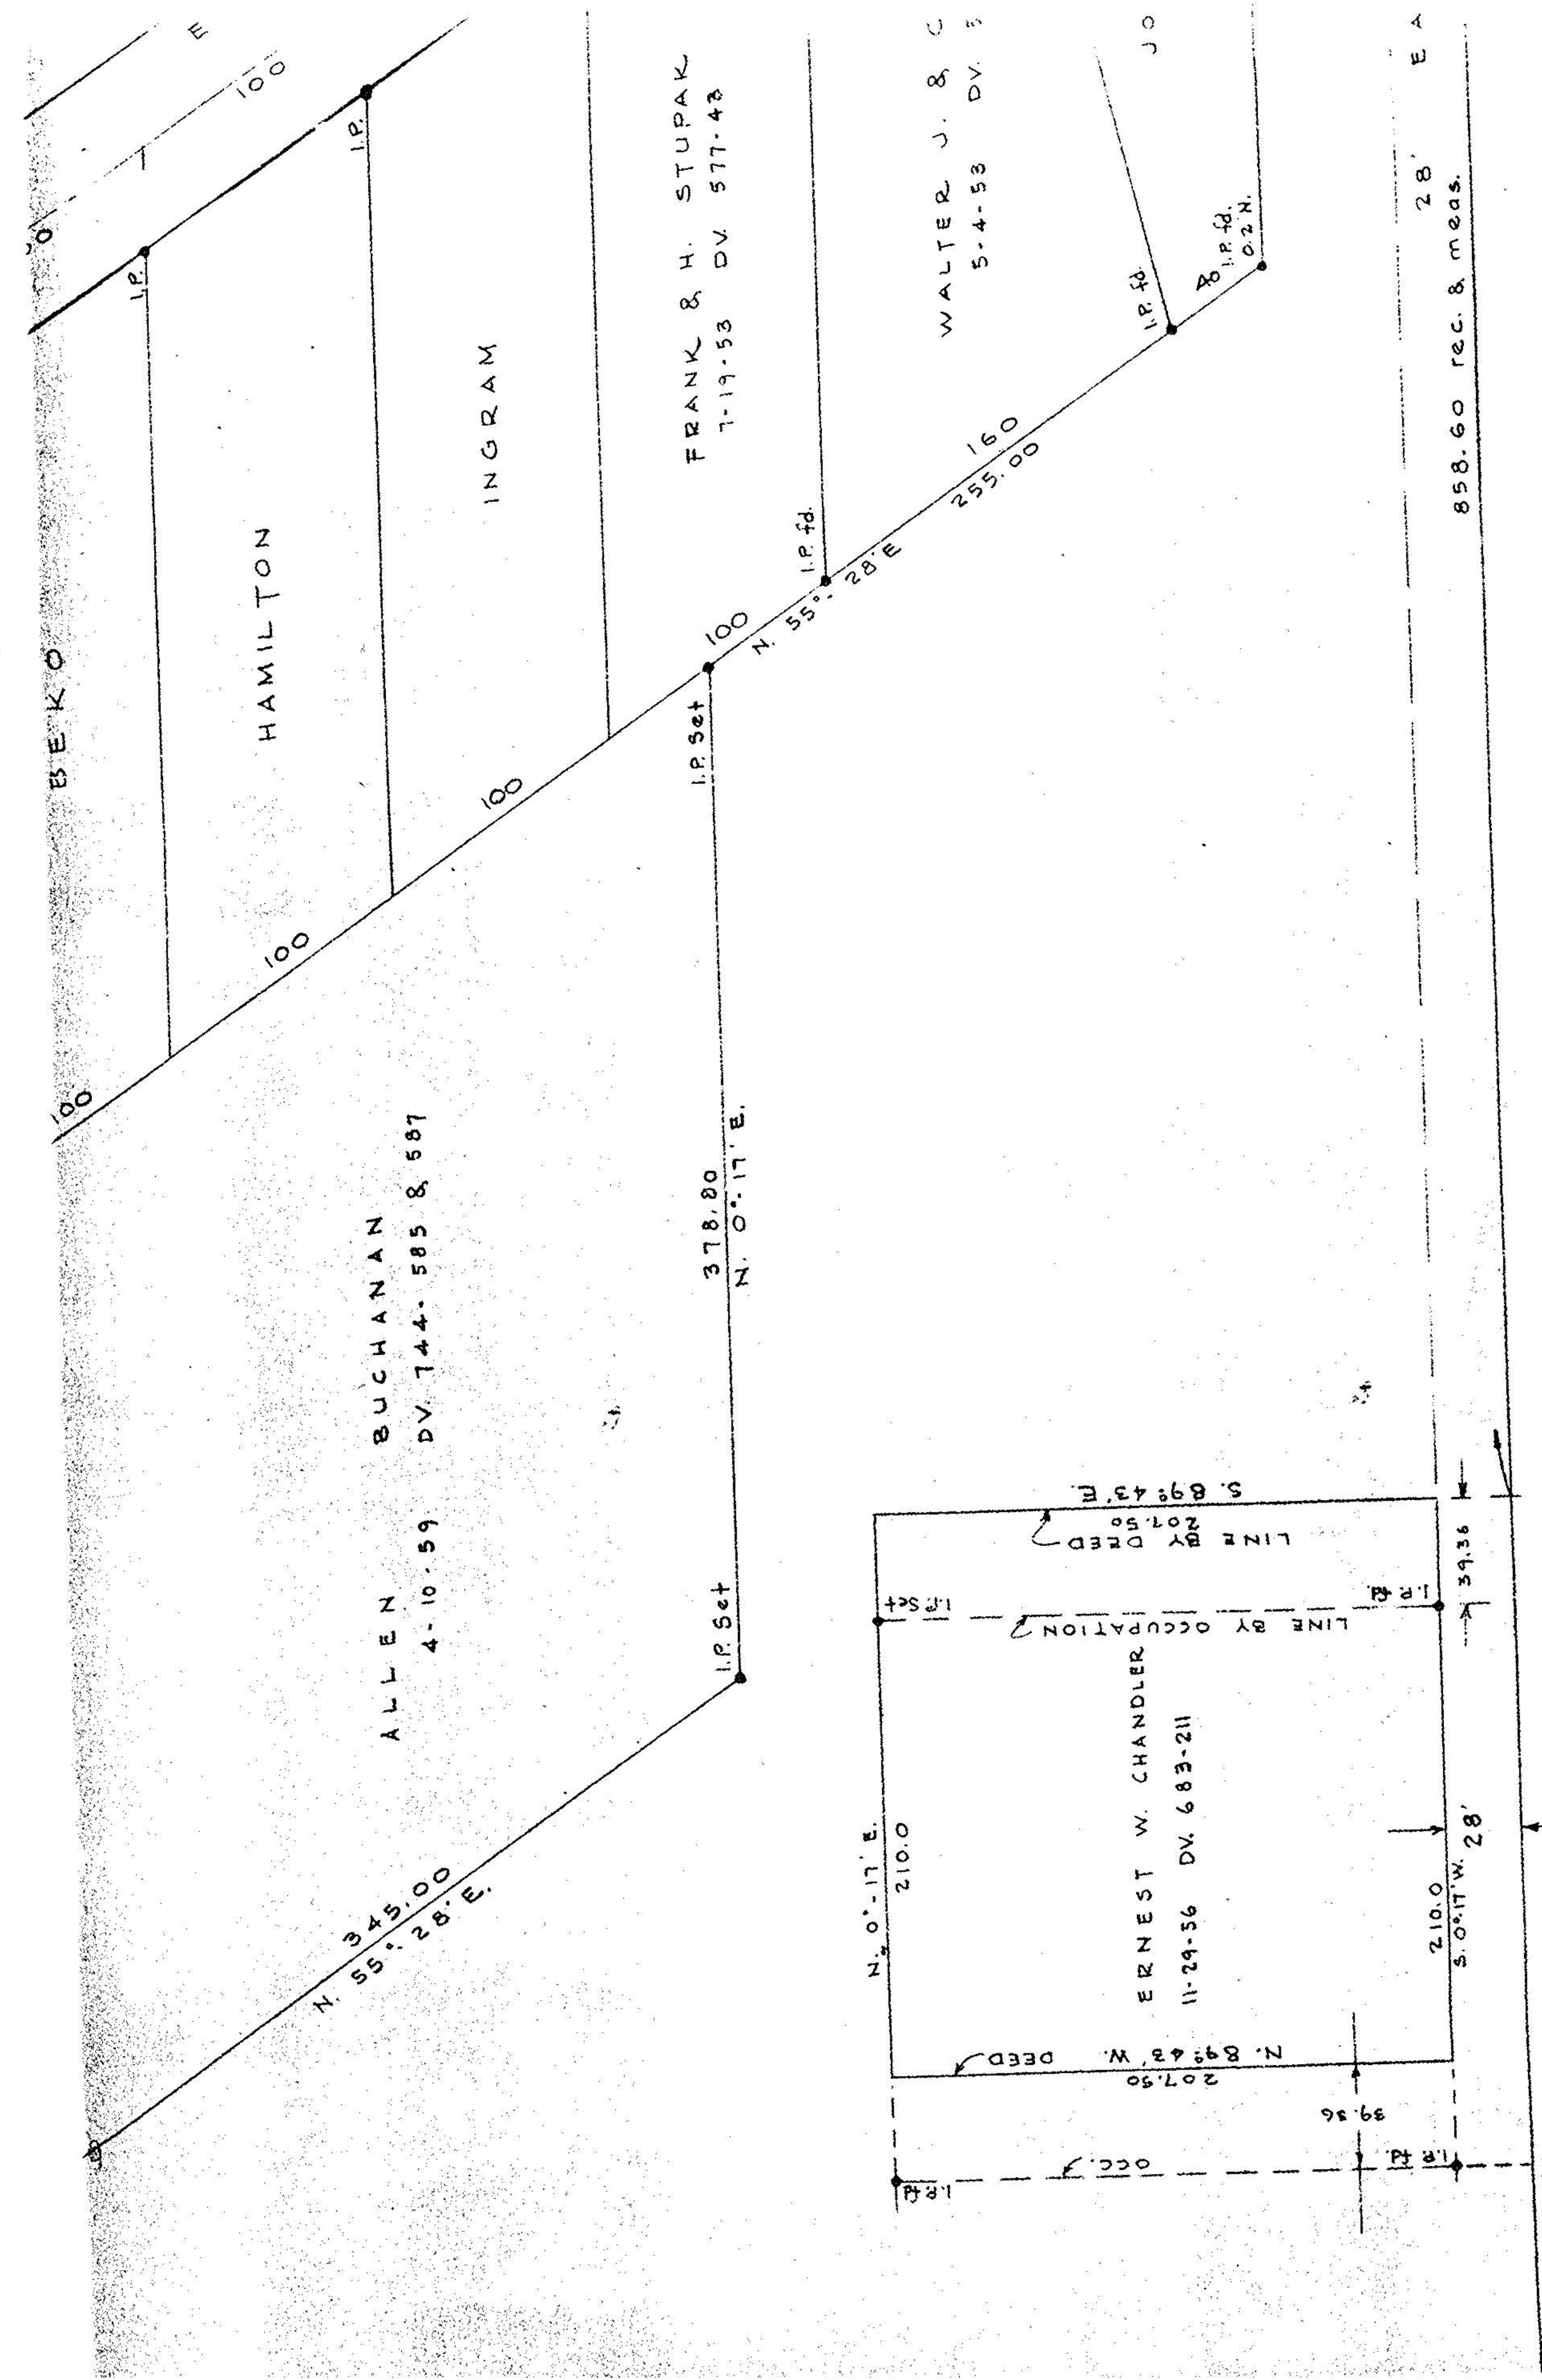

JOHN W. & MARY M. CLARK  
9-14-59 DV 756-120

709-72

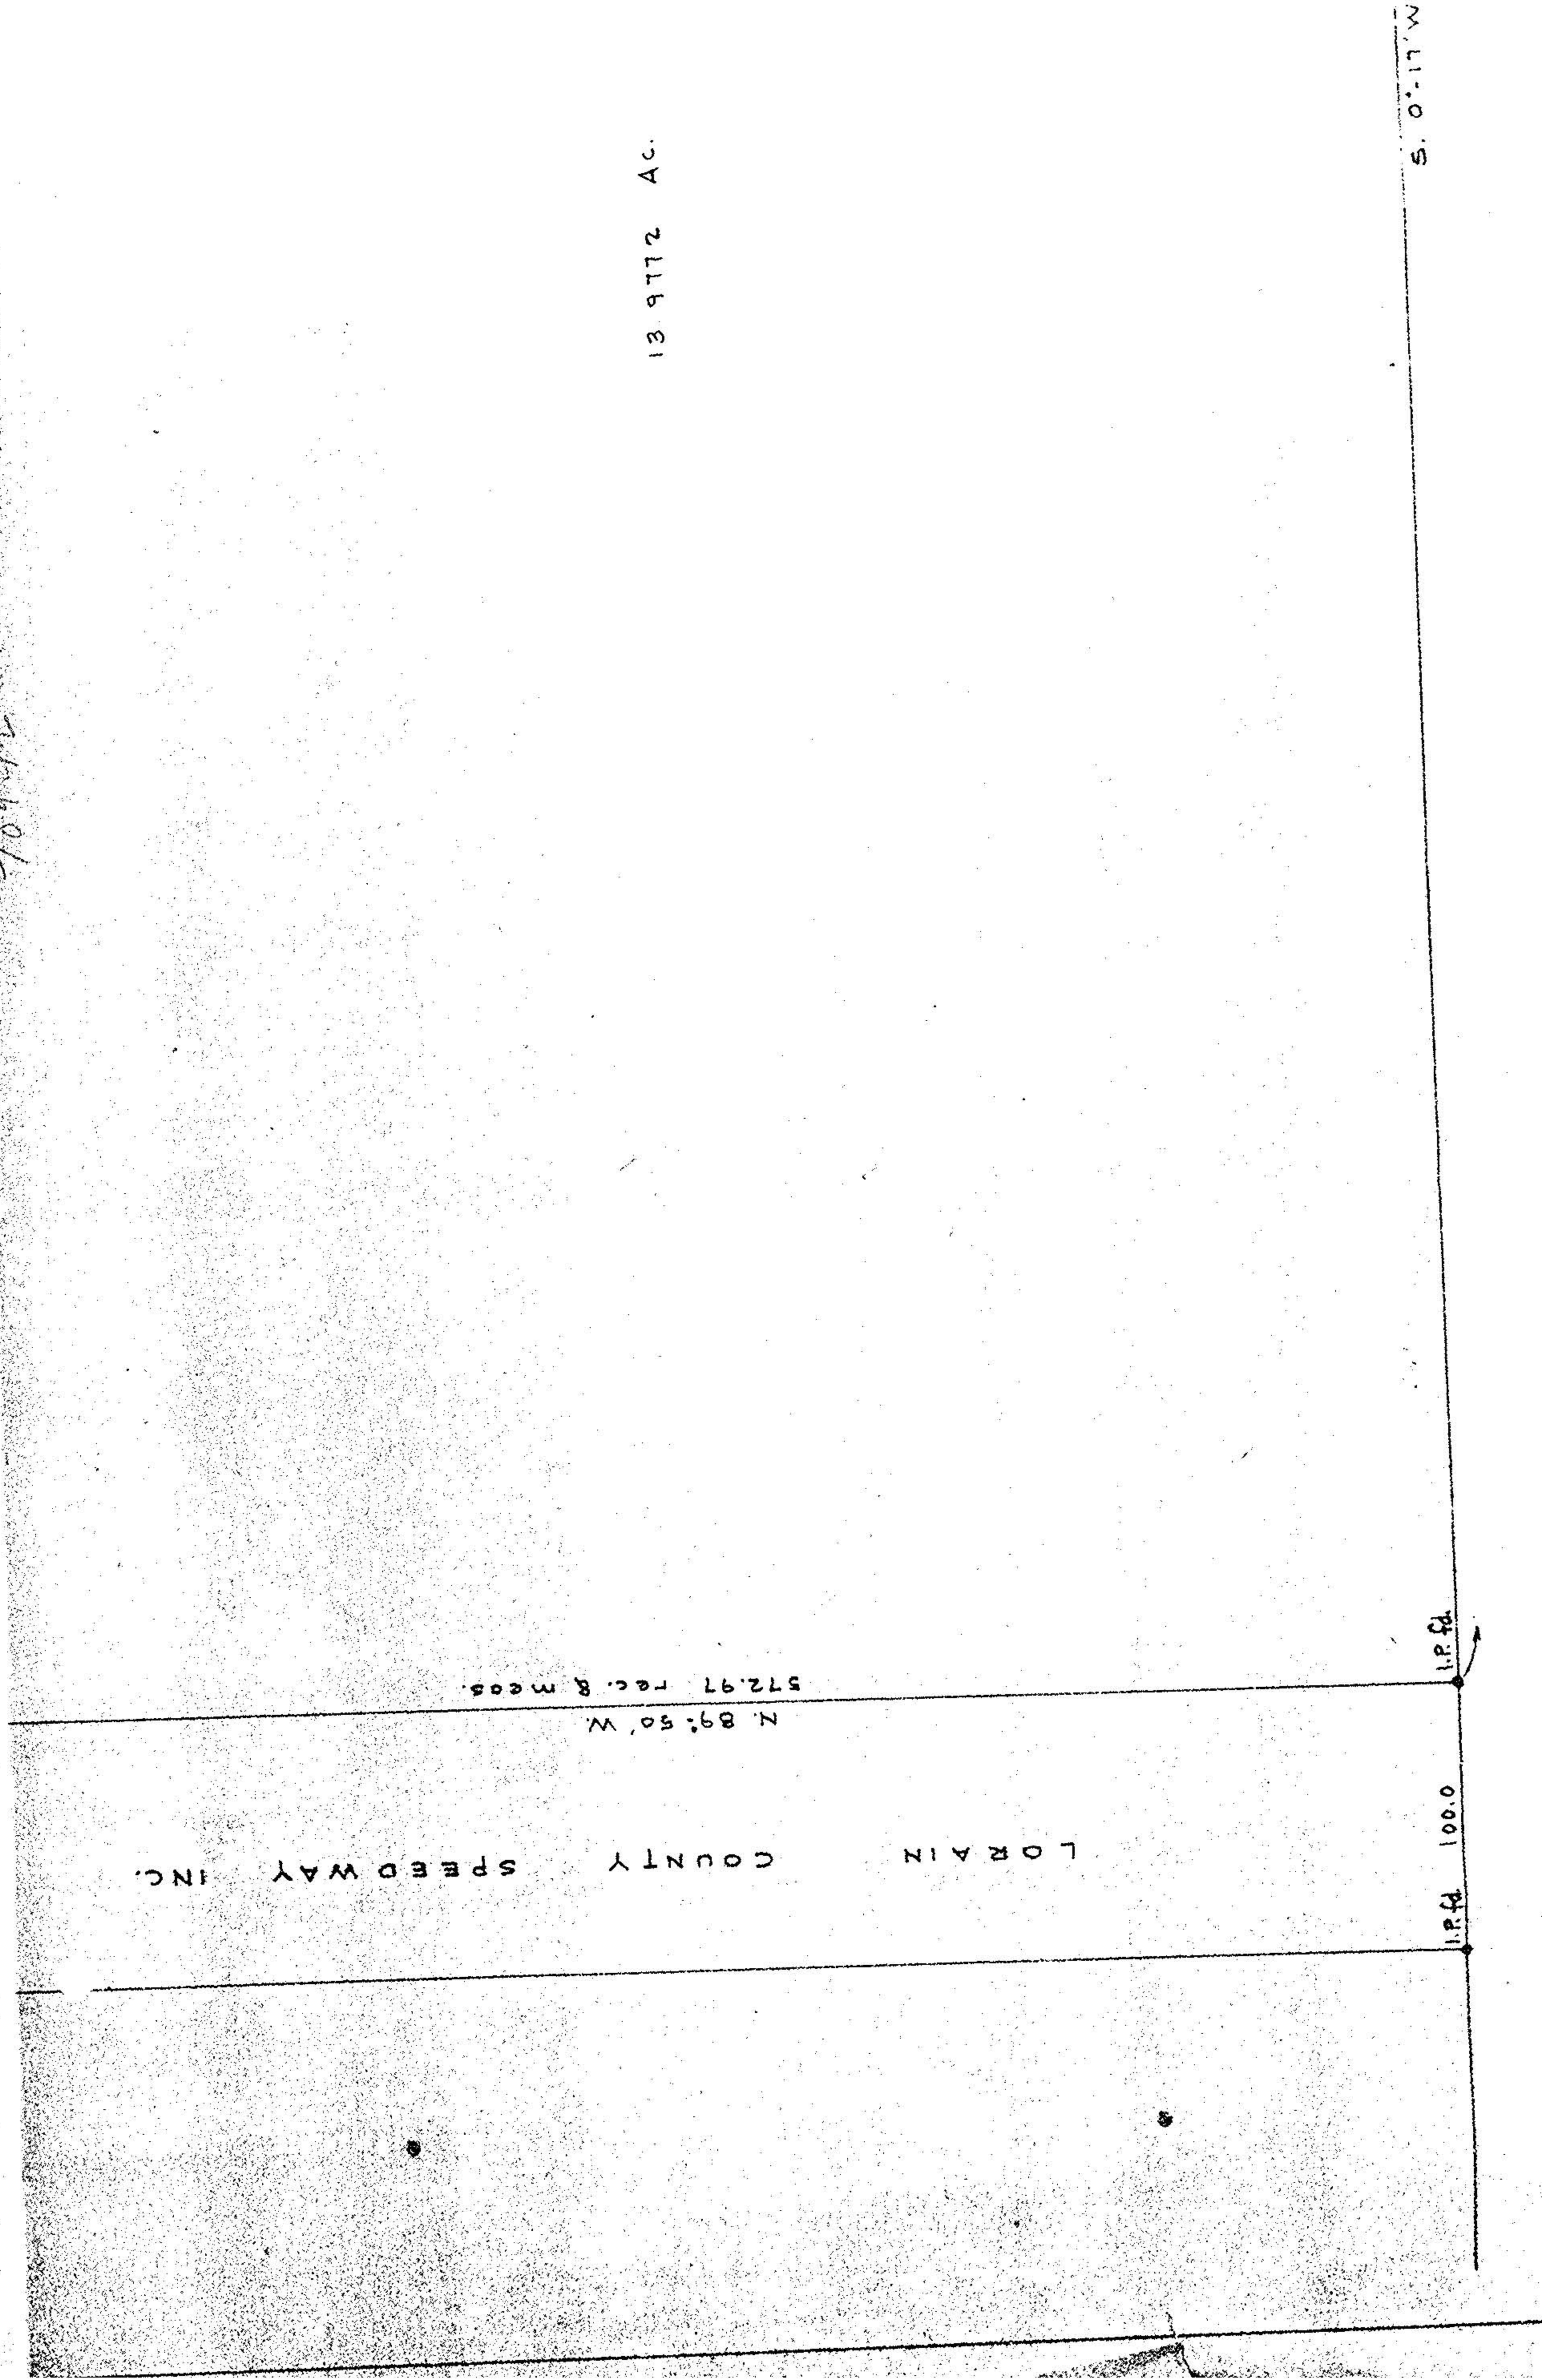

13.9772 AC.

S. 0° 17' W.