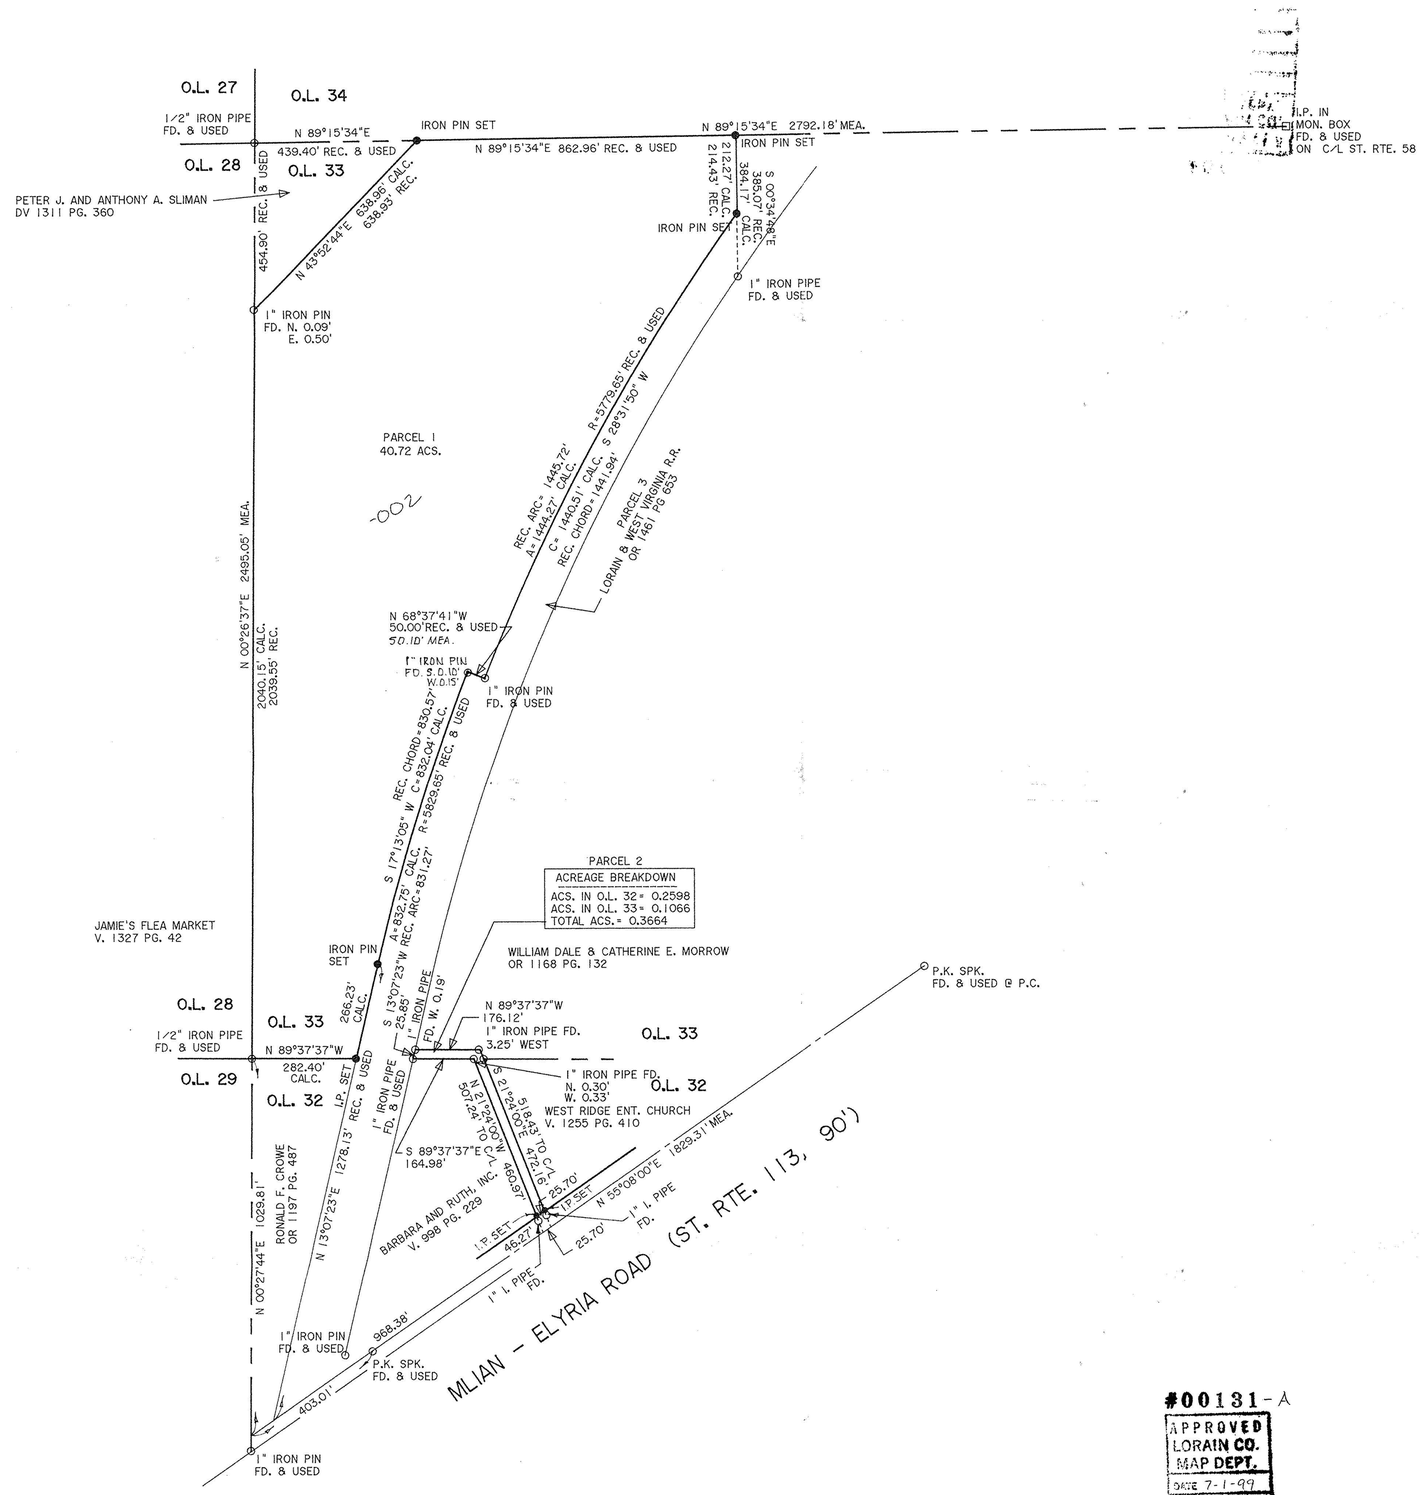

DIMENSIONS SHOWN ON THIS PLAT ARE EXPRESSED IN FEET AND DECIMAL PARTS THEREOF, ALL BEARINGS ARE TO AN ASSUMED MERIDIAN AND ARE USED TO INDICATE ANGLES ONLY. PERMANENT MONUMENTS WERE FOUND OR SET AT ALL POINTS INDICATED HEREON, ALL OF WHICH I CERTIFY TO BE CORRECT.

STATE OF OHIO
THOMAS A. SIMON
S-7775
REGISTERED PROFESSIONAL SURVEYOR

THOMAS A. SIMON
REG. PROFESSIONAL SURVEYOR
NO. S-7775

IRON PINS SET, ARE 5/8" DIA. 30" LONG WITH CAP, "T. SIMON, S-7775"

#00131-A

APPROVED
LORAIN CO.
MAP DEPT.
DATE 7-1-99
NAME S-00-033A
BY T. Smith
MAP NUMBER 00131-A

THOMAS SIMON & ASSOCIATES, INC.
PROFESSIONAL LAND SURVEYORS
28901 CLEMENS ROAD
SUITE 119
WESTLAKE, OHIO 44145
(440) 871-1391
FAX (440) 871-7335

PLAT OF SURVEY FOR PRECISION FITTINGS

BEING KNOWN AS PART OF ORIGINAL LOT NOS. 32 AND 33
AMHERST TOWNSHIP COUNTY OF LORAIN
STATE OF OHIO

SEPTEMBER, 1998 SCALE: 1" = 200'