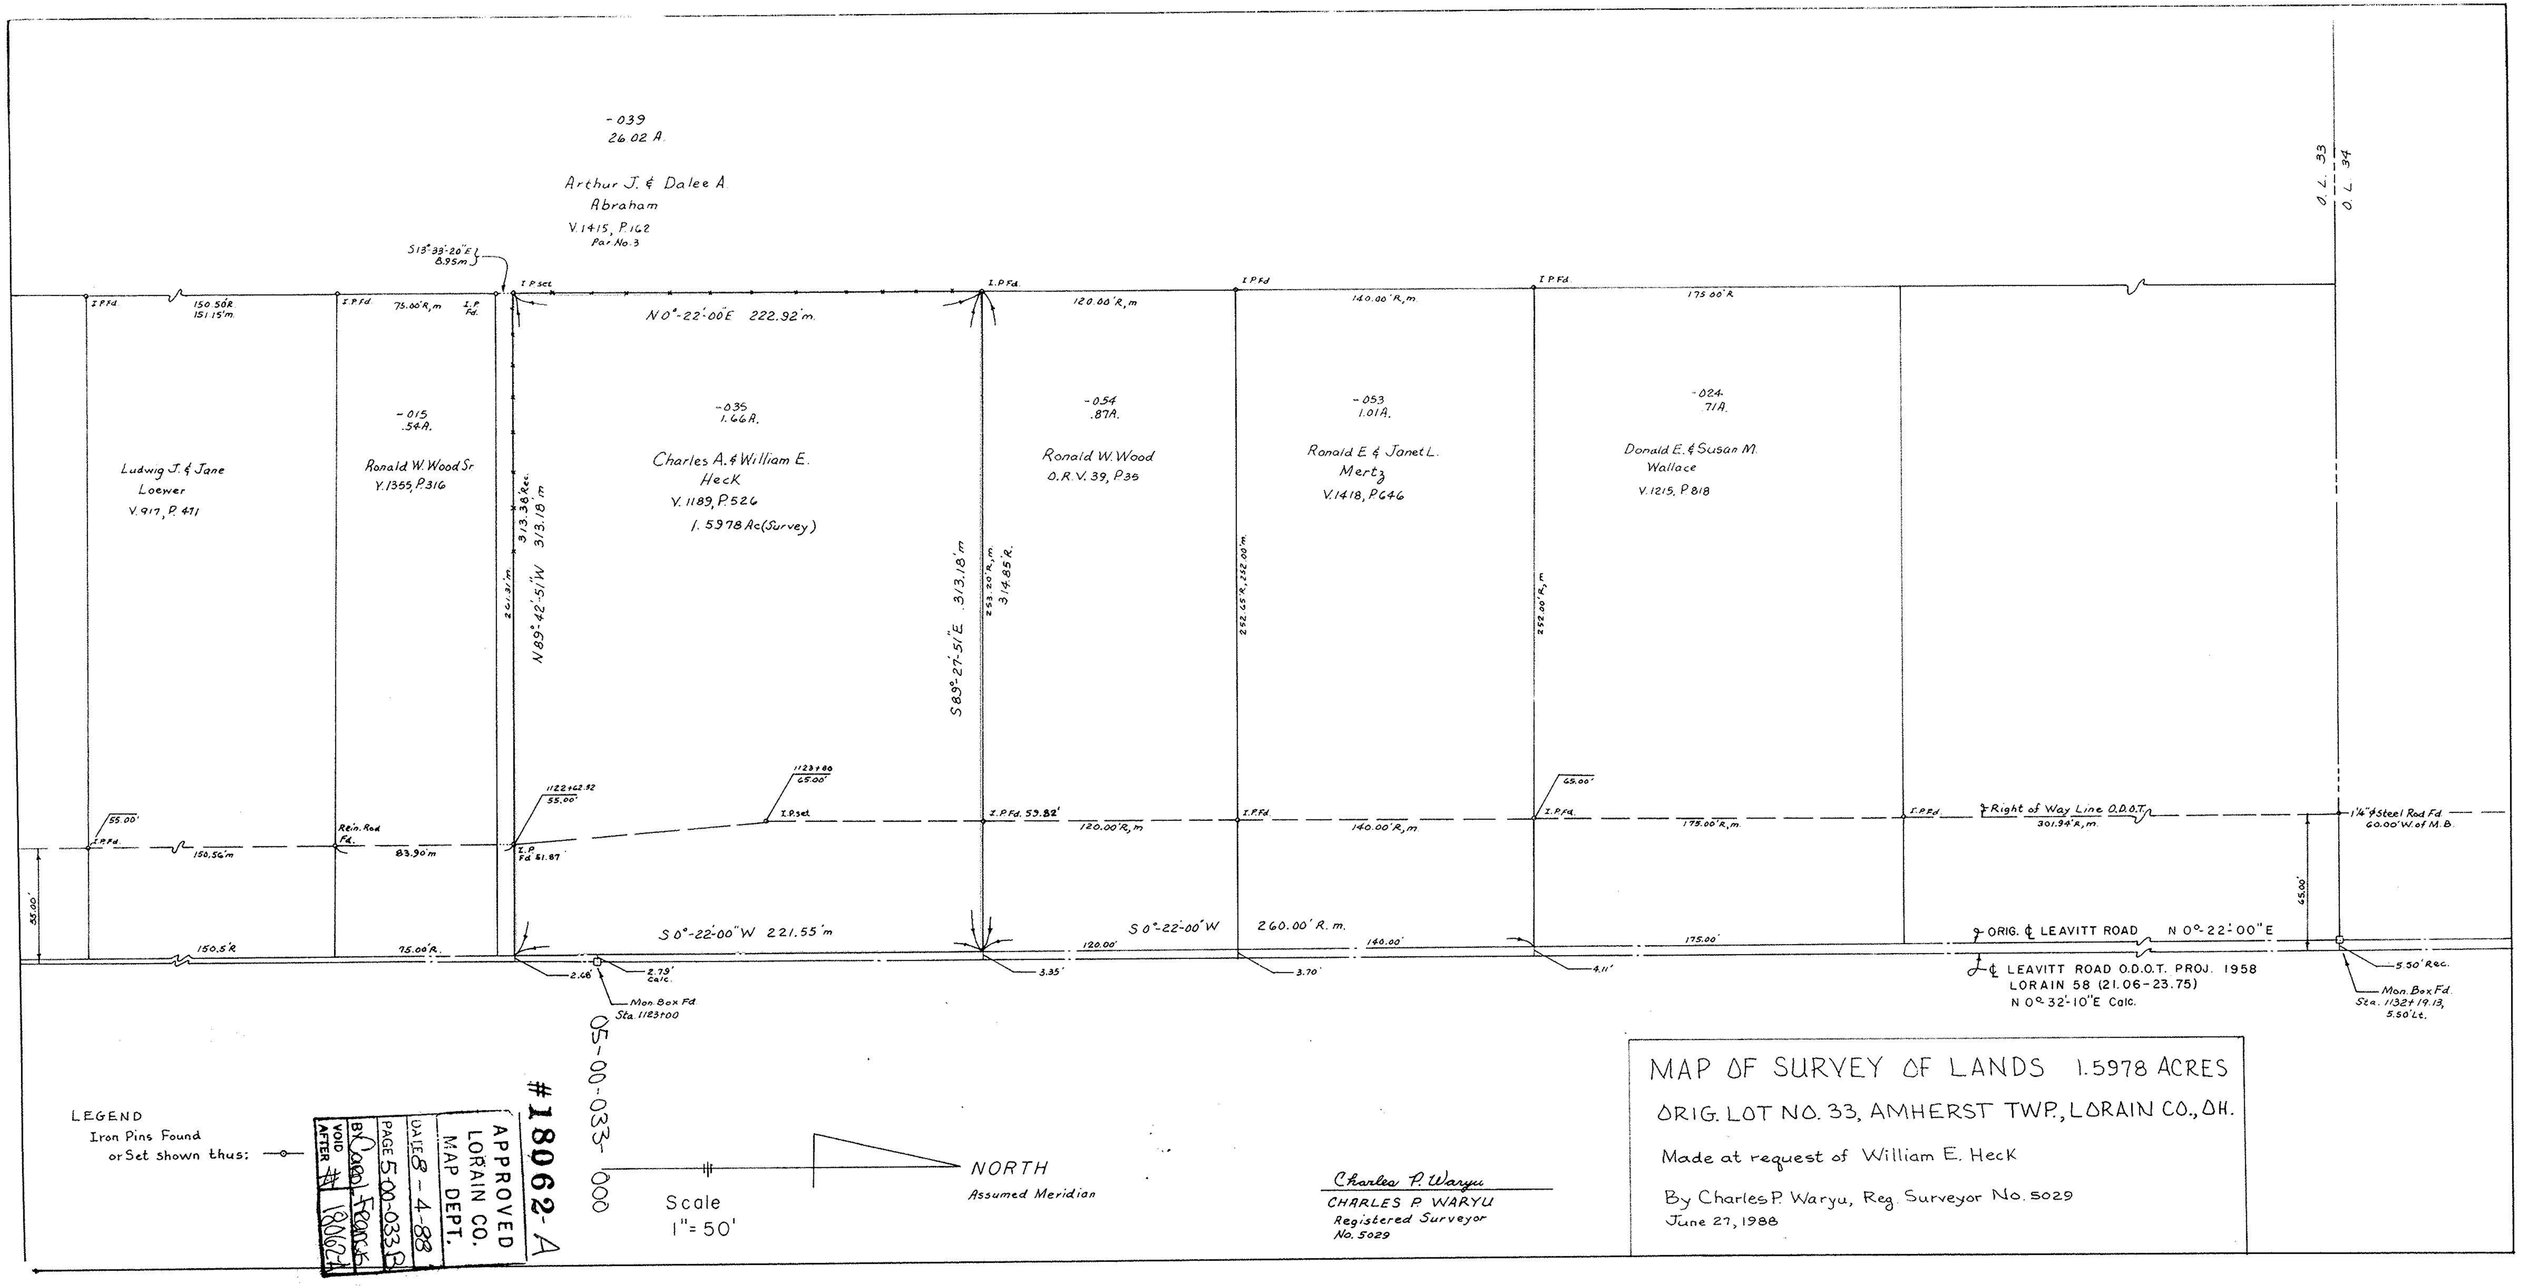
-039
26.02 A.
Arthur J. & Dalee A. Abraham
V.1415, P.162
Par. No. 3
S13°-33'-20"E 8.95m
I.P.Set.
I.P.Fd.
150.50'R.
151.15'm.
75.00'R,m
I.P. Fd.
N 0°-22'-00"E 222.92'm.
120.00'R,m
140.00'R,m.
175.00'R
O.L. 33
O.L. 34
-015
.54A.
-035
1.66A.
-054
.87A.
-053
1.01A.
-024
.71A.
Ludwig J. & Jane Loewer
V.917, P.471
Ronald W. Wood Sr.
V.1355, P.316
Charles A. & William E. Heck
V.1189, P.526
1.5978 Ac (Survey)
Ronald W. Wood
O.R. V.39, P.36
Ronald E. & Janet L. Mertz
V.1418, P.646
Donald E. & Susan M. Wallace
V.1215, P.818
N 89°-42'-51"W 313.38'Rec. 313.18'm
261.37'm
S 89°-27'-51"E 313.18'm
293.20'R,m
314.85'R.
292.65'R,m 292.00'm
292.00'R,m
1122+62.92
55.00'
1123+80
65.00'
I.P.Set.
I.P.Fd. 53.82'
65.00'
55.00'
I.P.Fd.
150.56'm
Rein. Rod Fd.
83.90'm
I.P. Fd 51.87'
120.00'R,m
140.00'R,m
175.00'R,m.
Right of Way Line O.D.O.T.
301.94'R,m.
1¼" ϕ Steel Rod Fd. 60.00'W. of M.B.
55.00'
65.00'
S 0°-22'-00"W 221.55'm
S 0°-22'-00"W
260.00'R. m.
120.00'
140.00'
175.00'
150.5'R
75.00'R.
ORIG. ℄ LEAVITT ROAD N 0°-22'-00"E
℄ LEAVITT ROAD O.D.O.T. PROJ. 1958
LORAIN 58 (21.06-23.75)
N 0°32'-10"E Calc.
2.66'
2.79' Calc.
3.35'
3.70'
4.11'
5.50'Rec.
Mon. Box Fd.
Sta. 1123+00
Mon. Box Fd.
Sta. 1132+19.13,
5.50'Lt.
05-00-033-000
#18062-A
APPROVED
LORAIN CO.
MAP DEPT.
DATE 8-4-88
PAGE 500-033B
BY Carol Francis
VOID AFTER #18062A
LEGEND
Iron Pins Found
or Set shown thus:
Scale
1" = 50'
NORTH
Assumed Meridian
Charles P. Waryu
CHARLES P. WARYU
Registered Surveyor
No. 5029
MAP OF SURVEY OF LANDS 1.5978 ACRES
ORIG. LOT NO. 33, AMHERST TWP., LORAIN CO., OH.
Made at request of William E. Heck
By Charles P. Waryu, Reg. Surveyor No. 5029
June 27, 1988