

STANG ROAD 40'

PK. Fd. & Used 01.64
01.65

033
MICHAEL P. SLIMAN
D.V. 714 P. 596

030
JOSE L. & ELSIE
GARCIA
O.R.V. 120 P. 364

031
JOSEL. & ELSIE
GARCIA
O.R.V. 120 P. 366

026
ROY M. & NORMA J.
ZVOSEC
D.V. 1429 P. 250

032
THOMAS A. LAHETTA
O.R.V. 637 P. 702

379.63' Calc.
380.00' Rec.

538.72' Calc./M.

268.79' Calc./M.

OBERLIN ROAD

N-0°00'00"-E
393.63'

643.15' Meas.

288.5'M.

81'

37'

75.00'

210.84'

199.68' Rec.

199.94' Calc.

170.28' Meas.

170.20' Rec.

444.17' Rec.

438.81' Calc.

111.71' Meas.

324.43'








034
10.0000 AC.

1236.16'

S-89°45'32"-E

980.05'

611.86'

LEONARD J. & ROBIN M.
GNIZAK
D.V. 1267 P. 688


444.17' Rec.

438.81' Calc.

05-00-065-000-023

FRANCIS A. & PATRICIA E.
GNIZAK
D.V. 1133 P. 134 P.I.#1
48.20 AC ± Rem.

ALL BEARINGS SHOWN ARE FROM AN ASSUMED MERIDIAN, AND USED FOR THE PURPOSE OF DESCRIBING ANGLES ONLY.

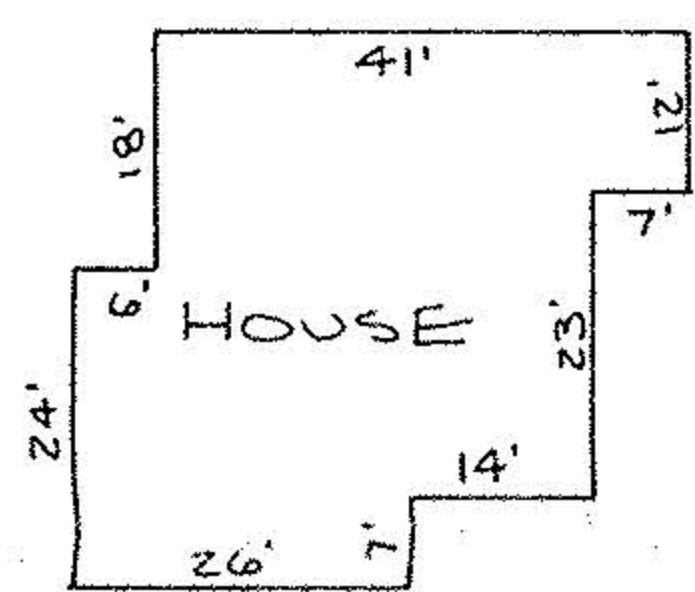

HOUSE DETAIL
SCALE: 1"=30'

WEST END OF FENCE

HOUSE (SEE DETAIL)

GRAVEL

GRAVEL

SCALE: 1"=100'

05-00-065-000

20388

APPROVED
LORAIN CO.
MAP DEPT.
DATE 6-11-93
PAGE 5-D
CAROLYN
BY FRANCIS
VOID AFTER # 20388

SURVEY MAP

PART OF ORIGINAL AMHERST TOWNSHIP LOT NO. 65
TOWNSHIP OF AMHERST

COUNTY OF LORAIN

STATE OF OHIO

DATE: 5-7-93

SCALE: 1"=100'

Michael A. Straub
MICHAEL A. STRAUB
REG. SURVEYOR NO. 7055

PREPARED BY:
KS ASSOCIATES INC.
ENGINEERS & SURVEYORS
REV. 5-19-93