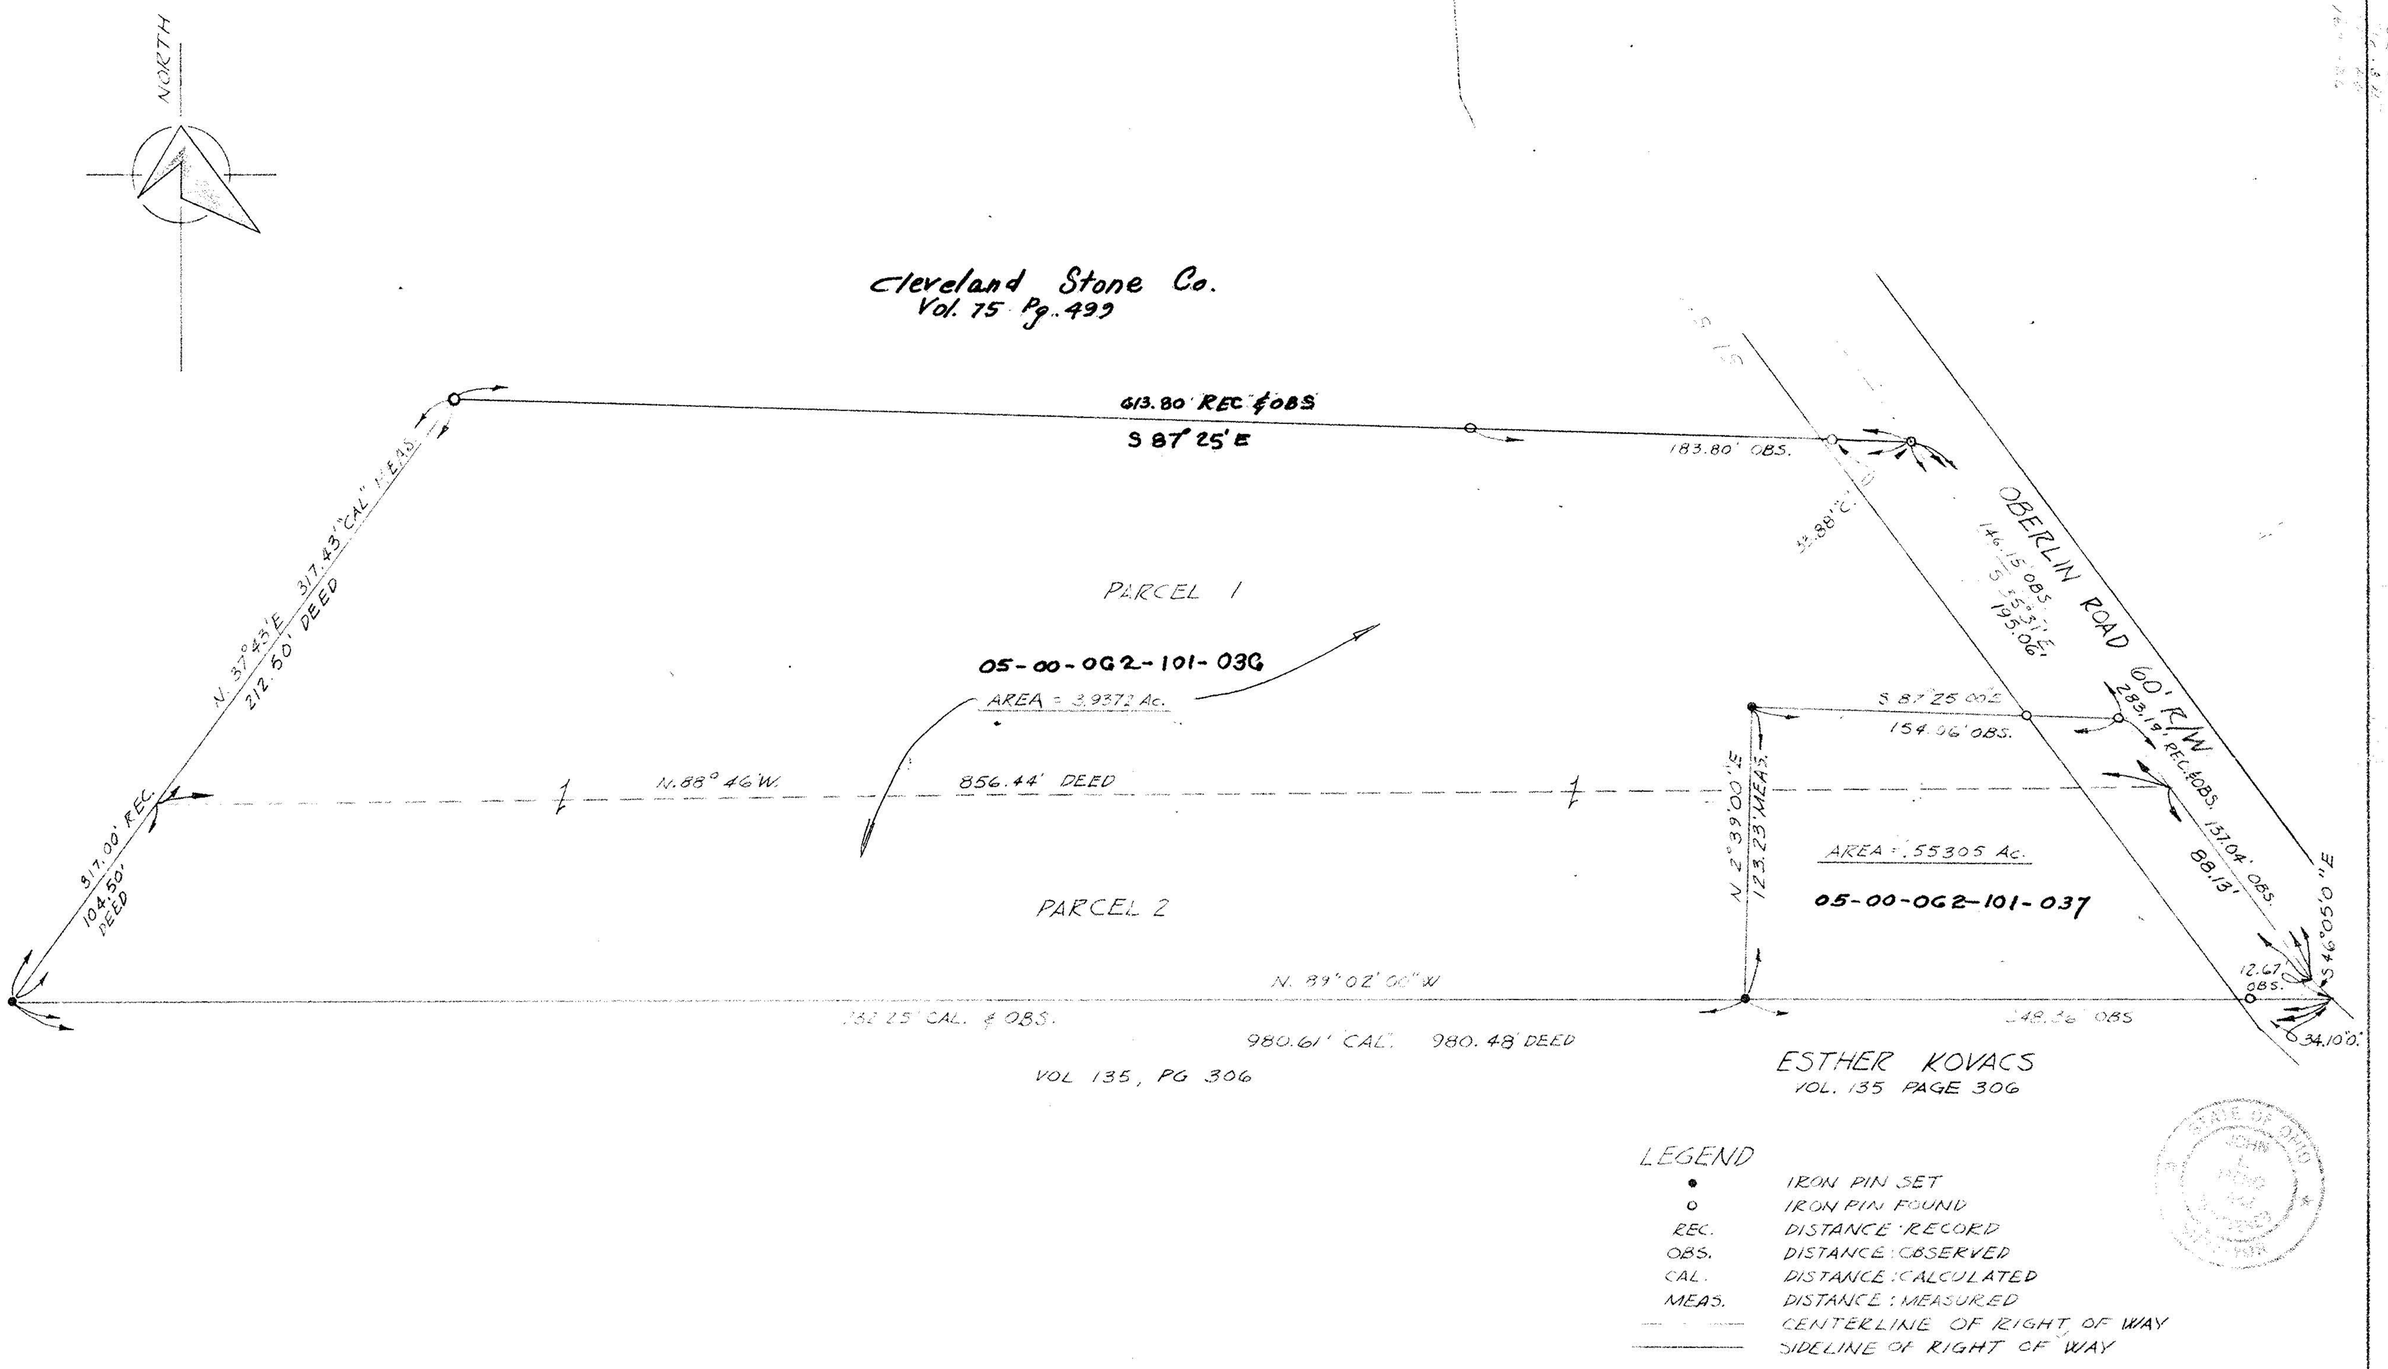

CORNELIUS J. BORER
6090 OBERLIN RD.
AMHERST, OHIO 44001

SCHAFER, HURA & ASSOCIATES, INC.
ENGINEERS AND SURVEYORS
4370 OBERLIN AVE.
LORAIN, OHIO

282-4223

SURVEY

ORIGINAL LOT	62	DATE	12-20-72
TOWNSHIP	AMHERST	SCALE	1"=50'
CITY OF	AMHERST	FIELD BOOK	219 PG 106
COUNTY OF	LORAIN	DRAWN BY	W.F.C.
STATE OF	OHIO	CHECKED BY	J.L.M.
W. O.	1889	FILE NO.	5-62