



LEGEND: IRON PIPES, RODS FOUND,
SET, SHOWN THUS: ○

NORTH

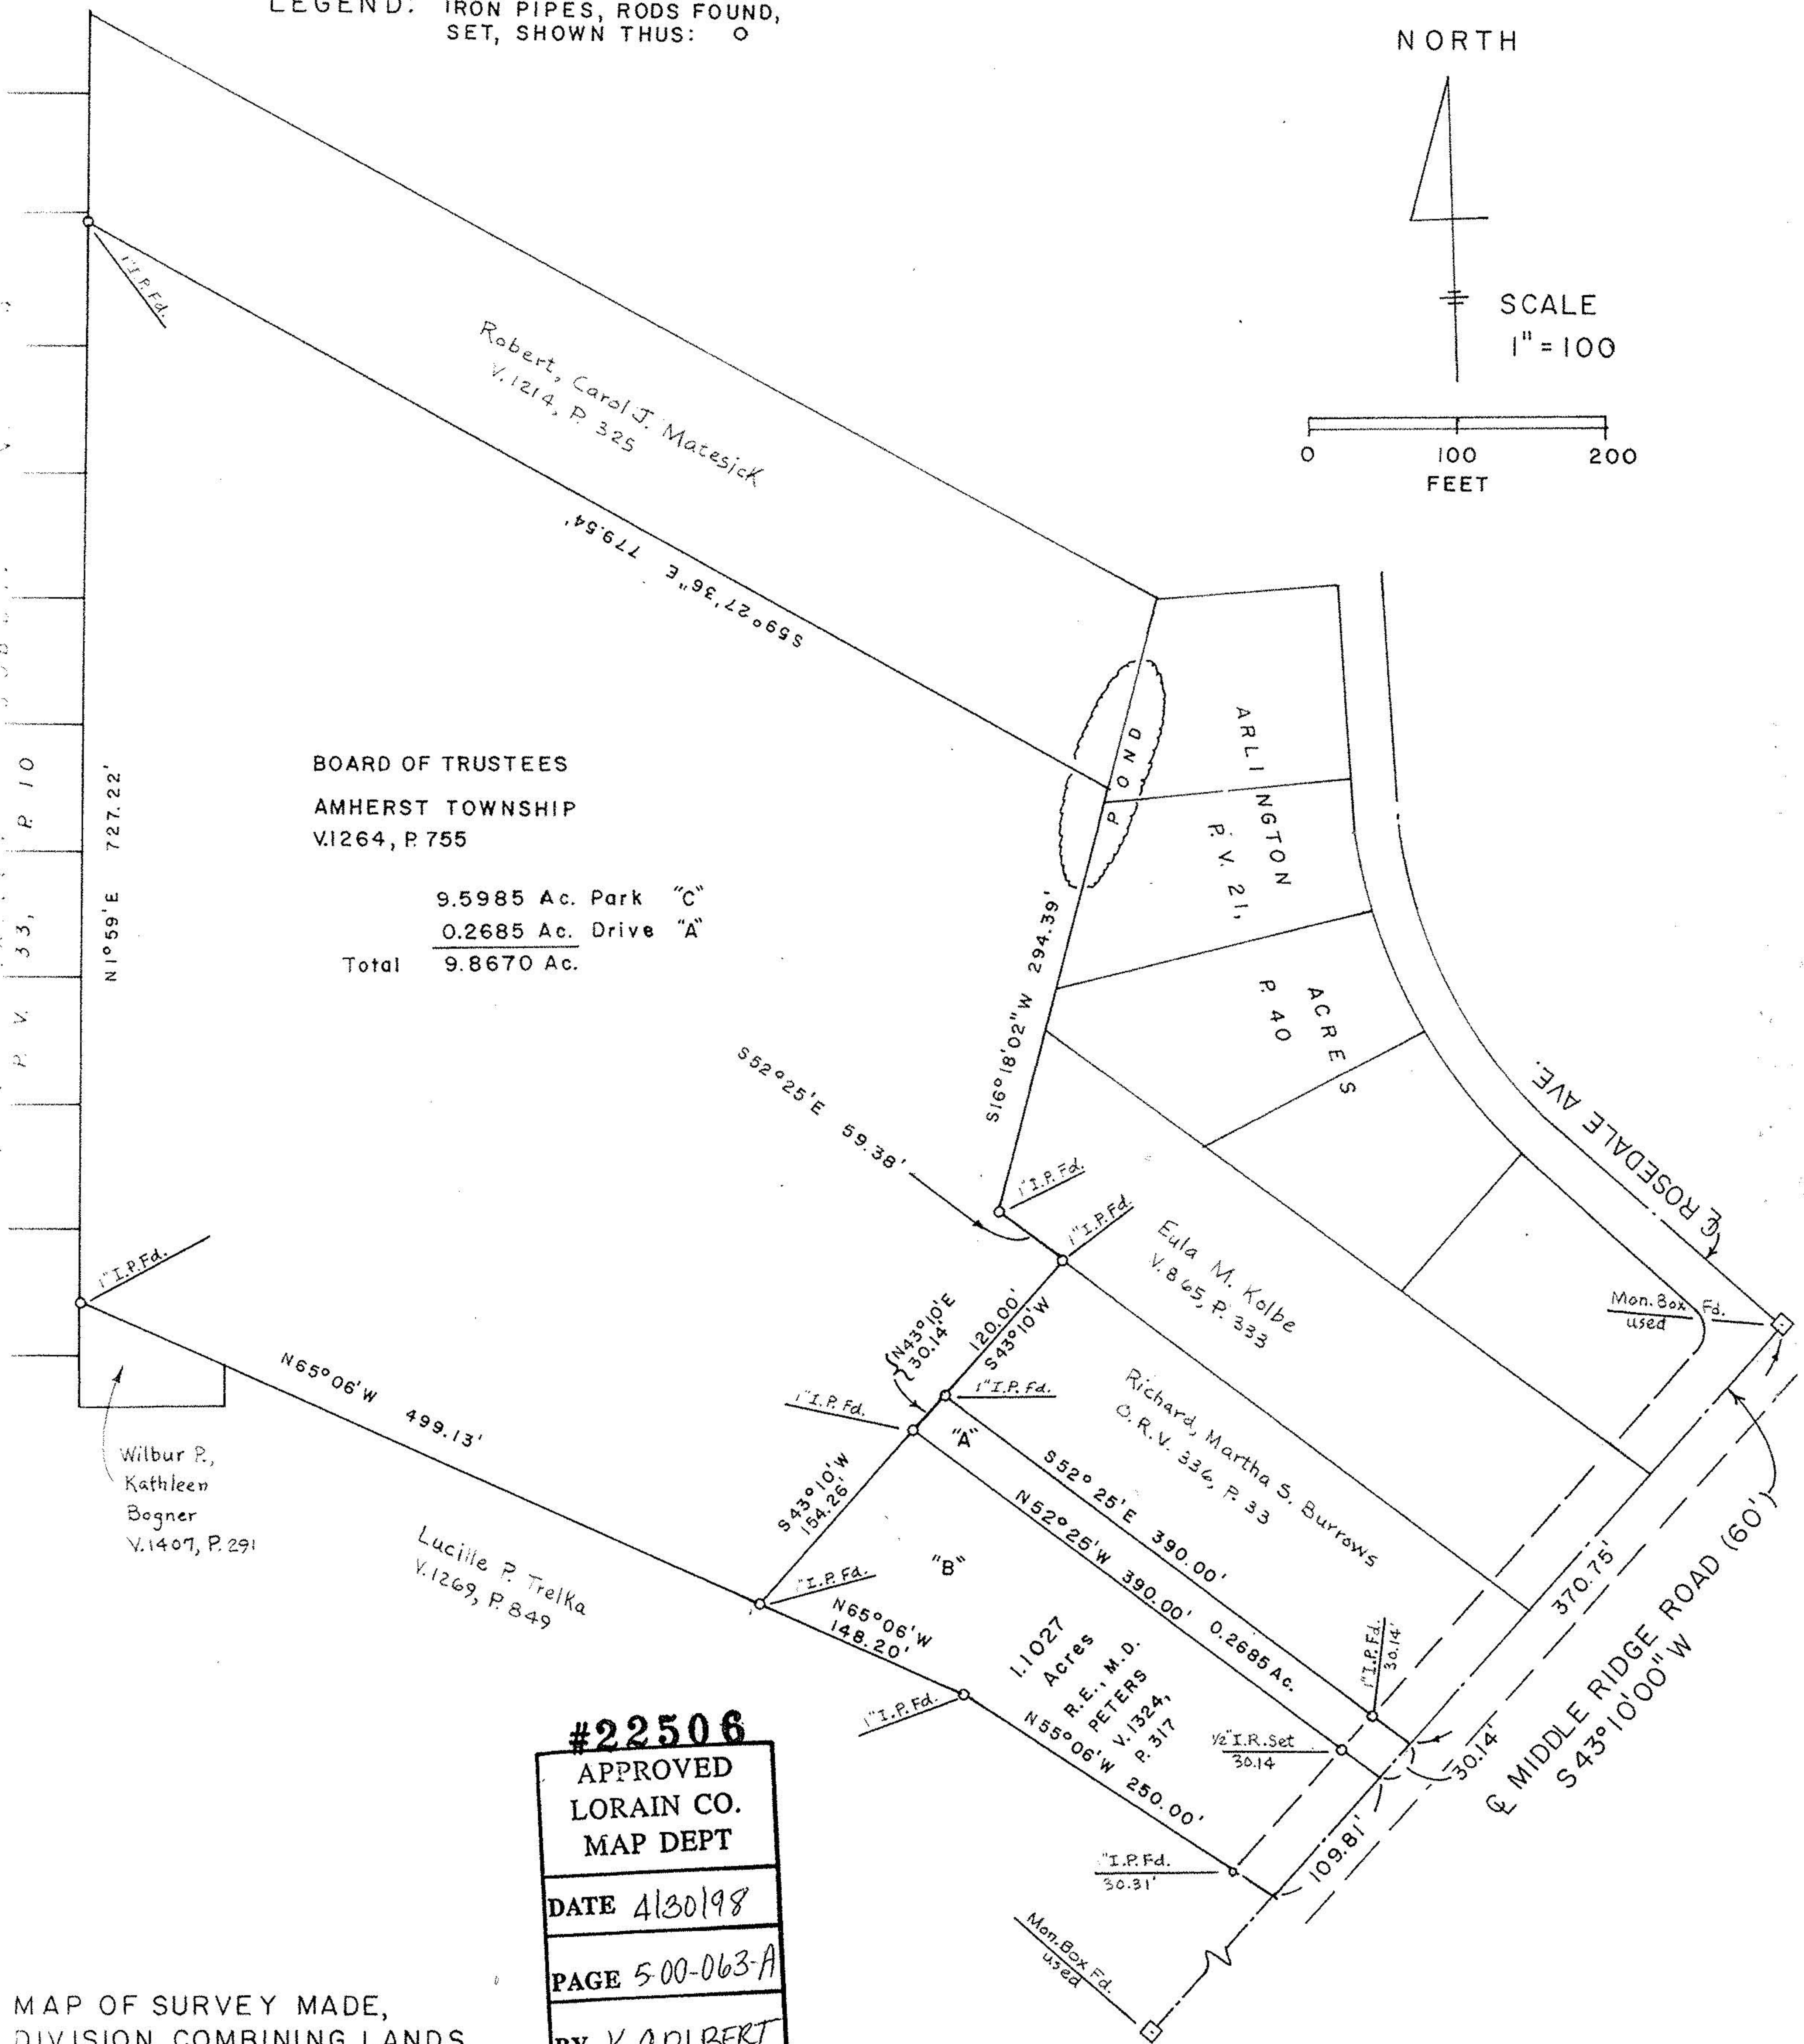

SCALE
1" = 100

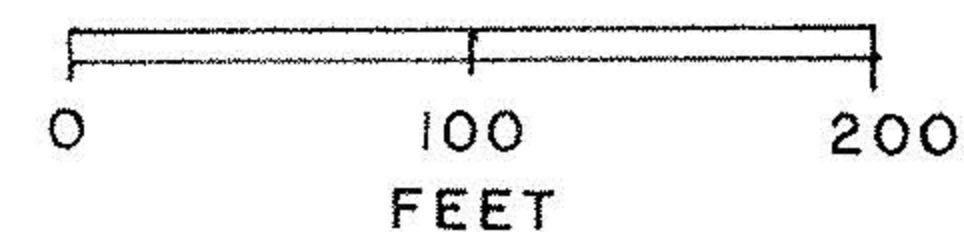

BOARD OF TRUSTEES
AMHERST TOWNSHIP
V.1264, P.755

9.5985 Ac. Park "C"
0.2685 Ac. Drive "A"
Total 9.8670 Ac.

#22506
APPROVED
LORAIN CO.
MAP DEPT
DATE 4/30/98
PAGE 500-063-A
BY K. COLBERT
#22506

MAP OF SURVEY MADE,
DIVISION, COMBINING LANDS,
PART OF ORIGINAL LOT NO. 63,
AMHERST TWP, LORAIN CO., OHIO
FOR AMHERST TOWNSHIP TRUSTEES
March, 1998

Charles P. Waryu
CHARLES P. WARYU,
REGISTERED SURVEYOR NO. 5029