


PREPARED FOR
GUNVER K. PENTON (LODGE)

SITUATED IN THE TOWNSHIP OF AMHERST, COUNTY OF LORAIN, STATE OF OHIO, AND KNOWN AS BEING PART OF ORIGINAL AMHERST LOT NO. 61.

SURVEYOR'S STATEMENT

DISTANCES ARE EXPRESSED IN FEET AND DECIMAL PARTS THEREOF. BEARINGS ARE TO AN ASSUMED MERIDIAN AND ARE USED TO INDICATE ANGLES ONLY. PERMANENT MONUMENTS WERE FOUND OR SET AS INDICATED HEREON. ALL OF WHICH I DECLARE TO BE CORRECT TO THE BEST OF MY ABILITIES AND BELIEF.

Thomas M. Sneyek 2-3-95
 THOMAS M. SNEZEK, P.S. #7051 DATE

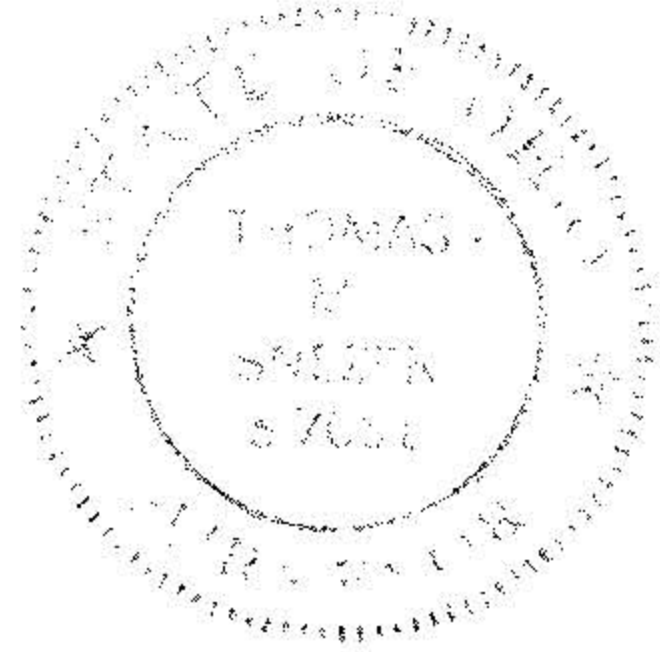

SCALE: 1"=50'

REVISION 1 3-16-95

PARCEL "C"
 ASSEMBLY OF ALL
 FOUR PARCELS

- 025 = 0.85 AC.
- 026 = 0.85 AC.
- 029 = 24.00 AC.
- 030 = 0.65 AC.

TOTAL = 26.35 AC.


OF WHICH 0.08 ACRES
 IS IN THE CITY OF
 AMHERST ORIGINAL
 LOT 60. AND 26.27
 ACRES IS IN AMHERST
 TOWNSHIP LOT 61

PARCEL "C"
 TOTAL ASSEMBLY
 26.35 ACRES

05-00-061-104-

21315

| |
|------------------------------------|
| APPROVED LORAIN CO. MAP DEPT |
| DATE 5-2-95 |
| PAGE 5-00-061A |
| BY CAROLYN FRANCIS |
| 21315 |

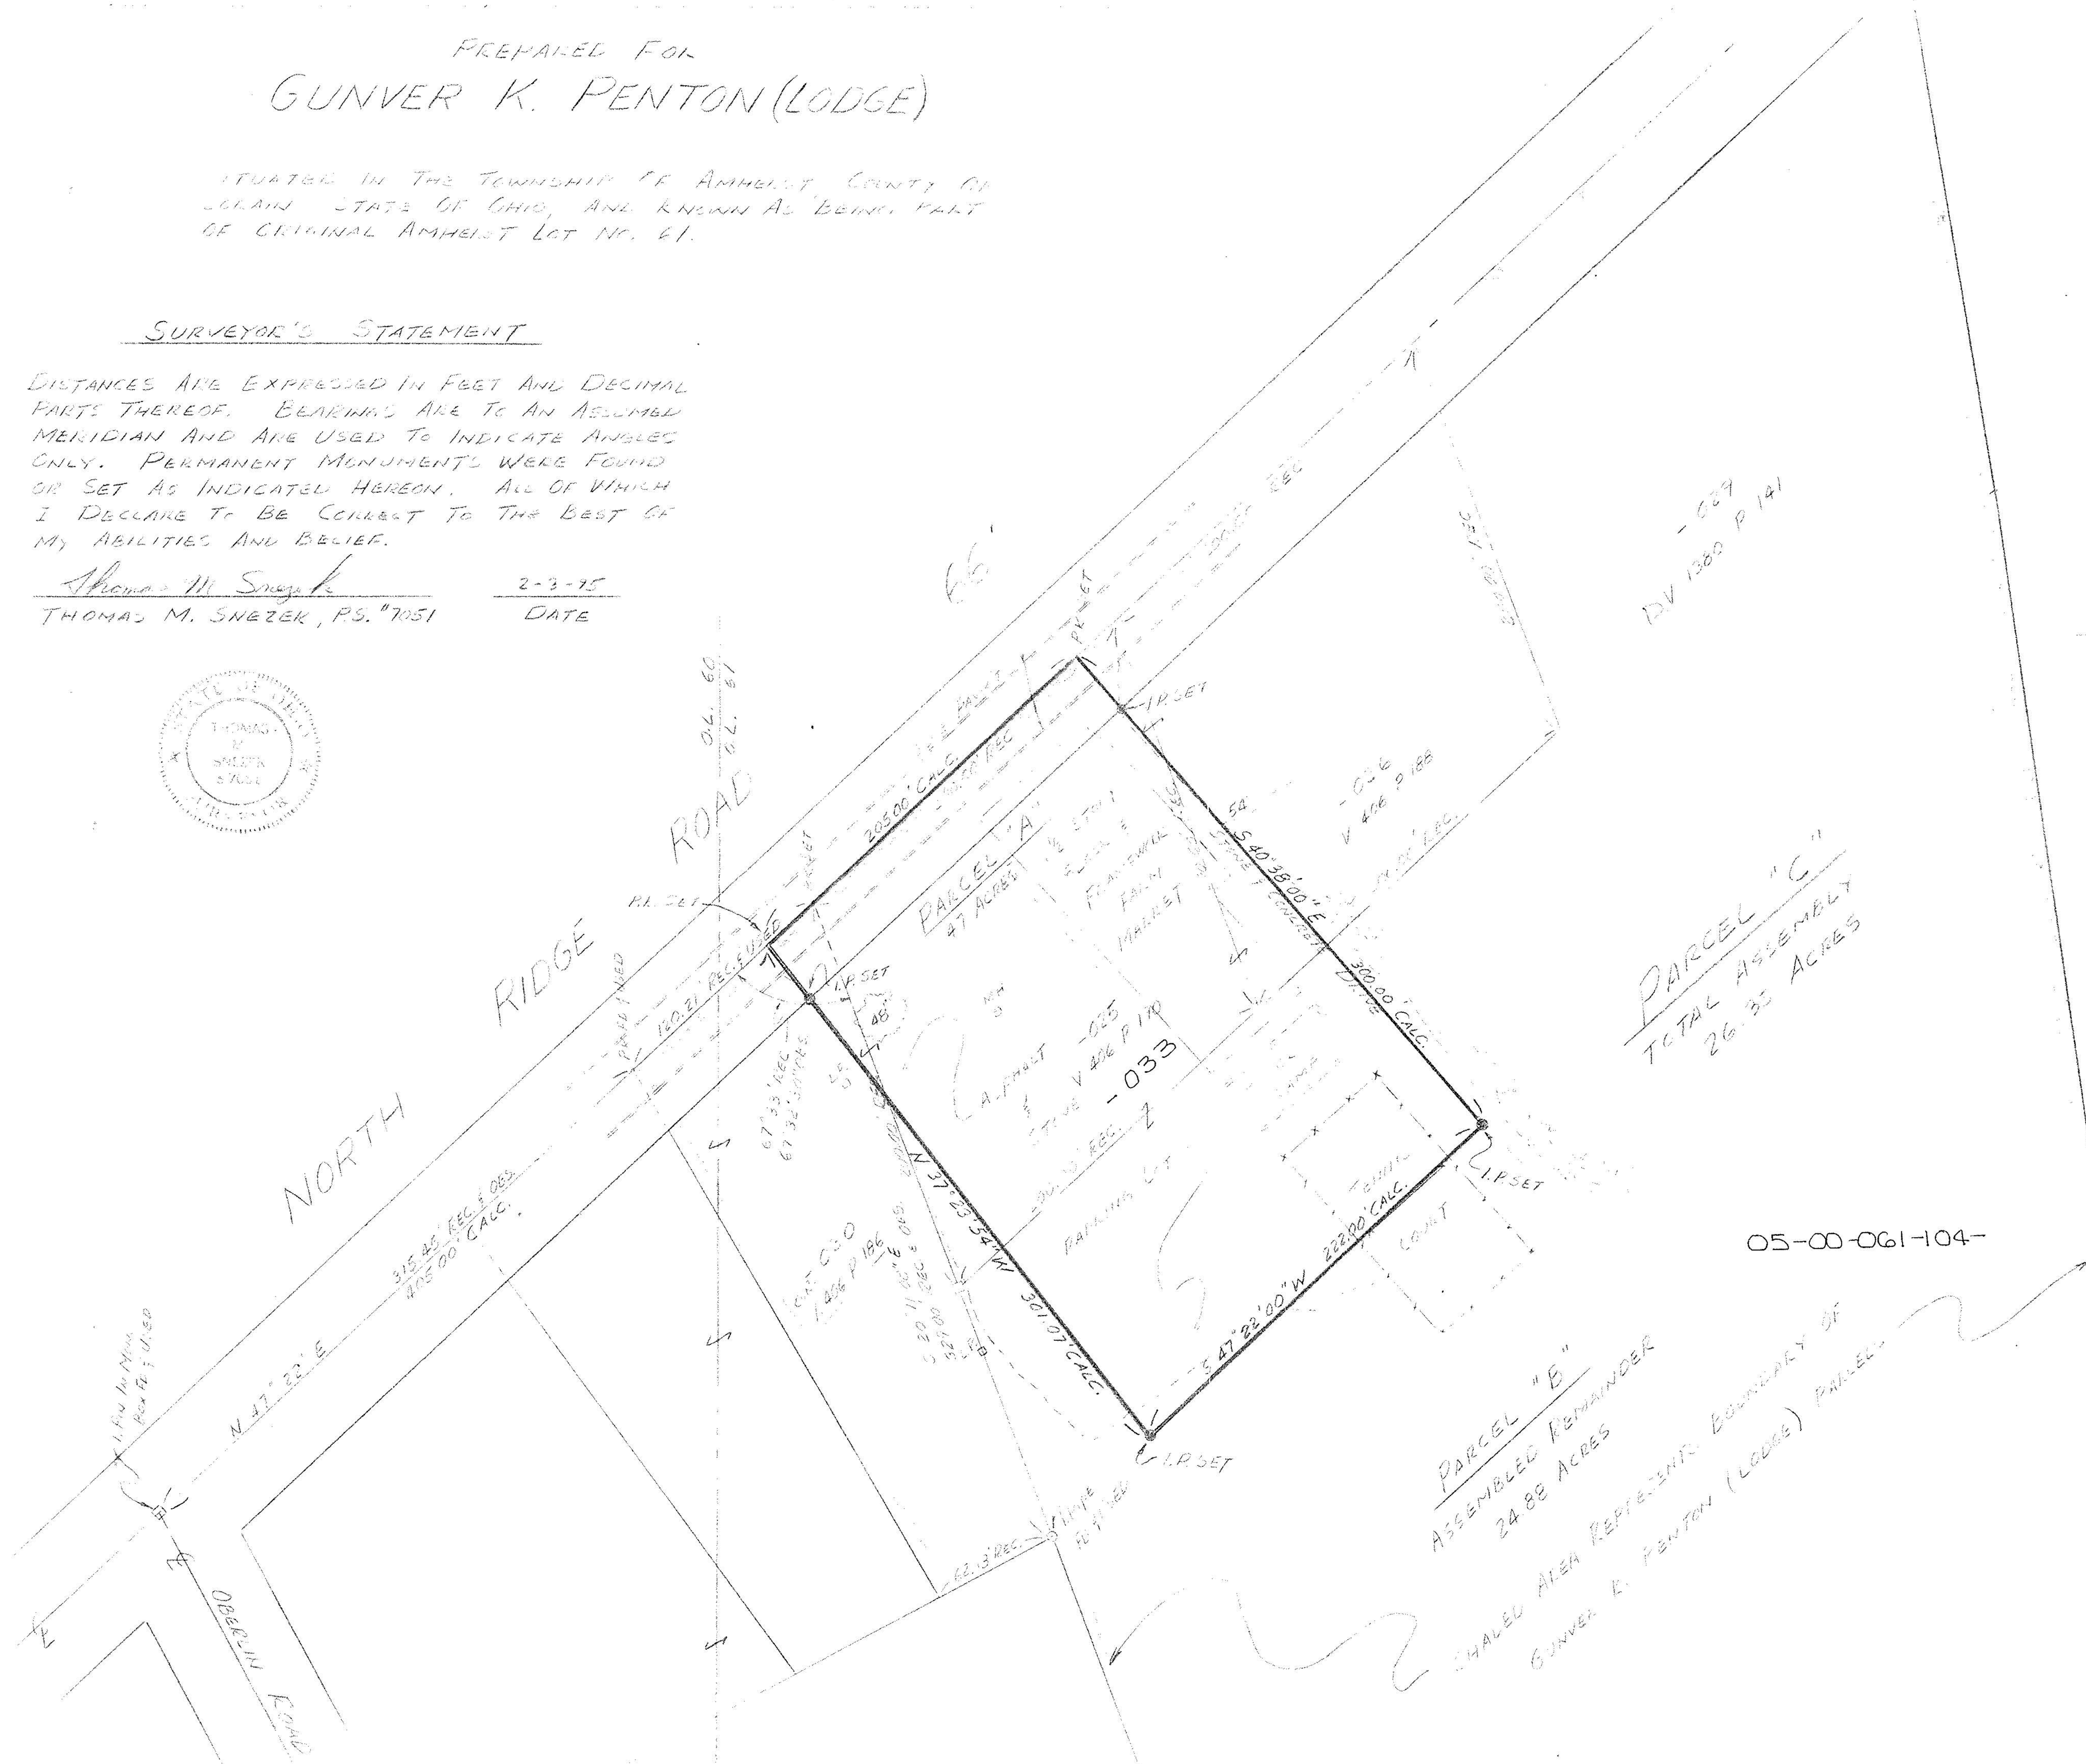

PARCEL "B"
 ASSEMBLED REMAINDER
 24.88 ACRES
 SHALED AREA REPRESENTS BOUNDARY OF
 GUNVER K. PENTON (LODGE) PARCELS