


SURVEY

CHARLES WIEGAND ESTATE

PART OF ORIGINAL LOTS 59 AND 60 AMHERST TWP. LORAIN CO., OHIO

JULY 1984
SCALE 1"=100

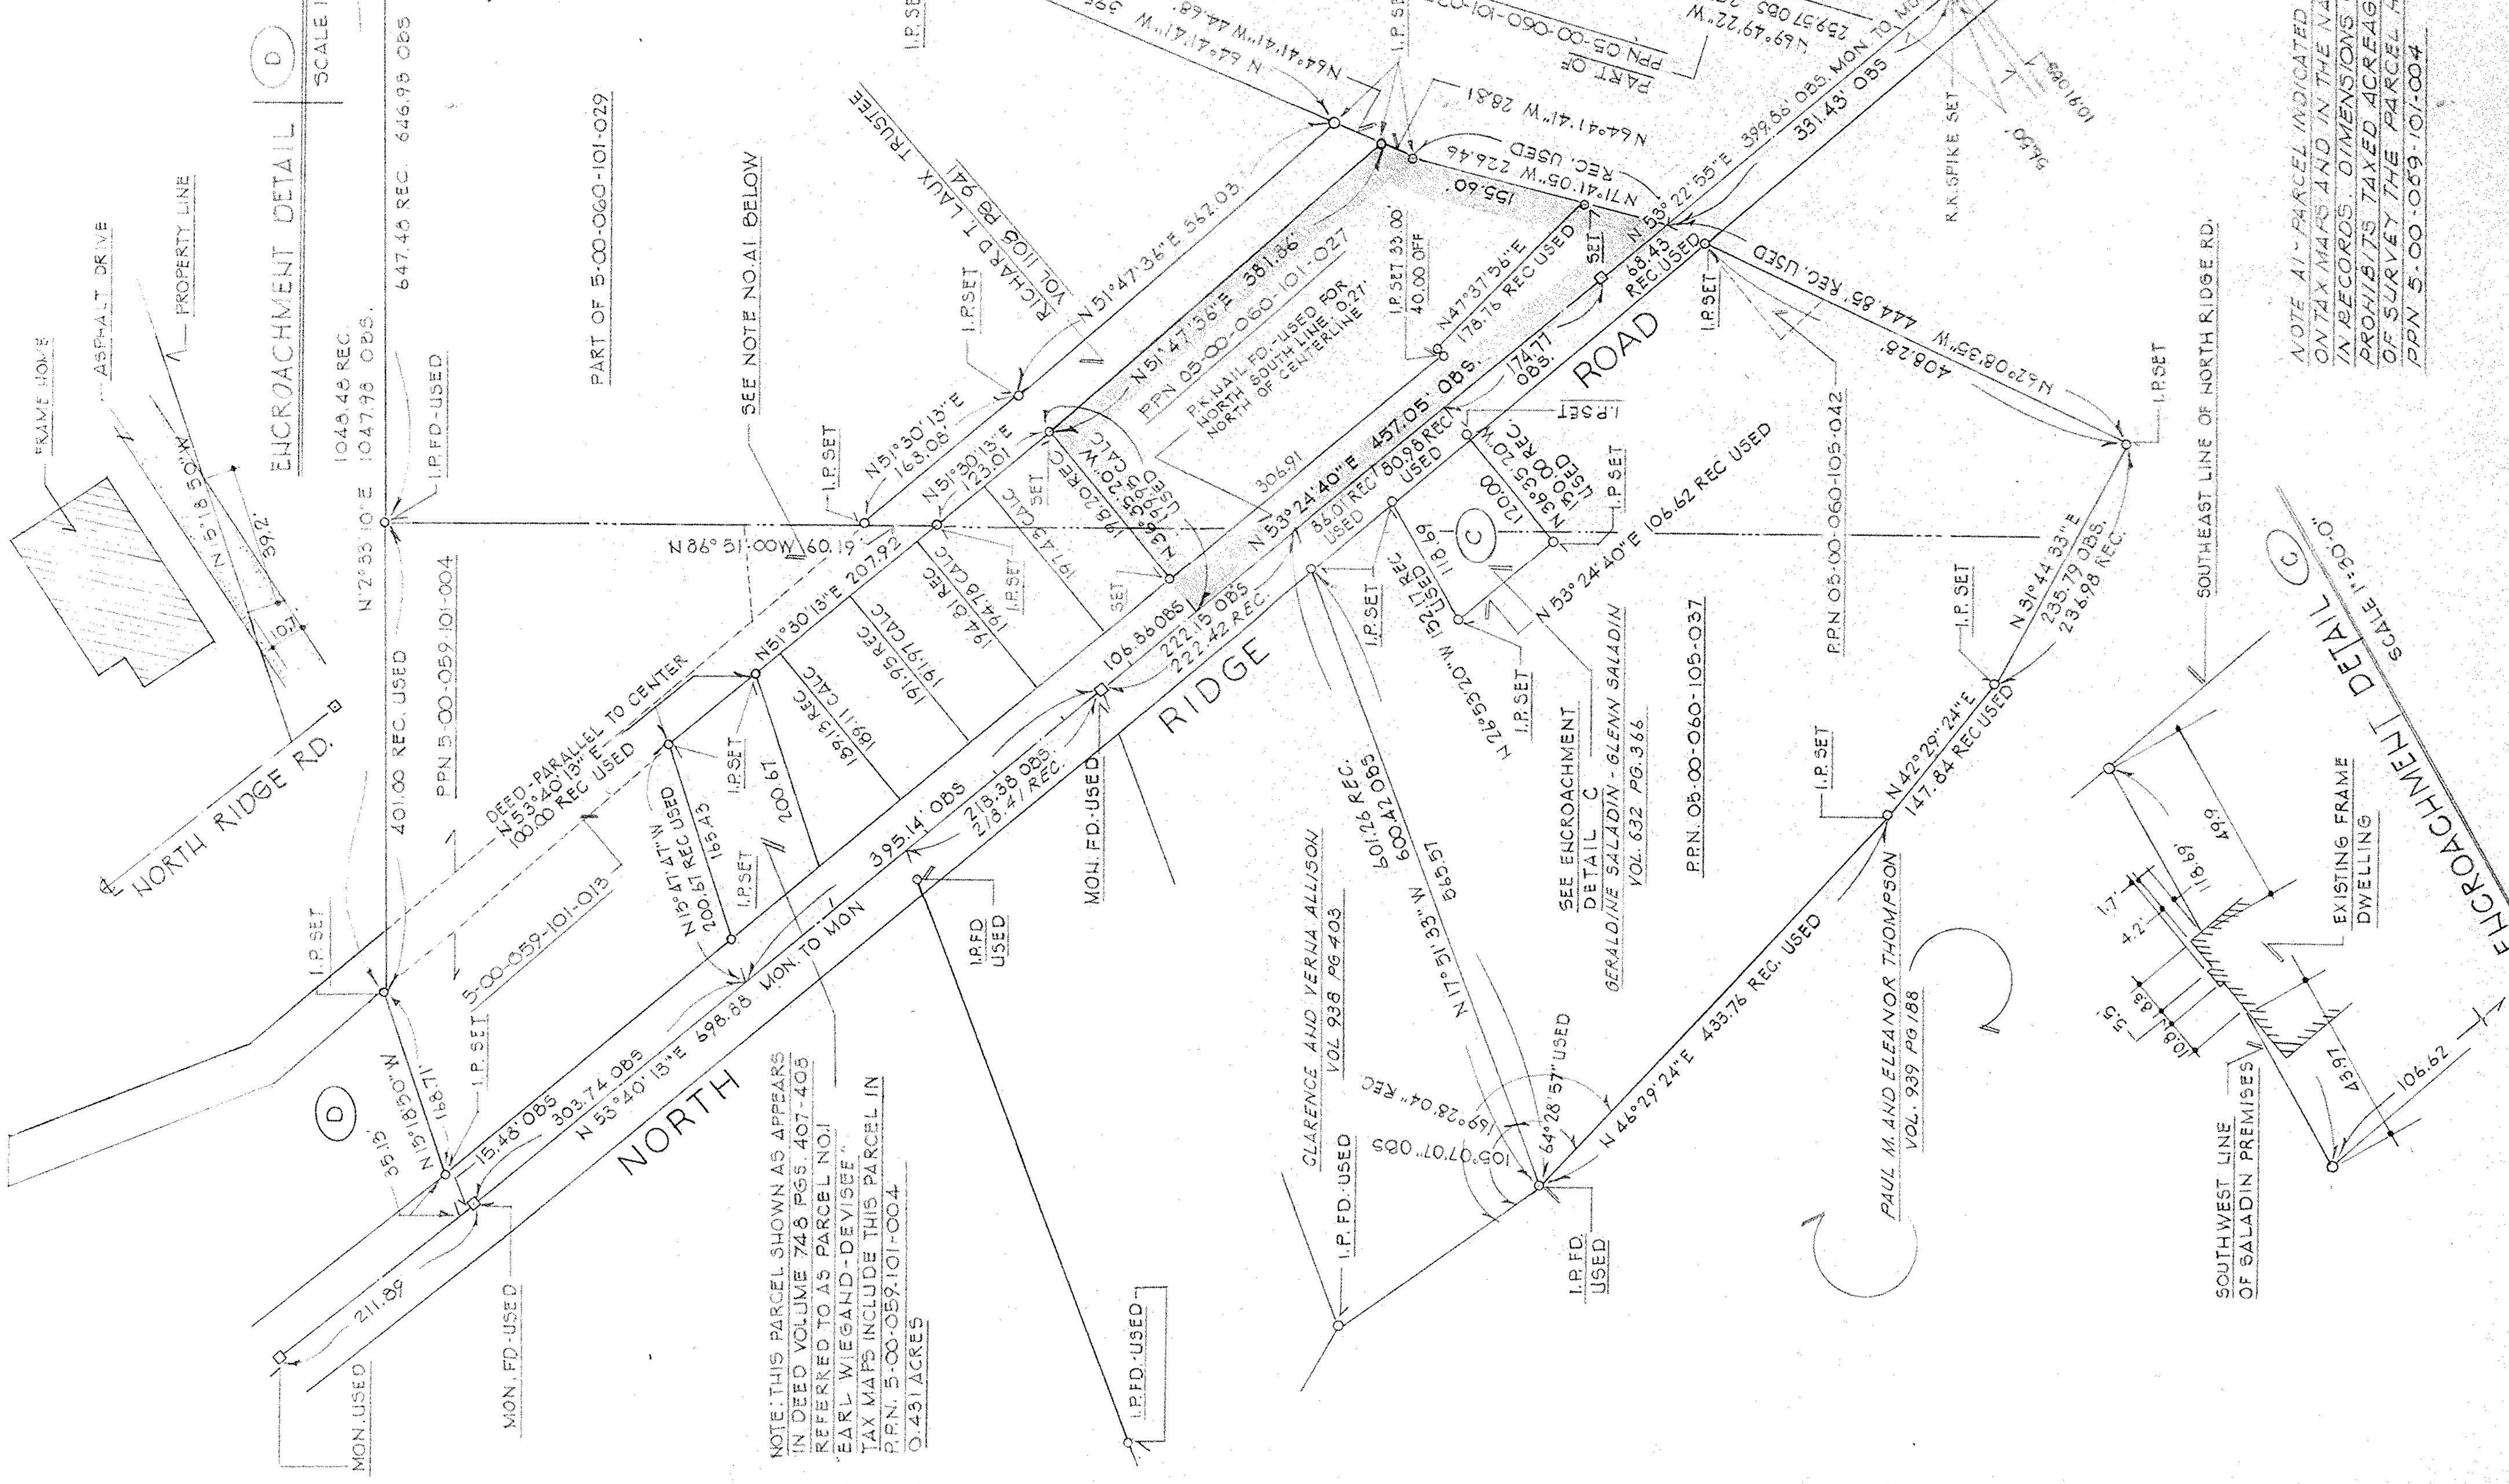

acreage tabulation by PPN

PPN	acres in OL	total by survey	tax map
05 00 060 105 037	4.536	2.210	6.746
05 00 060 105 042	0.062	0.062	0.04
05 00 059 101 004	3.111	3.111	3.17
05 00 059 101 013	0.54	0.54	0.55
05 00 060 101 029	49.887	49.887	54.03
05 00 060 101 027	0.10	3.097	3.00

acreage tabulation by contiguous PPN

parcel	acres	01 59	01 60
north of 190	42.294		
05 00 060 101 029	7.985		
north of tax trustee	3.651	3.651	
05 00 059 101 013	6.808	4.536	2.272
05 00 060 105 037	2.138	0.10	2.038
05 00 060 105 042	0.668		0.668
05 00 060 101 027			
south of 190			

PART OF 5'-00" 060-101-029

NOTE: THIS PARCEL SHOWN AS APPEARS IN DEED VOLUME 748 PGS. 401-403 REFERRED TO AS PARCEL NO. 1 EARL WIEGAND-DEVISEE. TAX MAPS INCLUDE THIS PARCEL IN PPN: 5-00-059-101-004 0.431 ACRES

NOTE: THIS PARCEL INDICATED AND SHOWN AS PPN 05-00-059-101-006 ON TAX MAPS AND IN THE NAME OF EARL WIEGAND. NO DEED IN RECORDS. DIMENSIONS OF PARCEL AS SHOWN ON TAX MAP PROHIBITS TAYED ACREAGE TO 0.45 ACRES. FOR PURPOSES OF SURVEY THE PARCEL HAS BEEN INCLUDED IN PPN 5-00-059-101-004

ENCROACHMENT DETAIL A
SCALE 1"=60'
PPN: 05-00-060-101-028

ENCROACHMENT DETAIL B
SCALE 1"=60'
PPN: 05-00-060-101-012

ENCROACHMENT DETAIL C
SCALE 1"=30'

norman hura and associates
SURV.

