



WEST RIDGE ROAD (60')

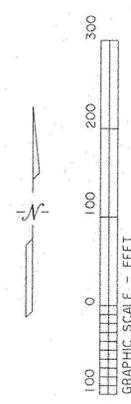

DIMENSIONS SHOWN ON THIS PLAT ARE EXPRESSED IN FEET AND DECIMAL PARTS THEREOF. ALL BEARINGS ARE TO AN ASSUMED MERIDIAN AND ARE USED TO INDICATE ANGLES ONLY. PERMANENT MONUMENTS WERE FOUND OR SET AT ALL POINTS INDICATED HEREON, ALL OF WHICH I CERTIFY TO BE CORRECT.

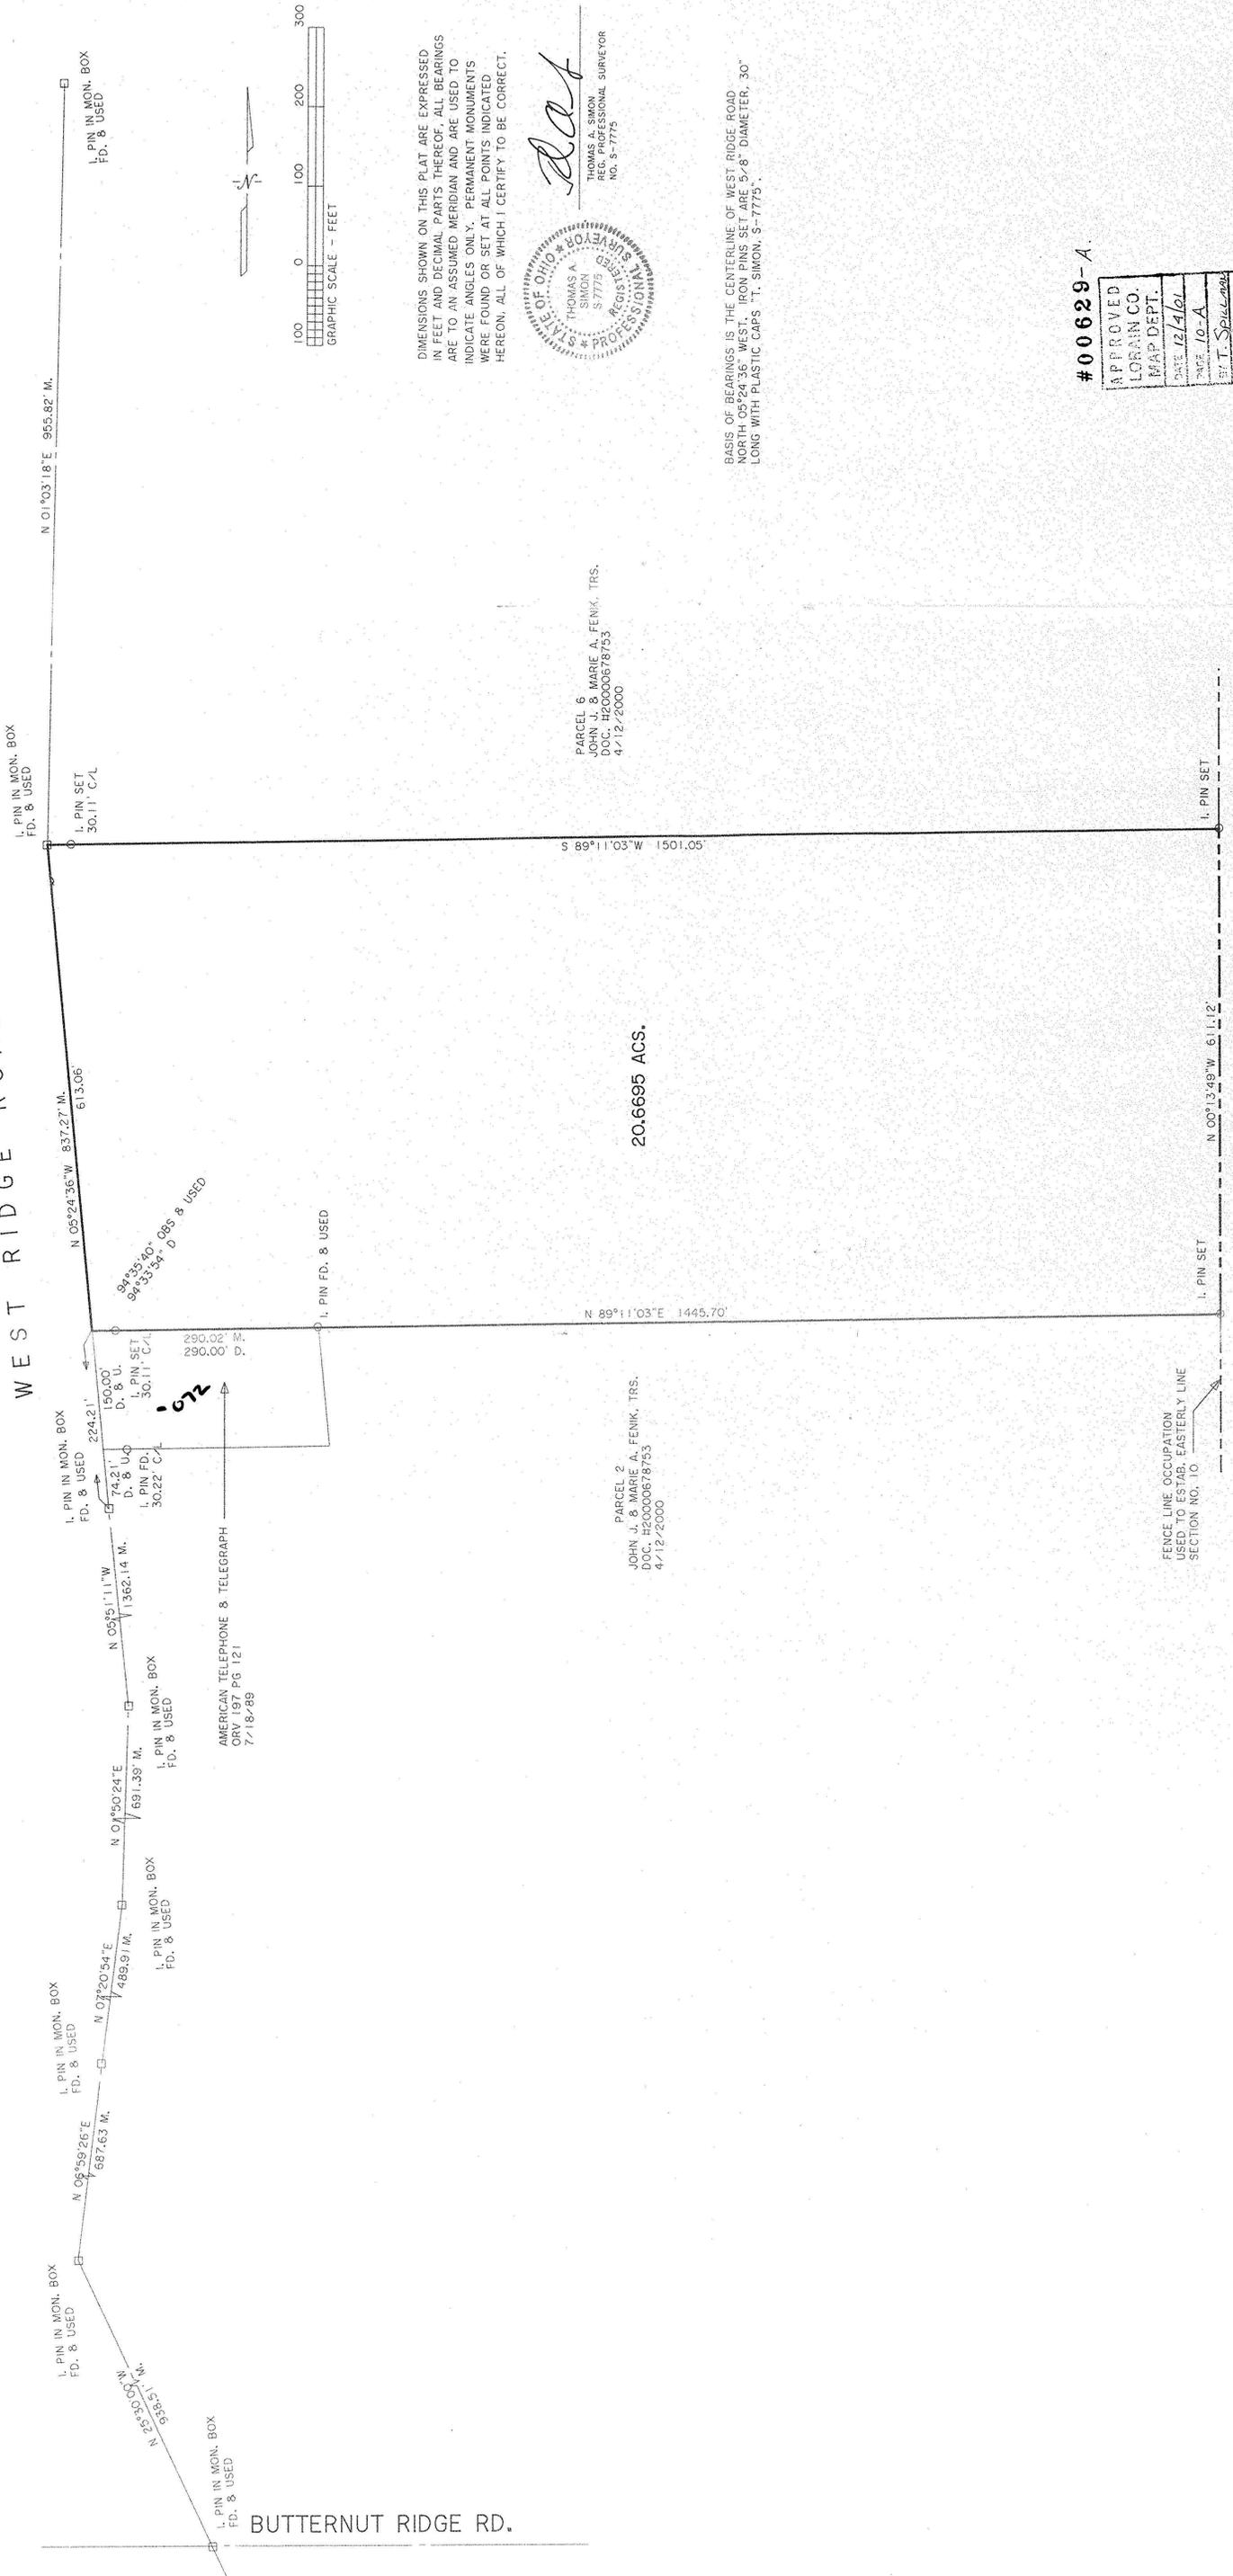

PARCEL 6
JOHN J. & MARIE A. FENIK, TRS.
DOC. H20000678753
4/12/2000

20.6695 ACS.

PARCEL 2
JOHN J. & MARIE A. FENIK, TRS.
DOC. H20000678753
4/12/2000

BASIS OF BEARINGS IS THE CENTERLINE OF WEST RIDGE ROAD NORTH 05°24'36" WEST, IRON PINS SET ARE 5'-8" DIAMETER, 30" LONG WITH PLASTIC CAPS "T. SIMON, S-7775"

#00629-A

APPROVED
LORAIN CO. MAP DEPT.
DATE 12/4/01
BY T. SPILLMAN
MAP # 00629-A

PLAT OF SURVEY

FOR
LAURA KLINECT TRUST
ROGER A. KLINECT, SUCCESSOR TRUSTEE

BEING KNOWN AS PART OF ORIGINAL CARLISLE TOWNSHIP SECTION NO. 10 COUNTY OF LORAIN STATE OF OHIO OCTOBER, 2001 SCALE: 1" = 100'

THOMAS SIMON & ASSOCIATES, INC.
PROFESSIONAL LAND SURVEYORS
CORALSTONE CORNER PROFESSIONAL CENTER
39049 CENTER RIDGE ROAD
NORTH RIDGEVILLE, OHIO 44039
TEL (440) 327-2825
FAX (440) 327-2964