PARCEL MAP

PART OF AMHERST TWP, ORIGINAL LOT 57

TOWNSHIP OF AMHERST COUNTY OF LORAIN

STATE OF OHIO

SCALE: 1" = 50'

FEBRUARY 19, 1987
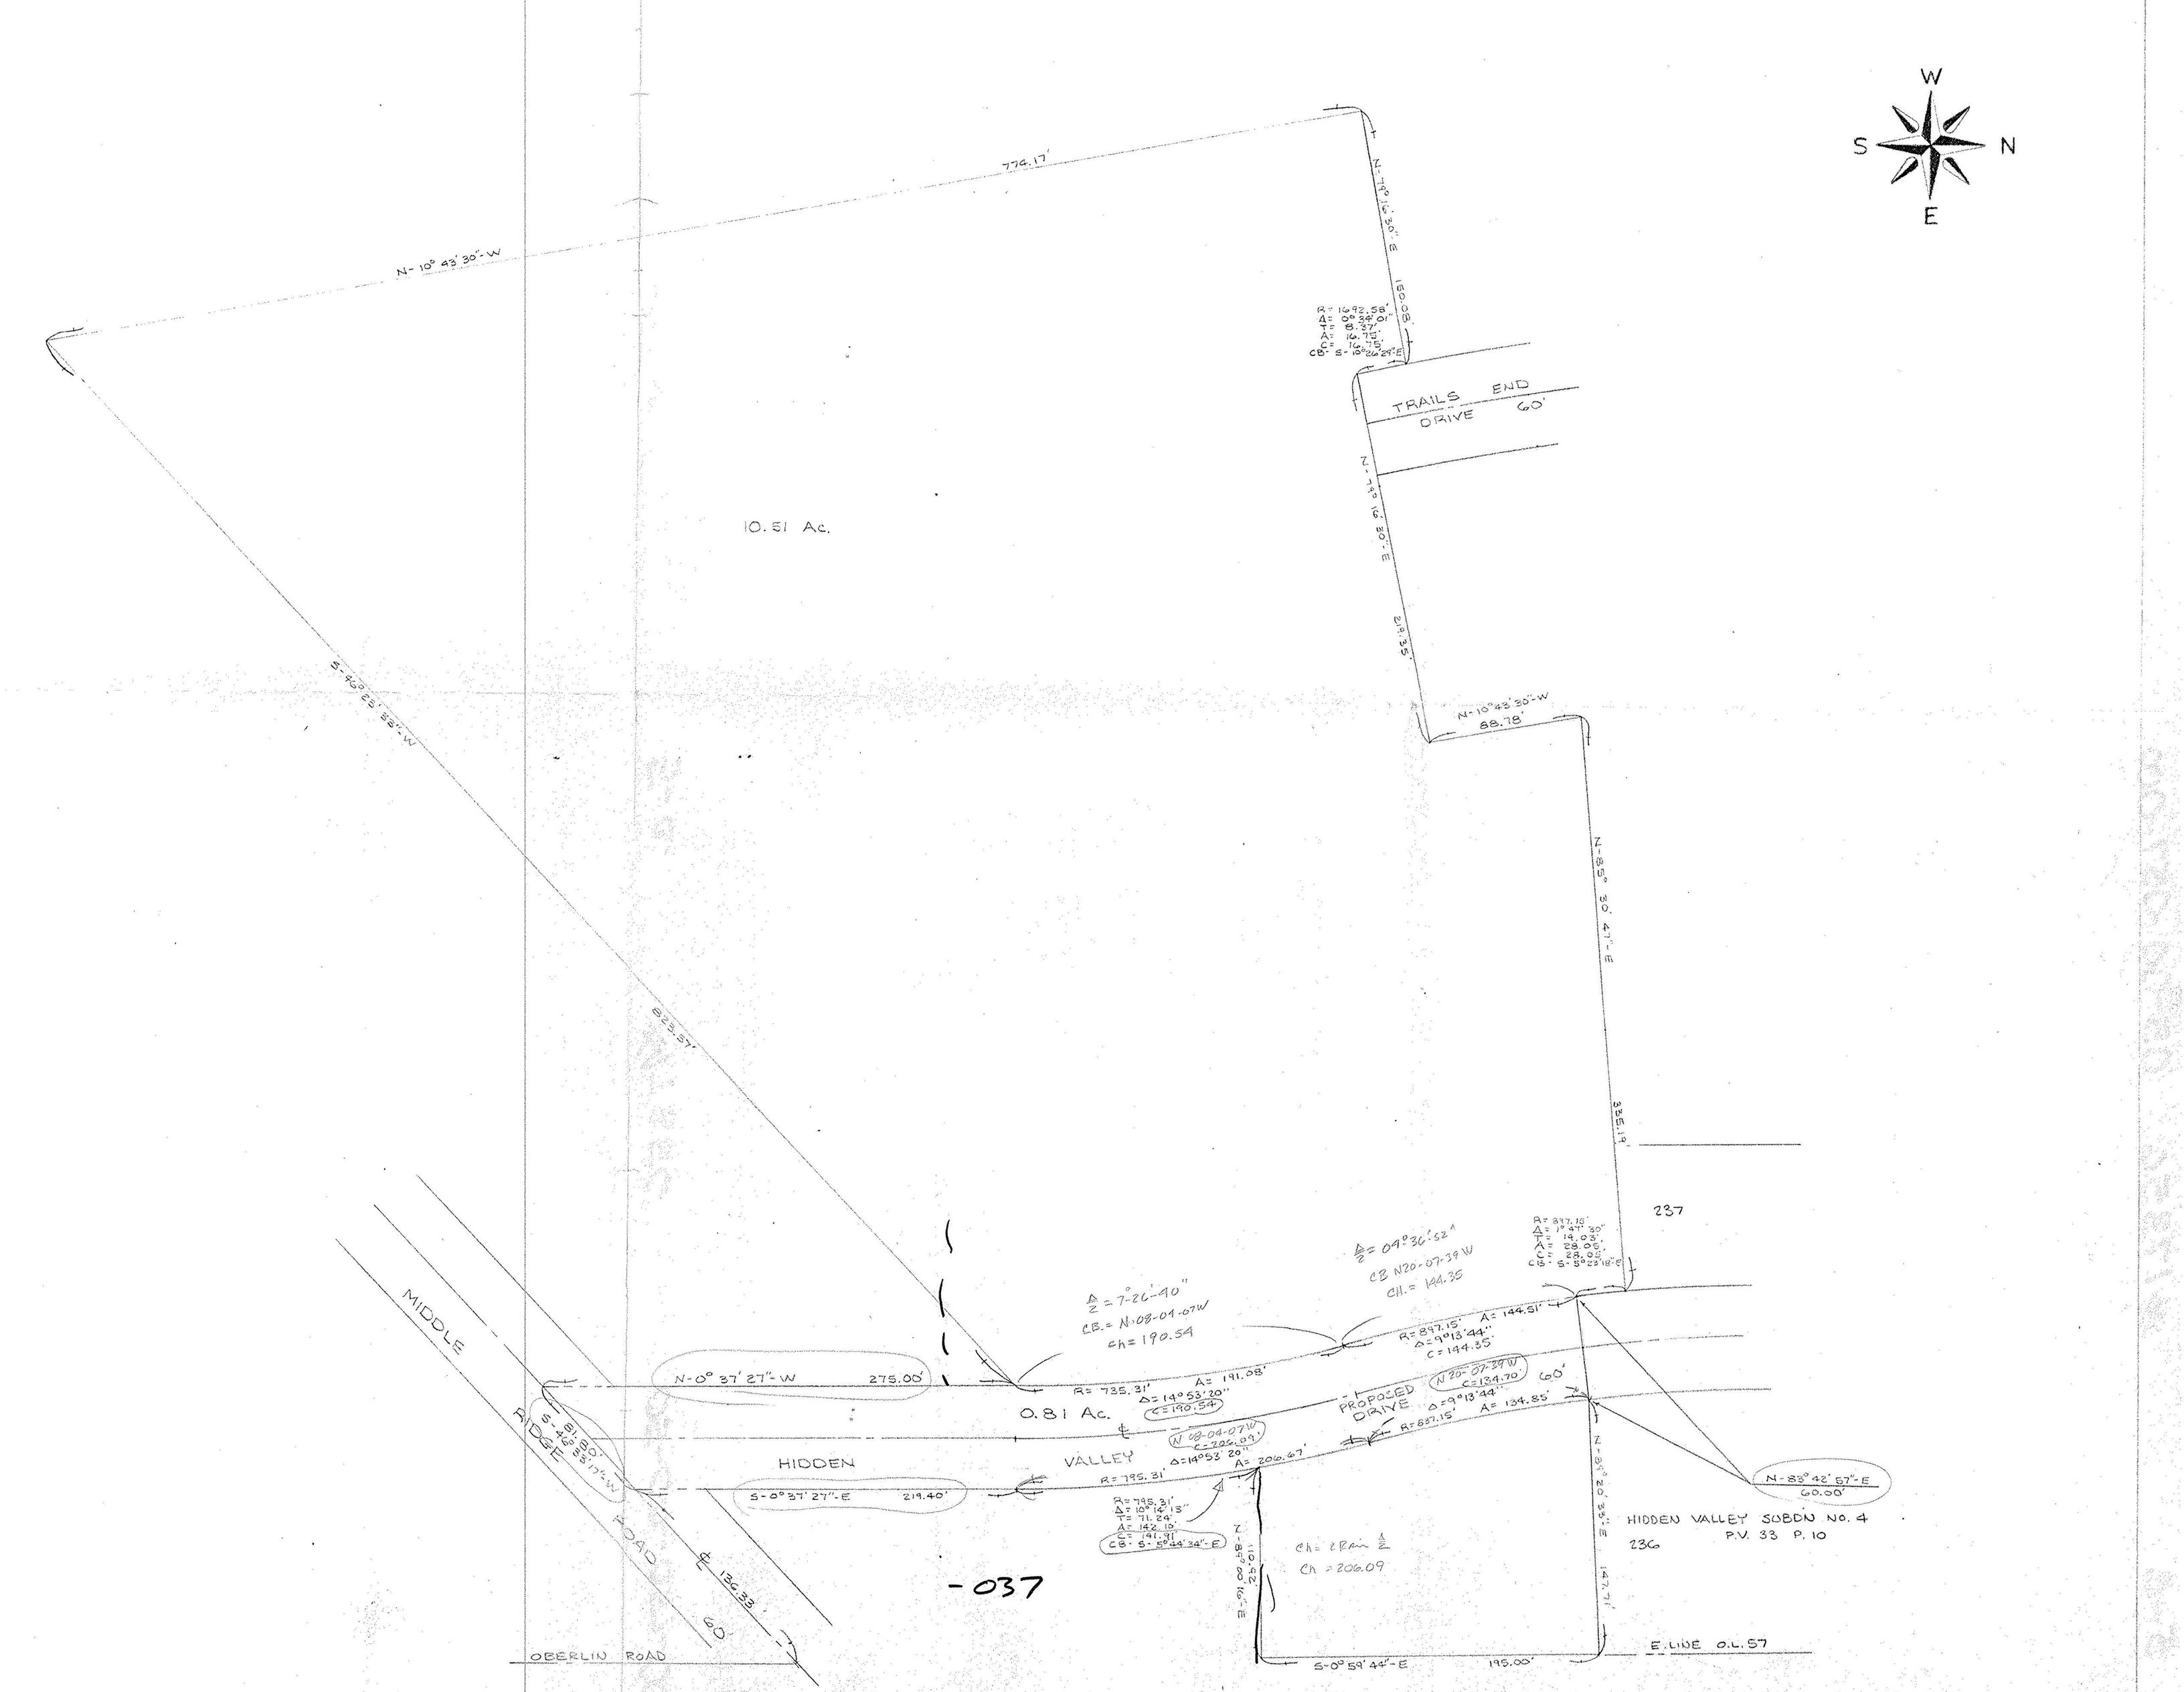
KLEINOEDER · SCHMIDT
and ASSOCIATES
ENGINEERS — SURVEYORS — CONSULTANTS in LAND PLANNING
ELYRIA OHIO