

I.P. SET IN OLD FENCE CORNER


N-79° 41' 30" W 479.63' OBS

12.943 ACRES

~~022~~ - 029
14.35A 12.94A

14.35
12.94

1.41A

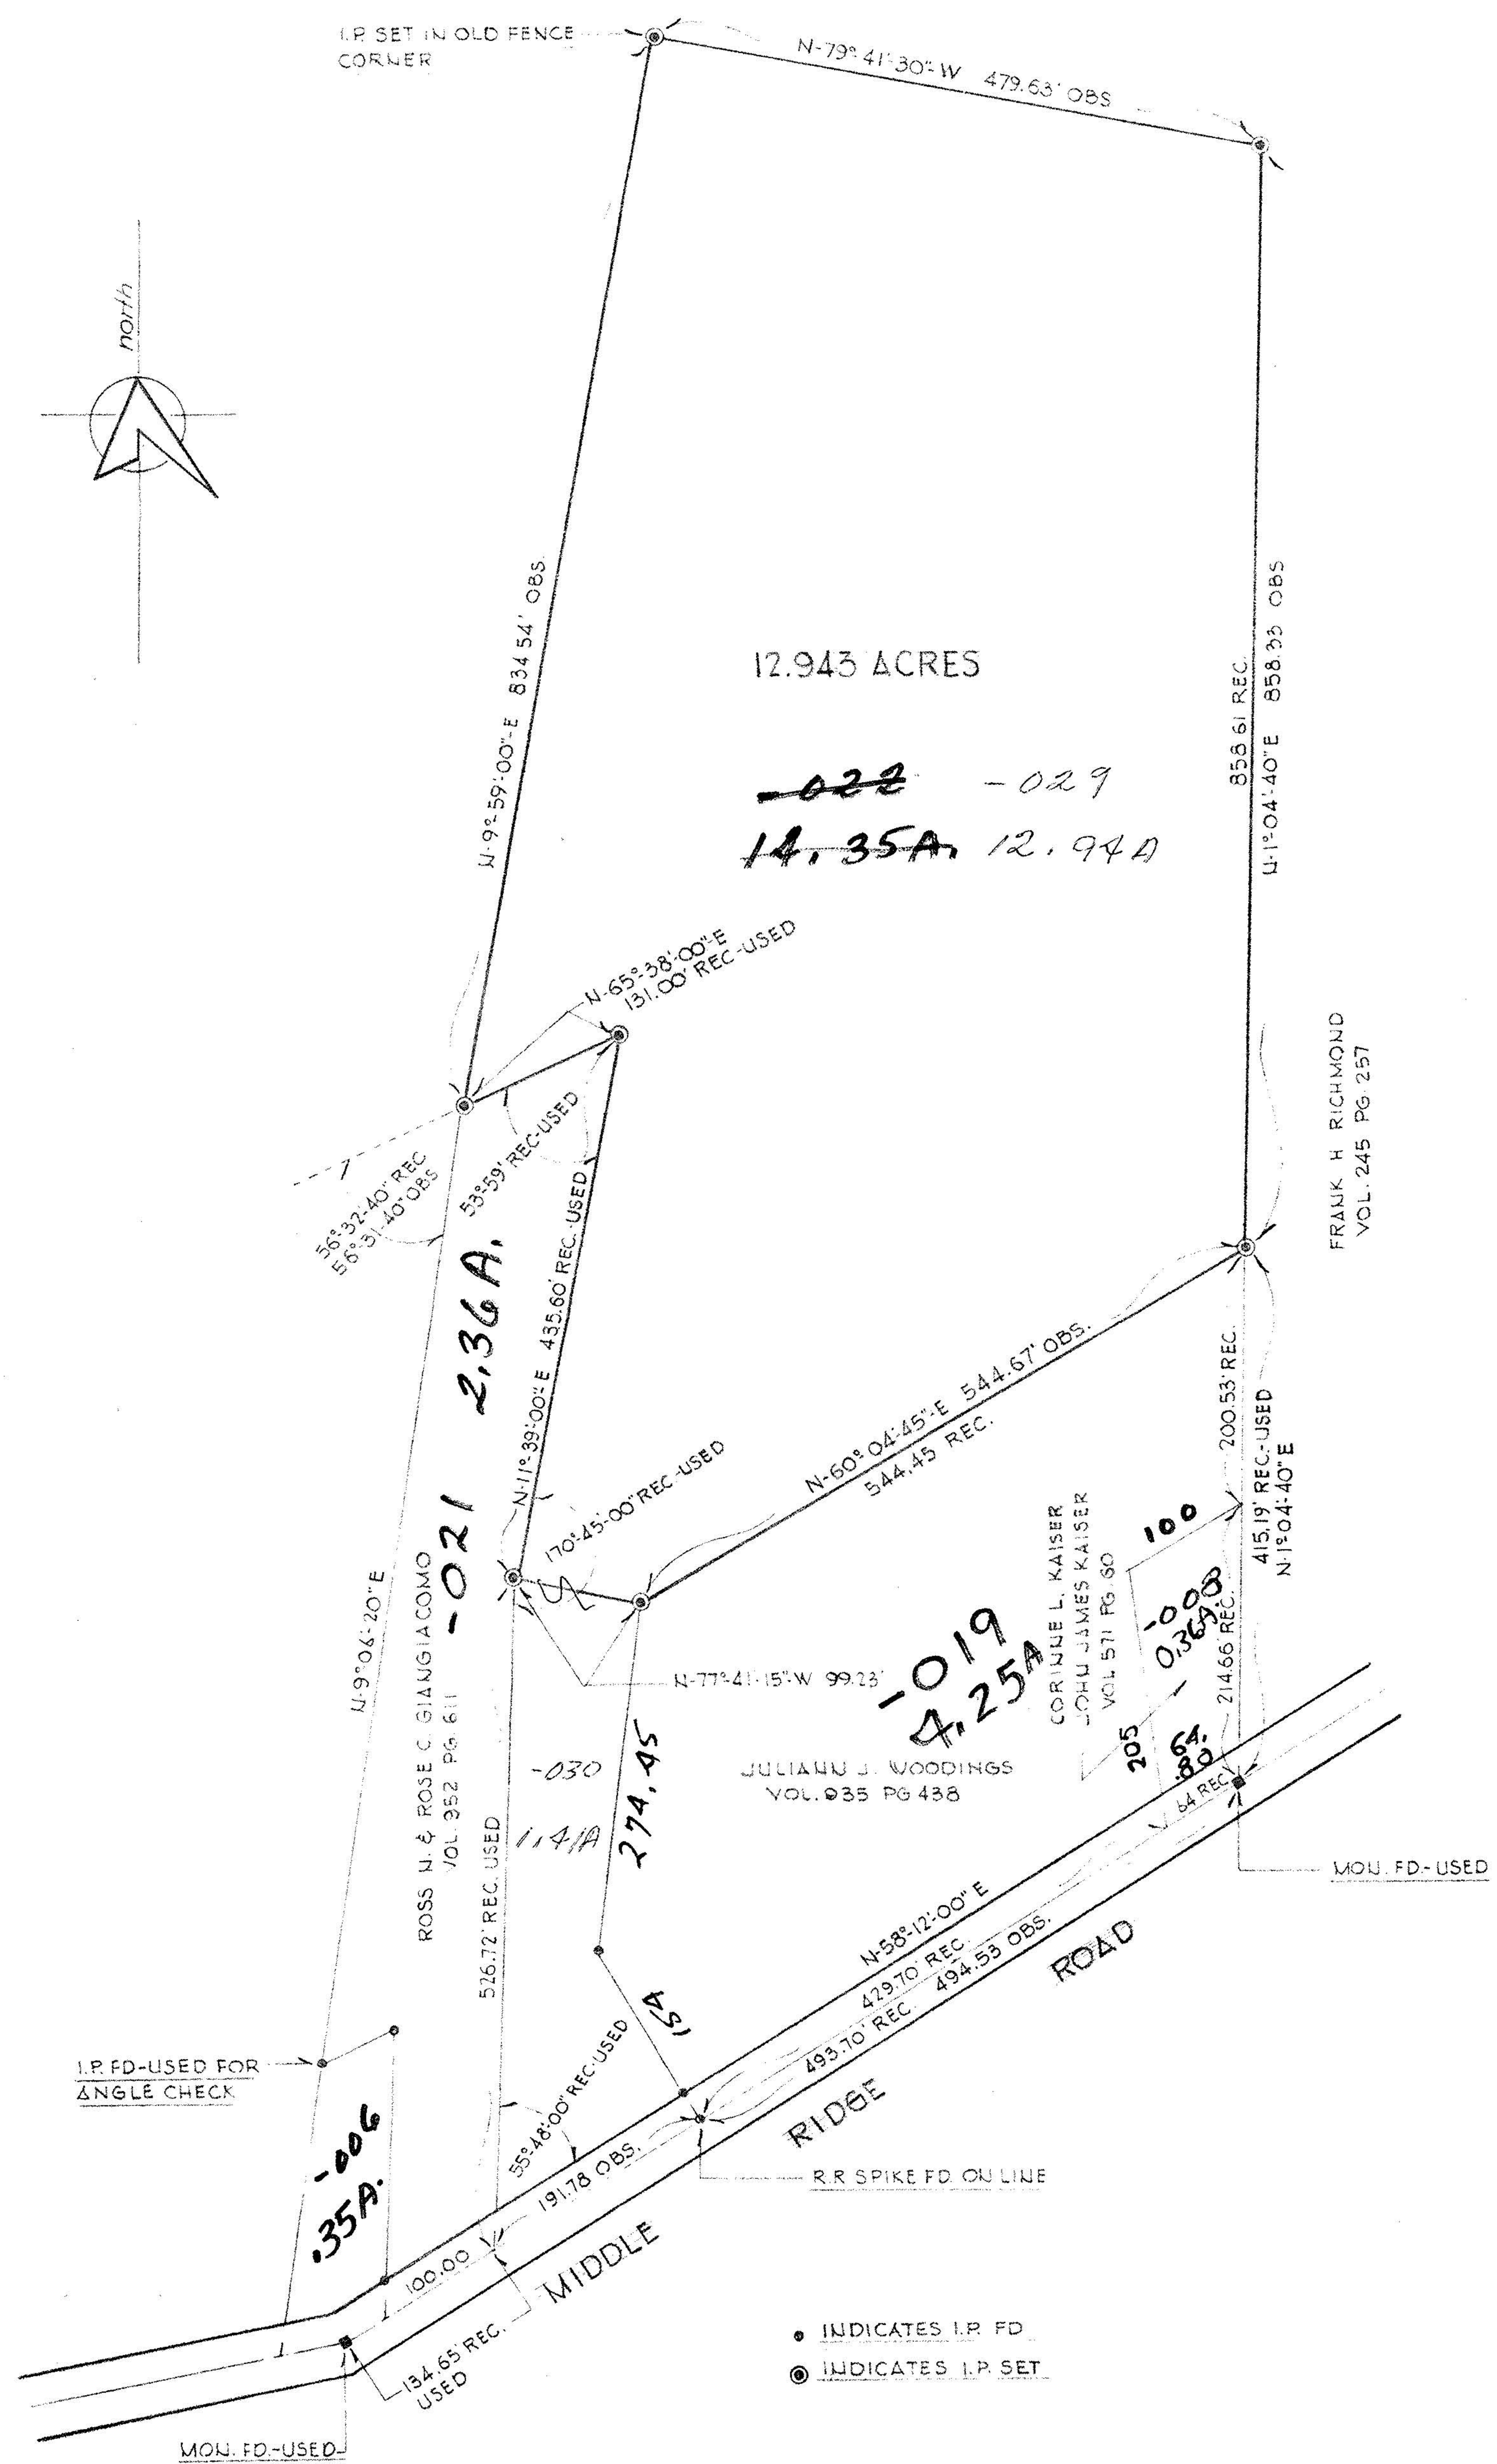

- INDICATES I.P. FD
- ⊙ INDICATES I.P. SET

SCALE 1" = 100'

