


DEWEY ROAD

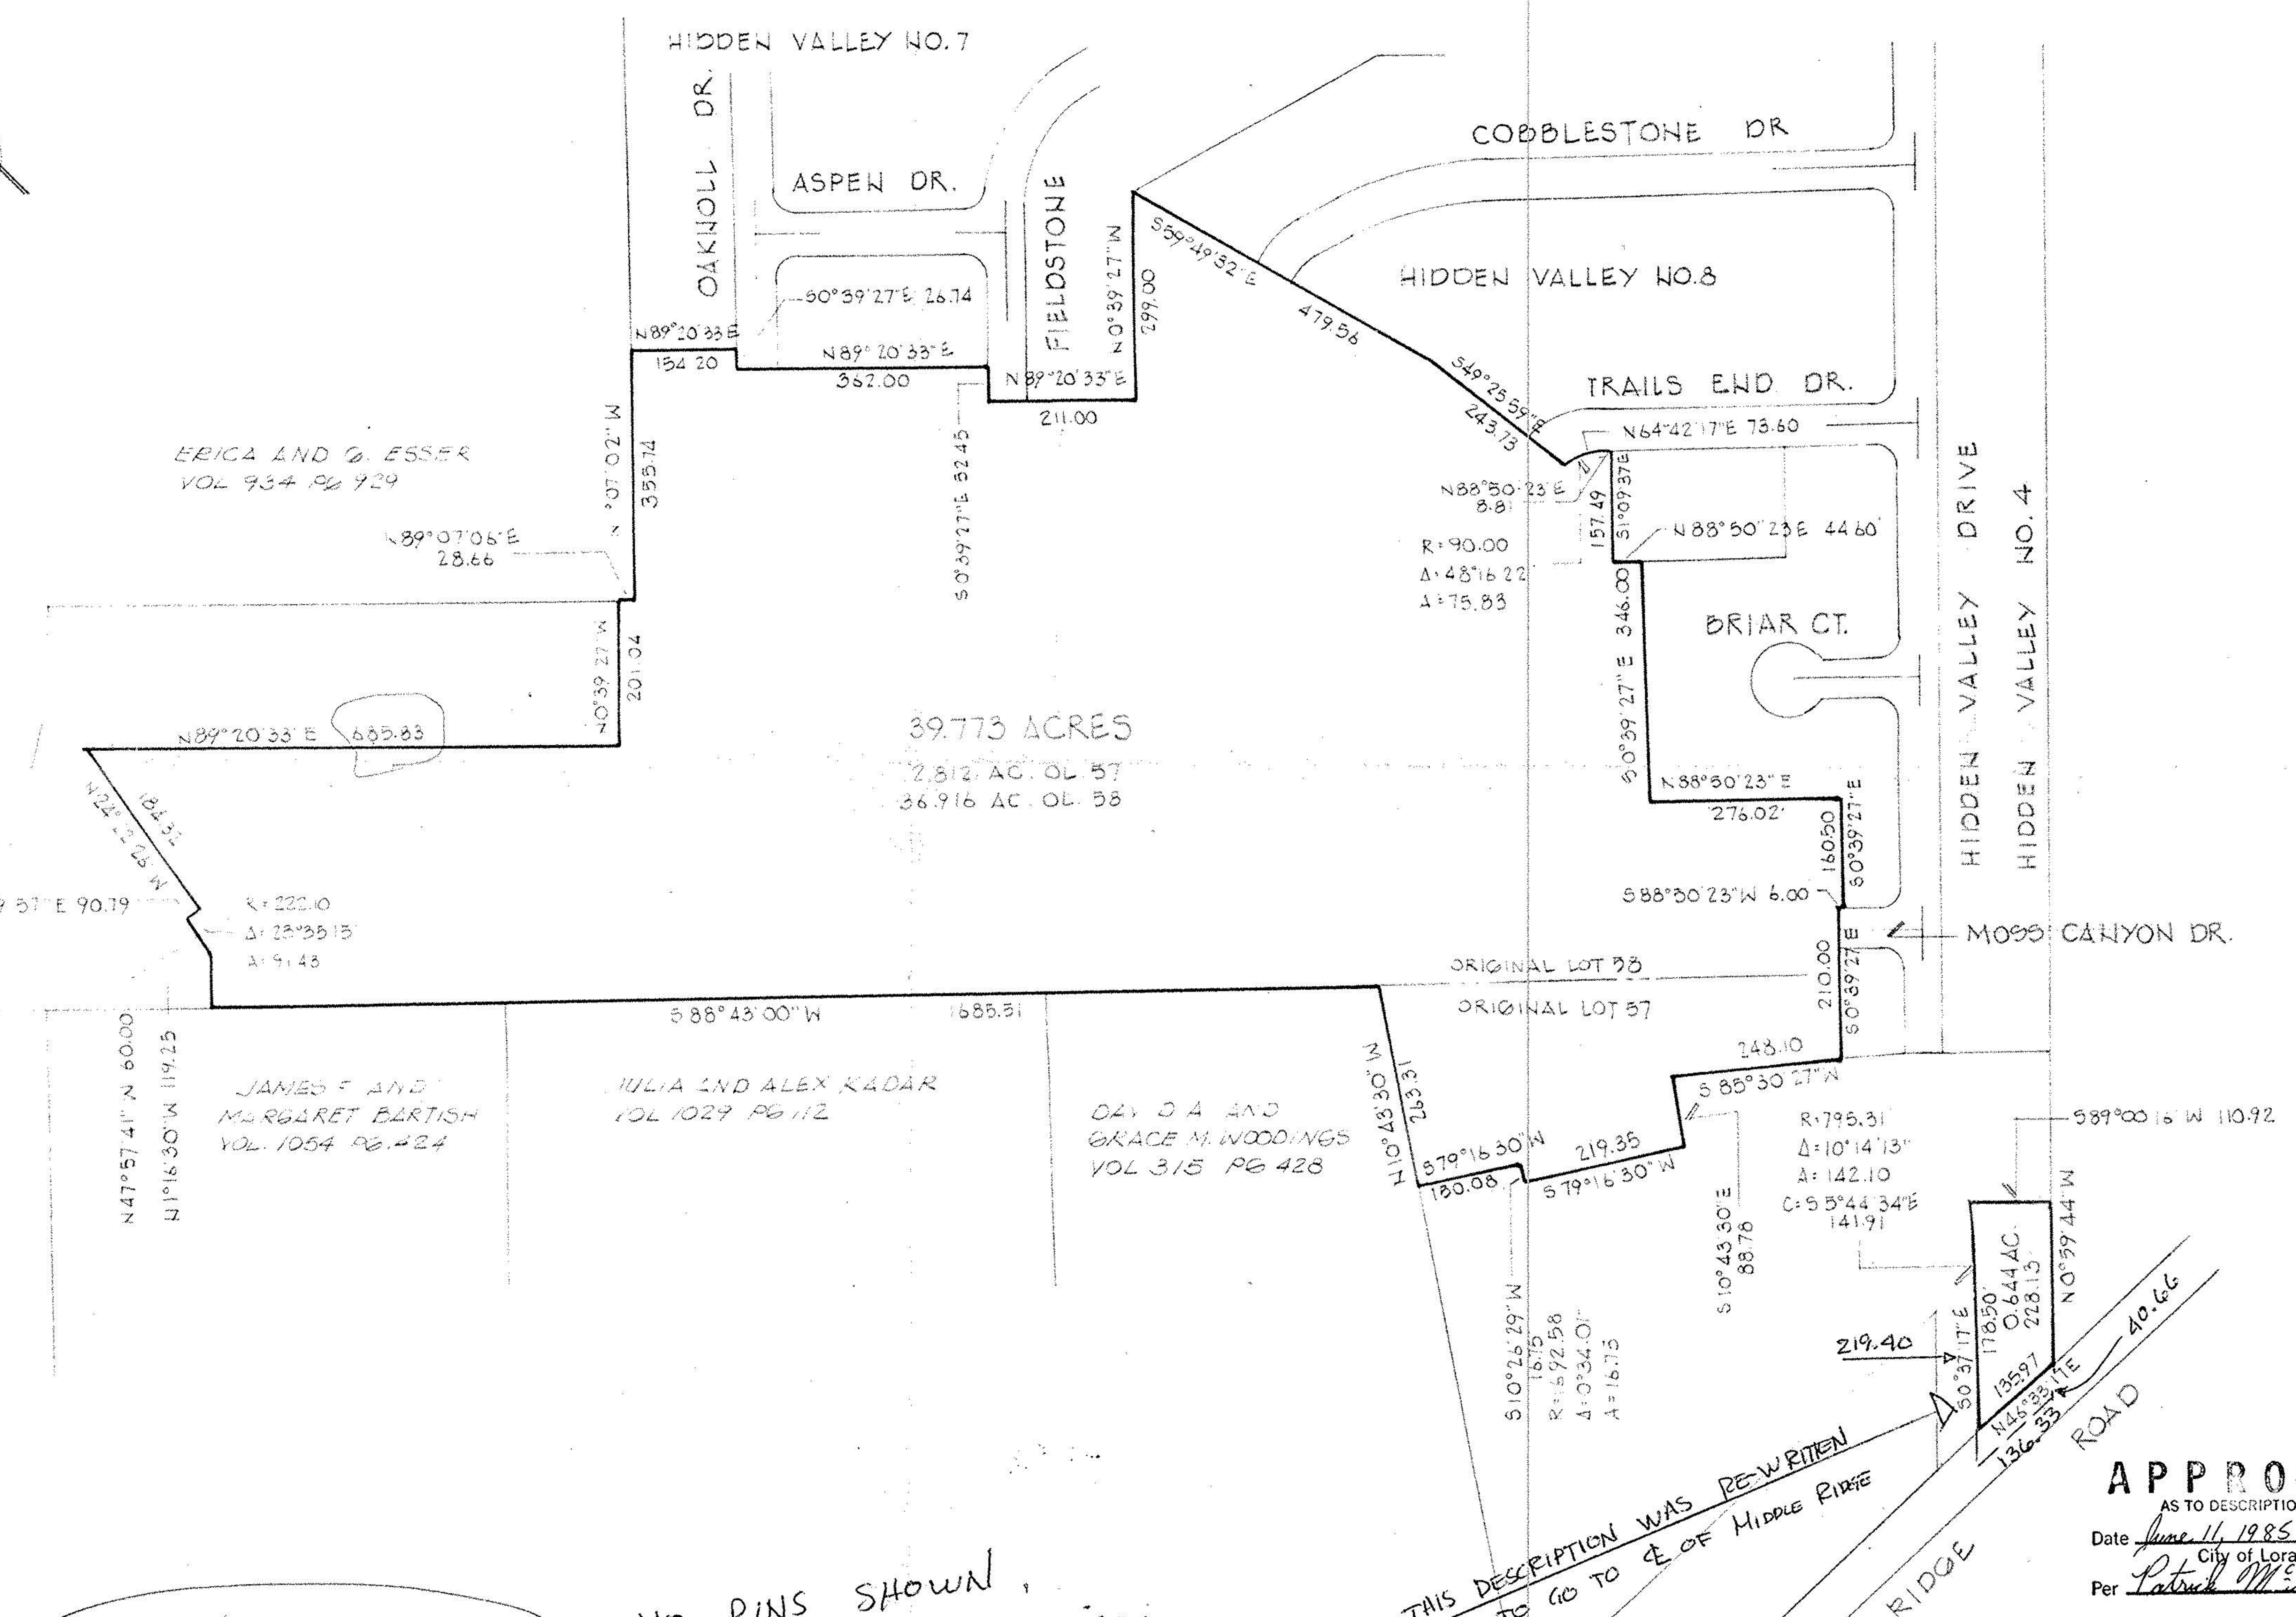

PROPOSED LOT SPLIT — No PINS SHOWN

PART OF ORIGINAL LOTS 57 AND 58
 AMHERST TOWNSHIP
 MAY 1985 SCALE 1" = 200'

APPROVED,
 LORAIN CO.
 MAP DEPT.
 DATE 7.1.85
 PAGE 500.058.A & B
 BY T. McNeil

THIS DESCRIPTION WAS RE-WRITTEN
 TO GO TO E OF MIDDLE RIDGE

APPROVED BY THE LORAIN CITY PLANNING
 COMMISSION 6/12/85. NO PLAT REQUIRED
 SECRETARY LORAIN CITY PLANNING COMMISSION

APPROVED
 AS TO DESCRIPTION ONLY
 Date June 11, 1985
 City of Lorain
 Per Patrick M. Shannon
 Engineering Dept.

