


#18820 05-00-057-000-119  
#18820 05-00-057-000-119  
#18820 05-00-057-000-119

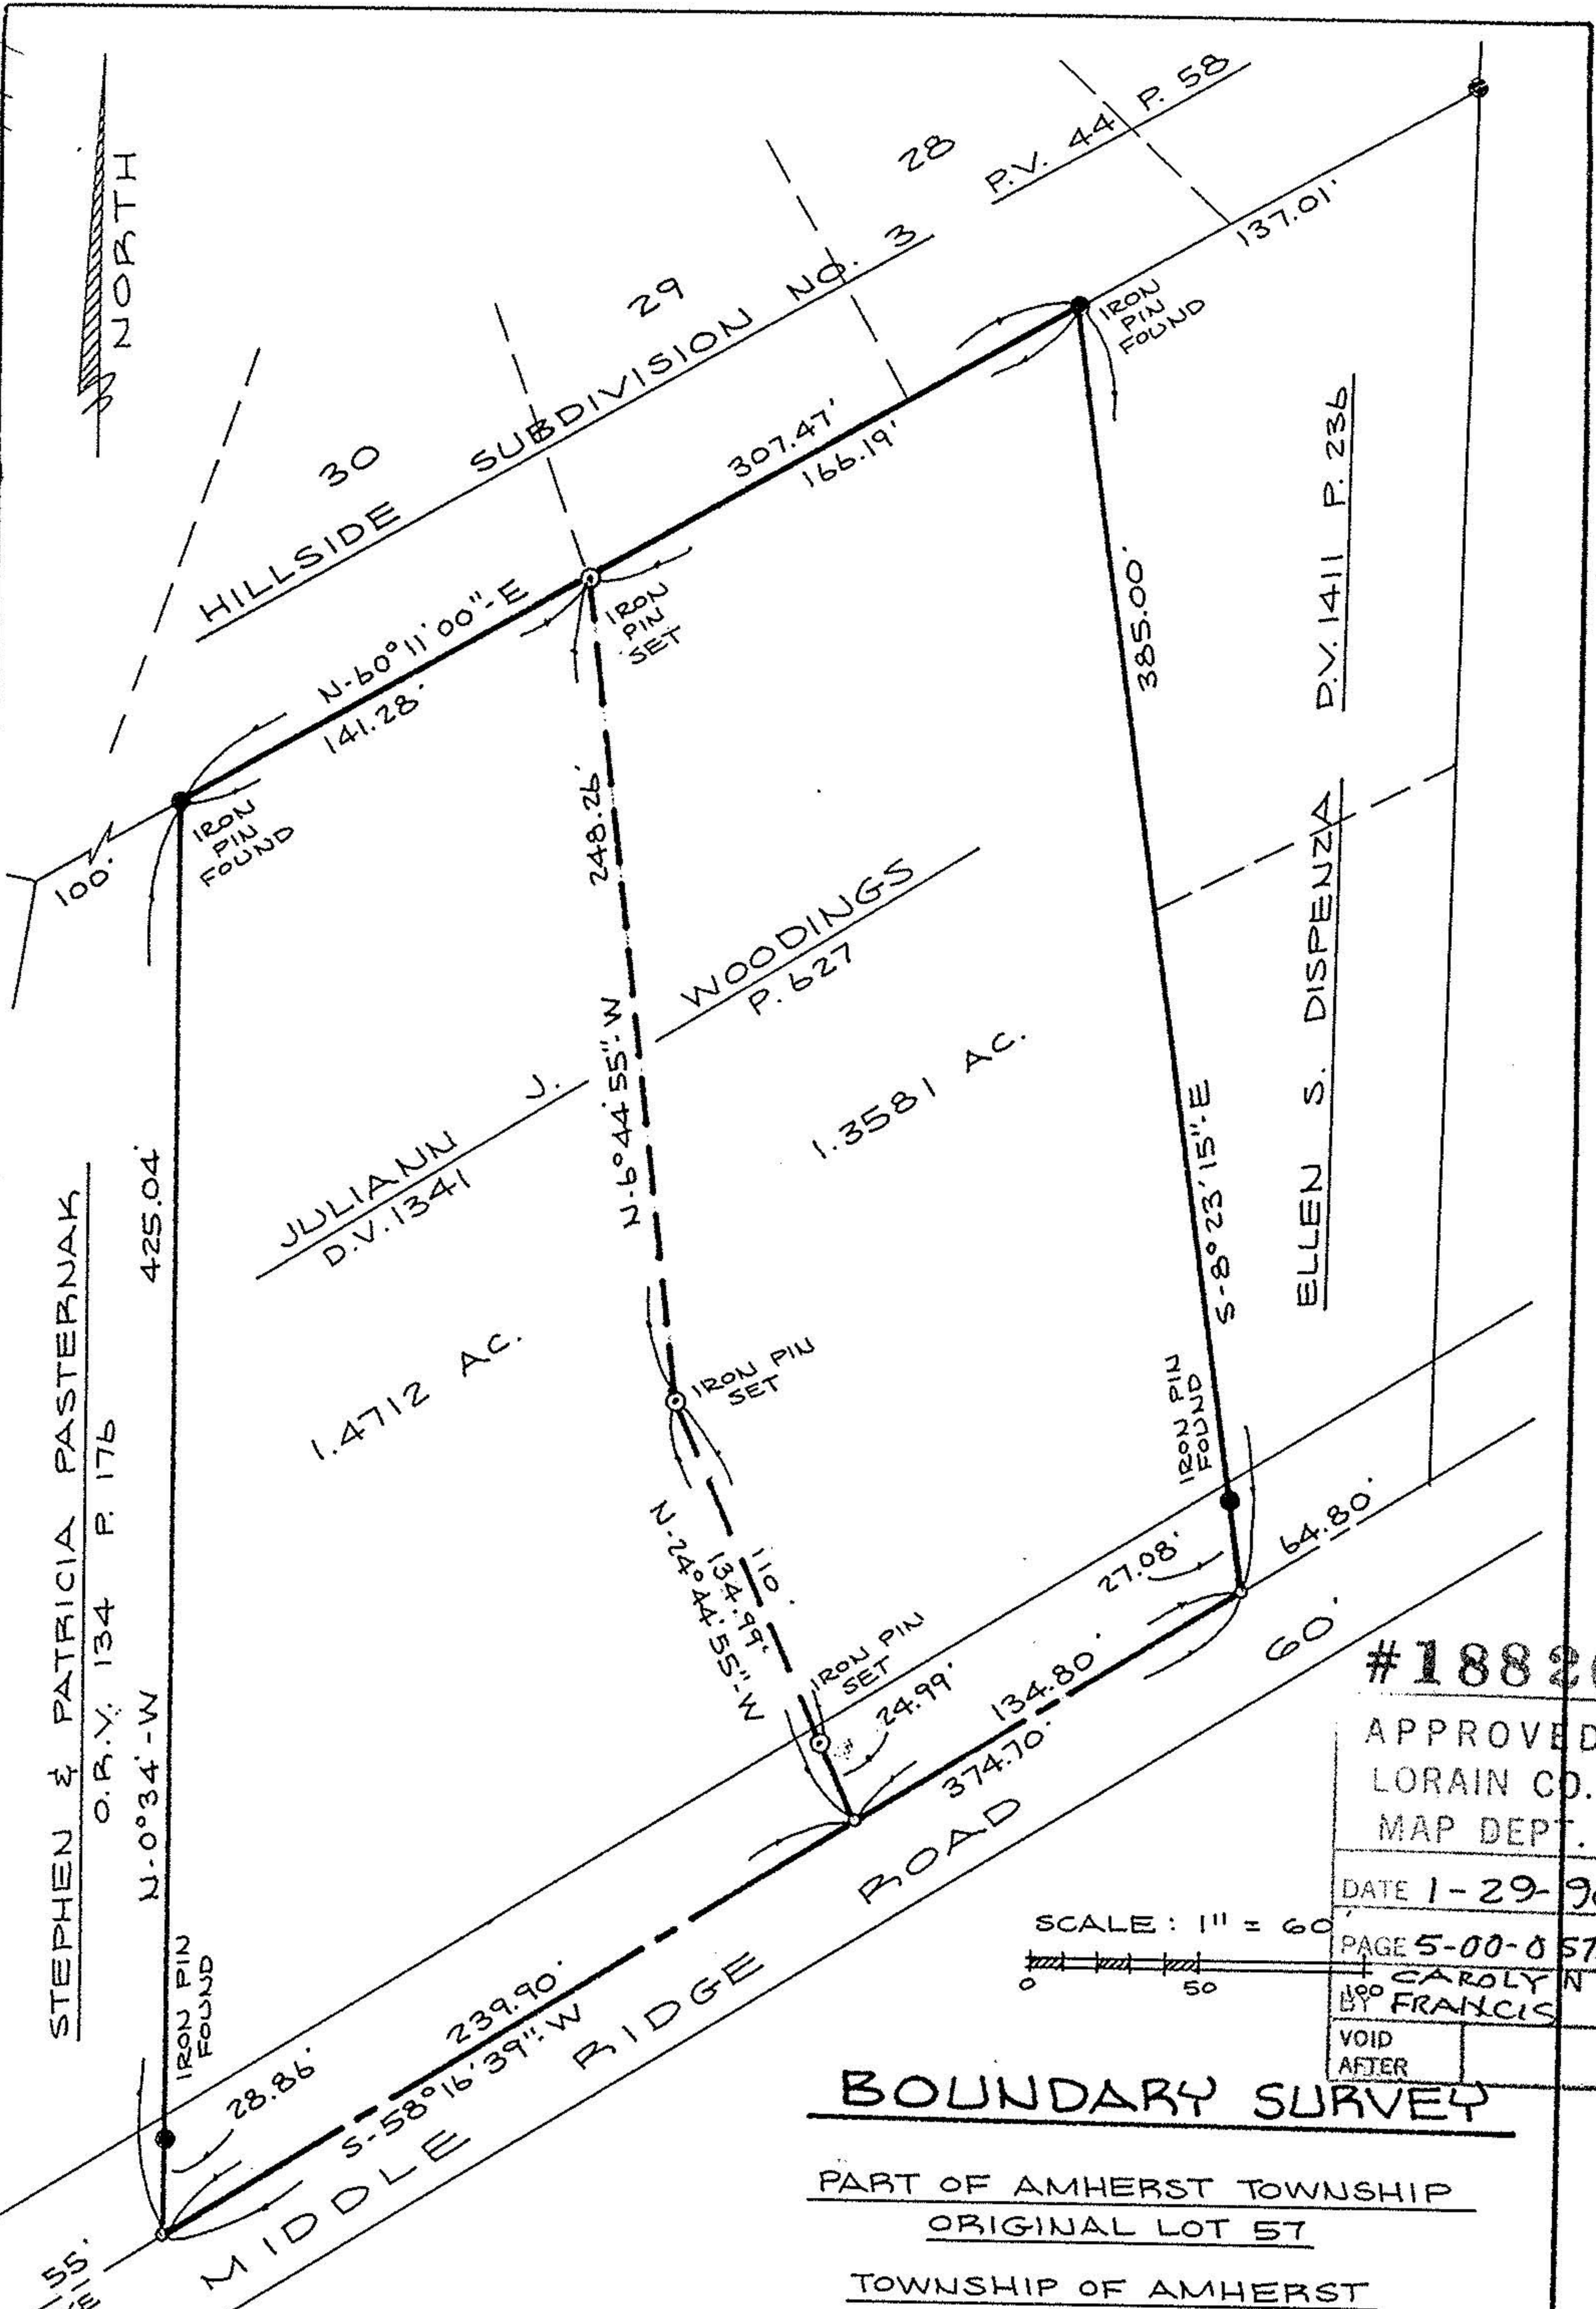

STEPHEN & PATRICIA PASTERNAK  
O.R.V. 134 P. 176

JULIANN J.  
D.V. 1341

ELLEN S. DISPENZA  
D.V. 1411 P. 236

#18820

APPROVED  
LORAIN CO.  
MAP DEPT.

DATE 1-29-90

PAGE 5-00-057B

BY CAROLYN FRANCIS

VOID AFTER

SCALE: 1" = 60'  
0 50

### BOUNDARY SURVEY

PART OF AMHERST TOWNSHIP  
ORIGINAL LOT 57

TOWNSHIP OF AMHERST  
COUNTY OF LORAIN  
STATE OF OHIO

PREPARED BY

**KS ASSOCIATES INC.**  
ENGINEERS SURVEYORS

*David L. Elwell*

DAVID L. ELWELL REG. SURV. 6333

REVISED 01-15-90

