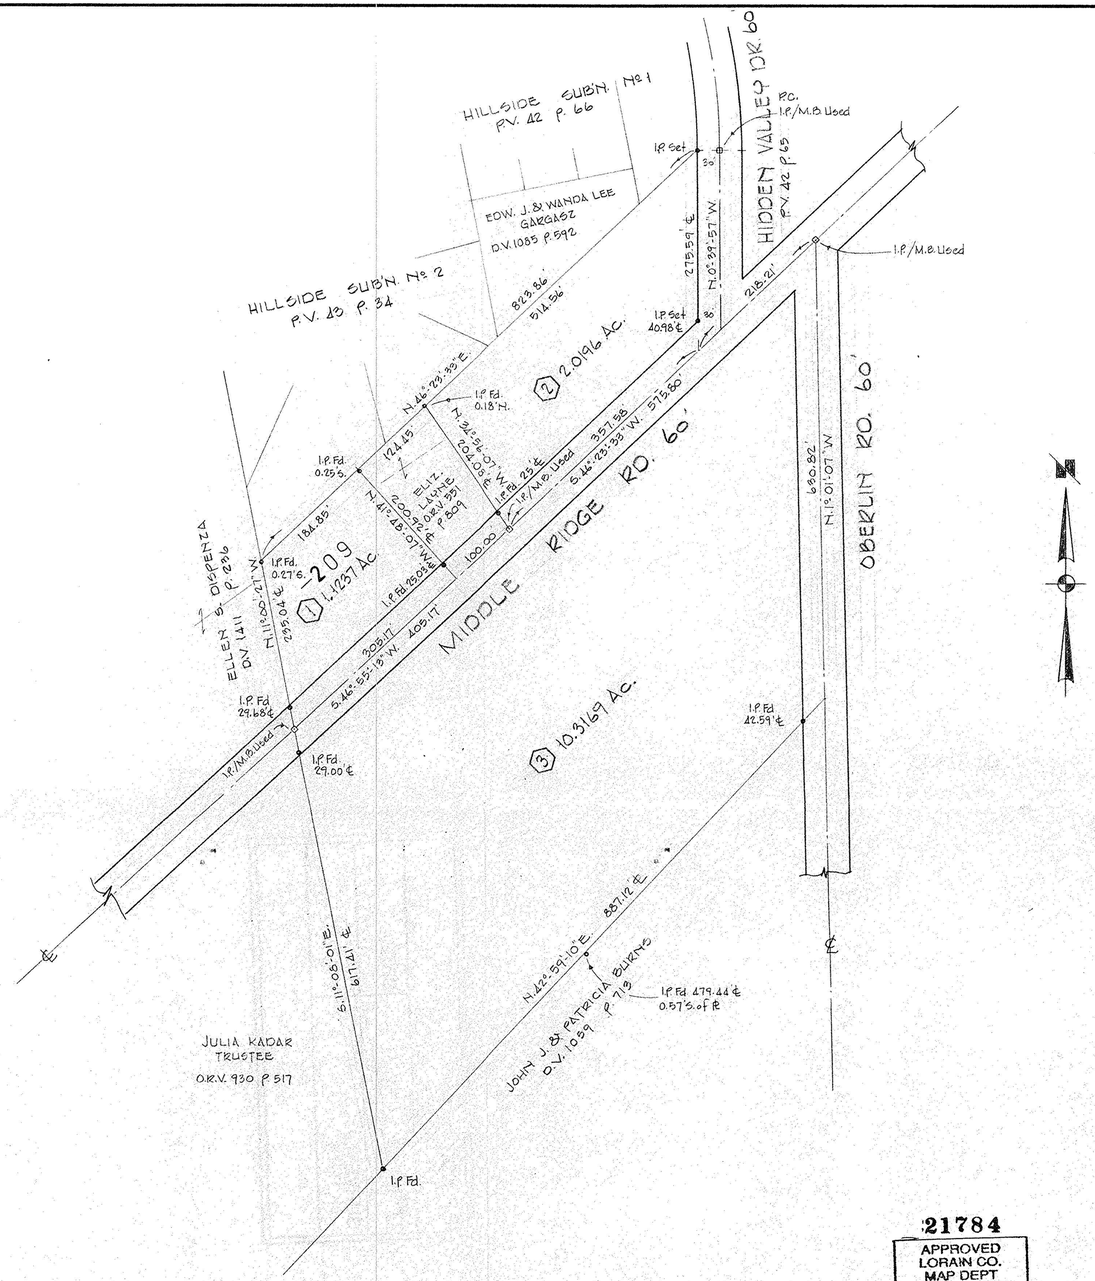

21784

APPROVED LORAIN CO. MAP DEPT
DATE 6-4-96
PAGE 5-00-057B
BY CAROLYN FRANCIS
#21784

SURVEY FOR

BYRD H. RICHMOND

PART OF O.L. 57 TOWNSHIP OF AMHERST

COUNTY OF LORAIN STATE OF OHIO

SCALE 1"=100' OCT. 1994

BY

LAUNDON • SIMON • CAHL & ASSOC.

ENGINEERS SURVEYORS

110 MIDDLE AVE. ELYRIA, O. 44035

JOB 94-2608 FB. 233 P. 44

STATE OF OHIO
RODGER G. SIMON
5101
REGISTERED SURVEYOR