APPROVED
LORAIN CO.
MAP DEPT.

DATE 7-29-96

PAGE 6-8

BY K.DYE

VOID AFTER # 21858

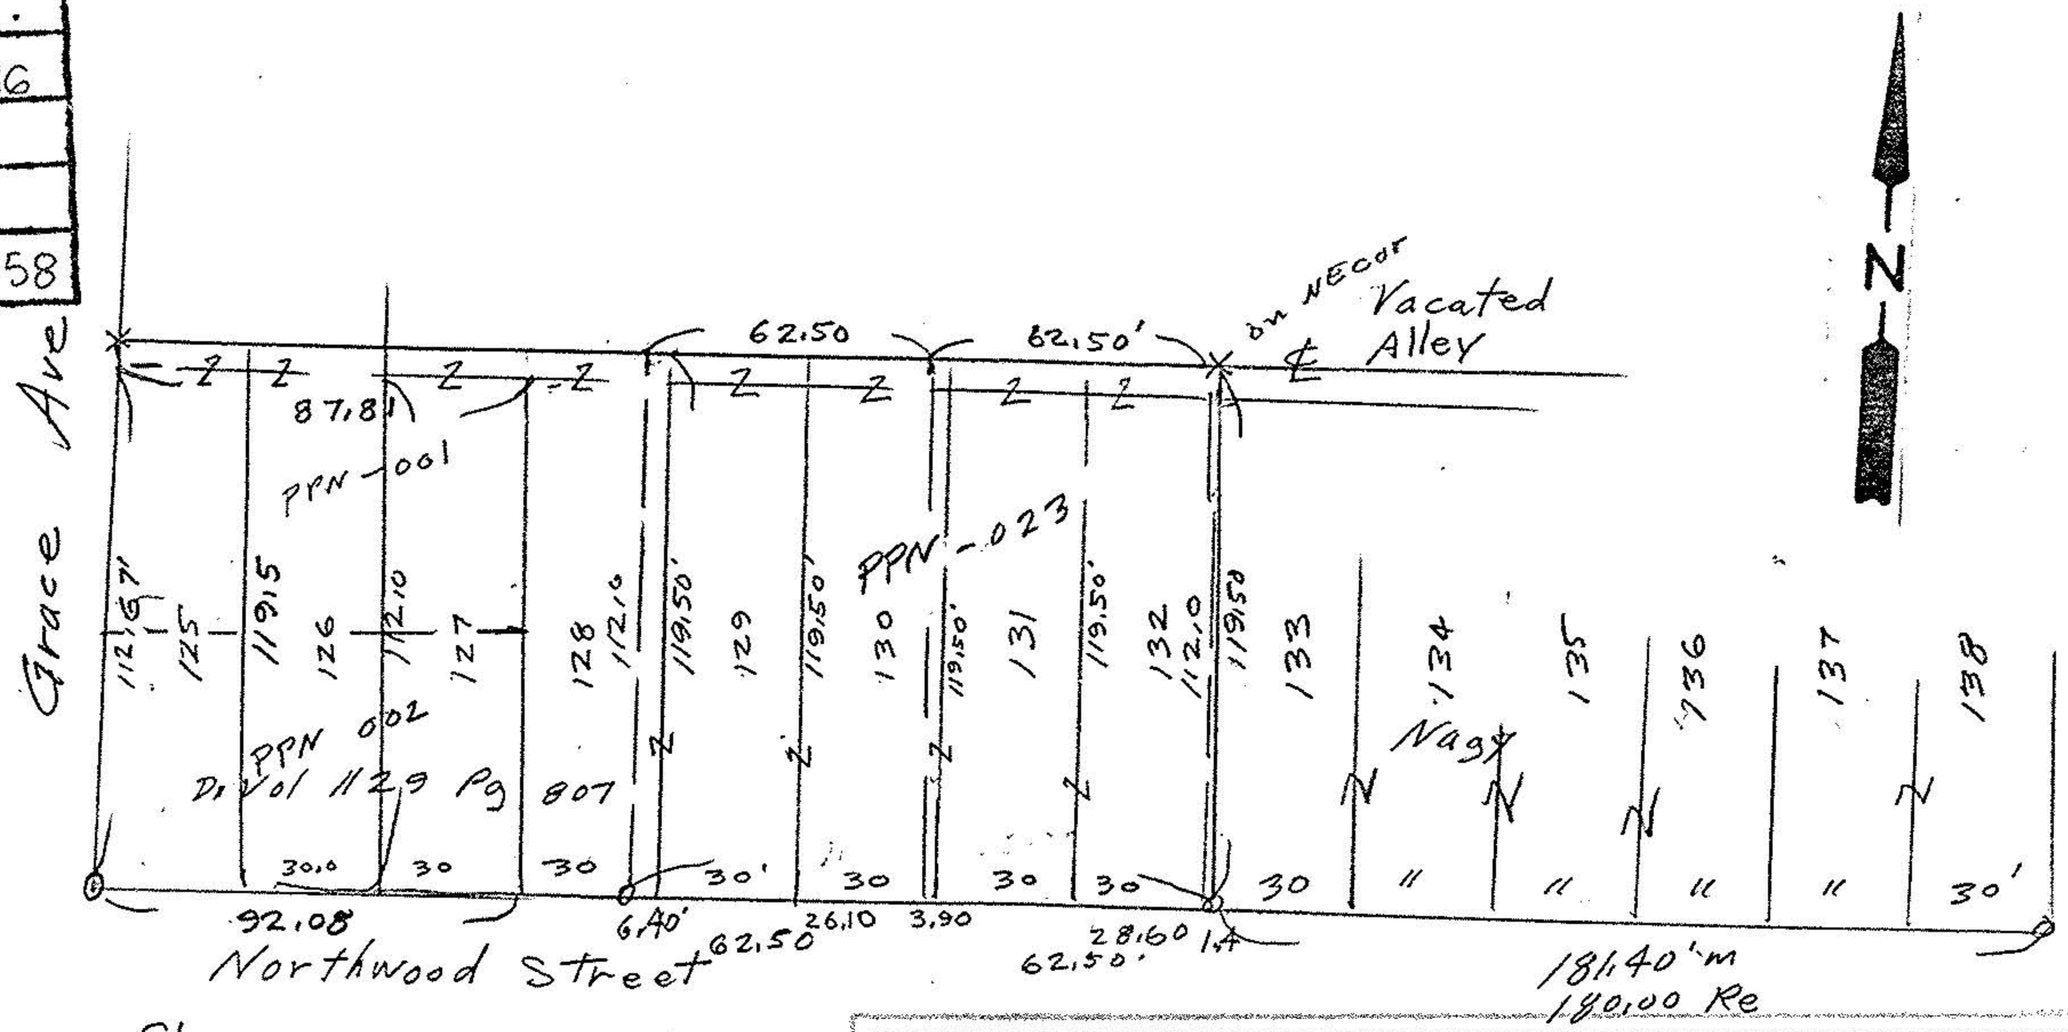

o iron pipes fd

X PK nails set in Blacktop

John Pozywak
Reg Surveyor
5292

STATE OF OHIO
JOHN POZYWAK
5292
REGISTERED
SURVEYOR

see R. Hollis FB 103 Pg 28

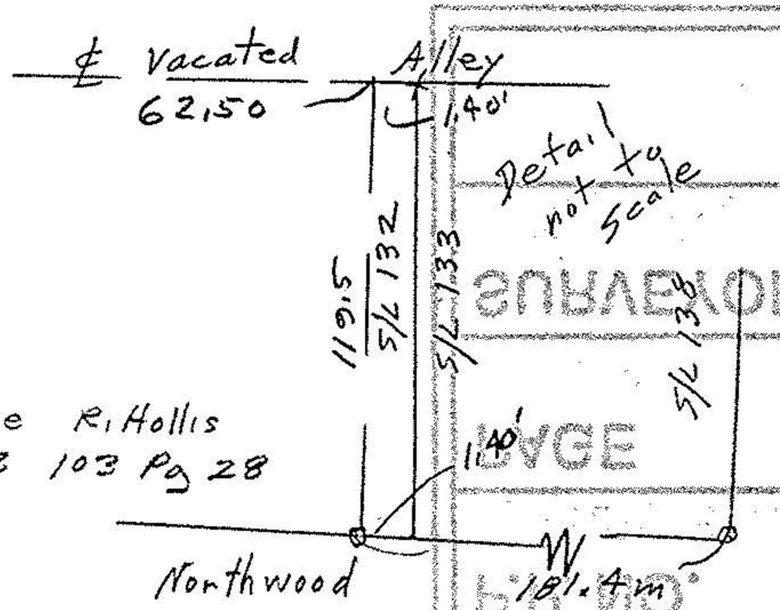

Survey for
Irene Hampton
sublots 125-132

Clearview Subdivision
P. Vol 10 Pg 8
Original 18
Burrell and Day Tract
Elyria Township
Lorain County Ohio
Scale 1" = 50 May 21, 1995
Parcel split -023 Jun 7, 1995