


PROPERTY SPLIT  
FOR

# WILLA J. DESMIT

SITUATED IN THE CITY OF ELYRIA, COUNTY  
OF LORAIN AND STATE OF OHIO, AND KNOWN  
AS BEING PART OF ORIGINAL ELYRIA TOWN-  
SHIP LOT NO. 24.

JUNE 20, 1989  
SCALE: 1"=30'

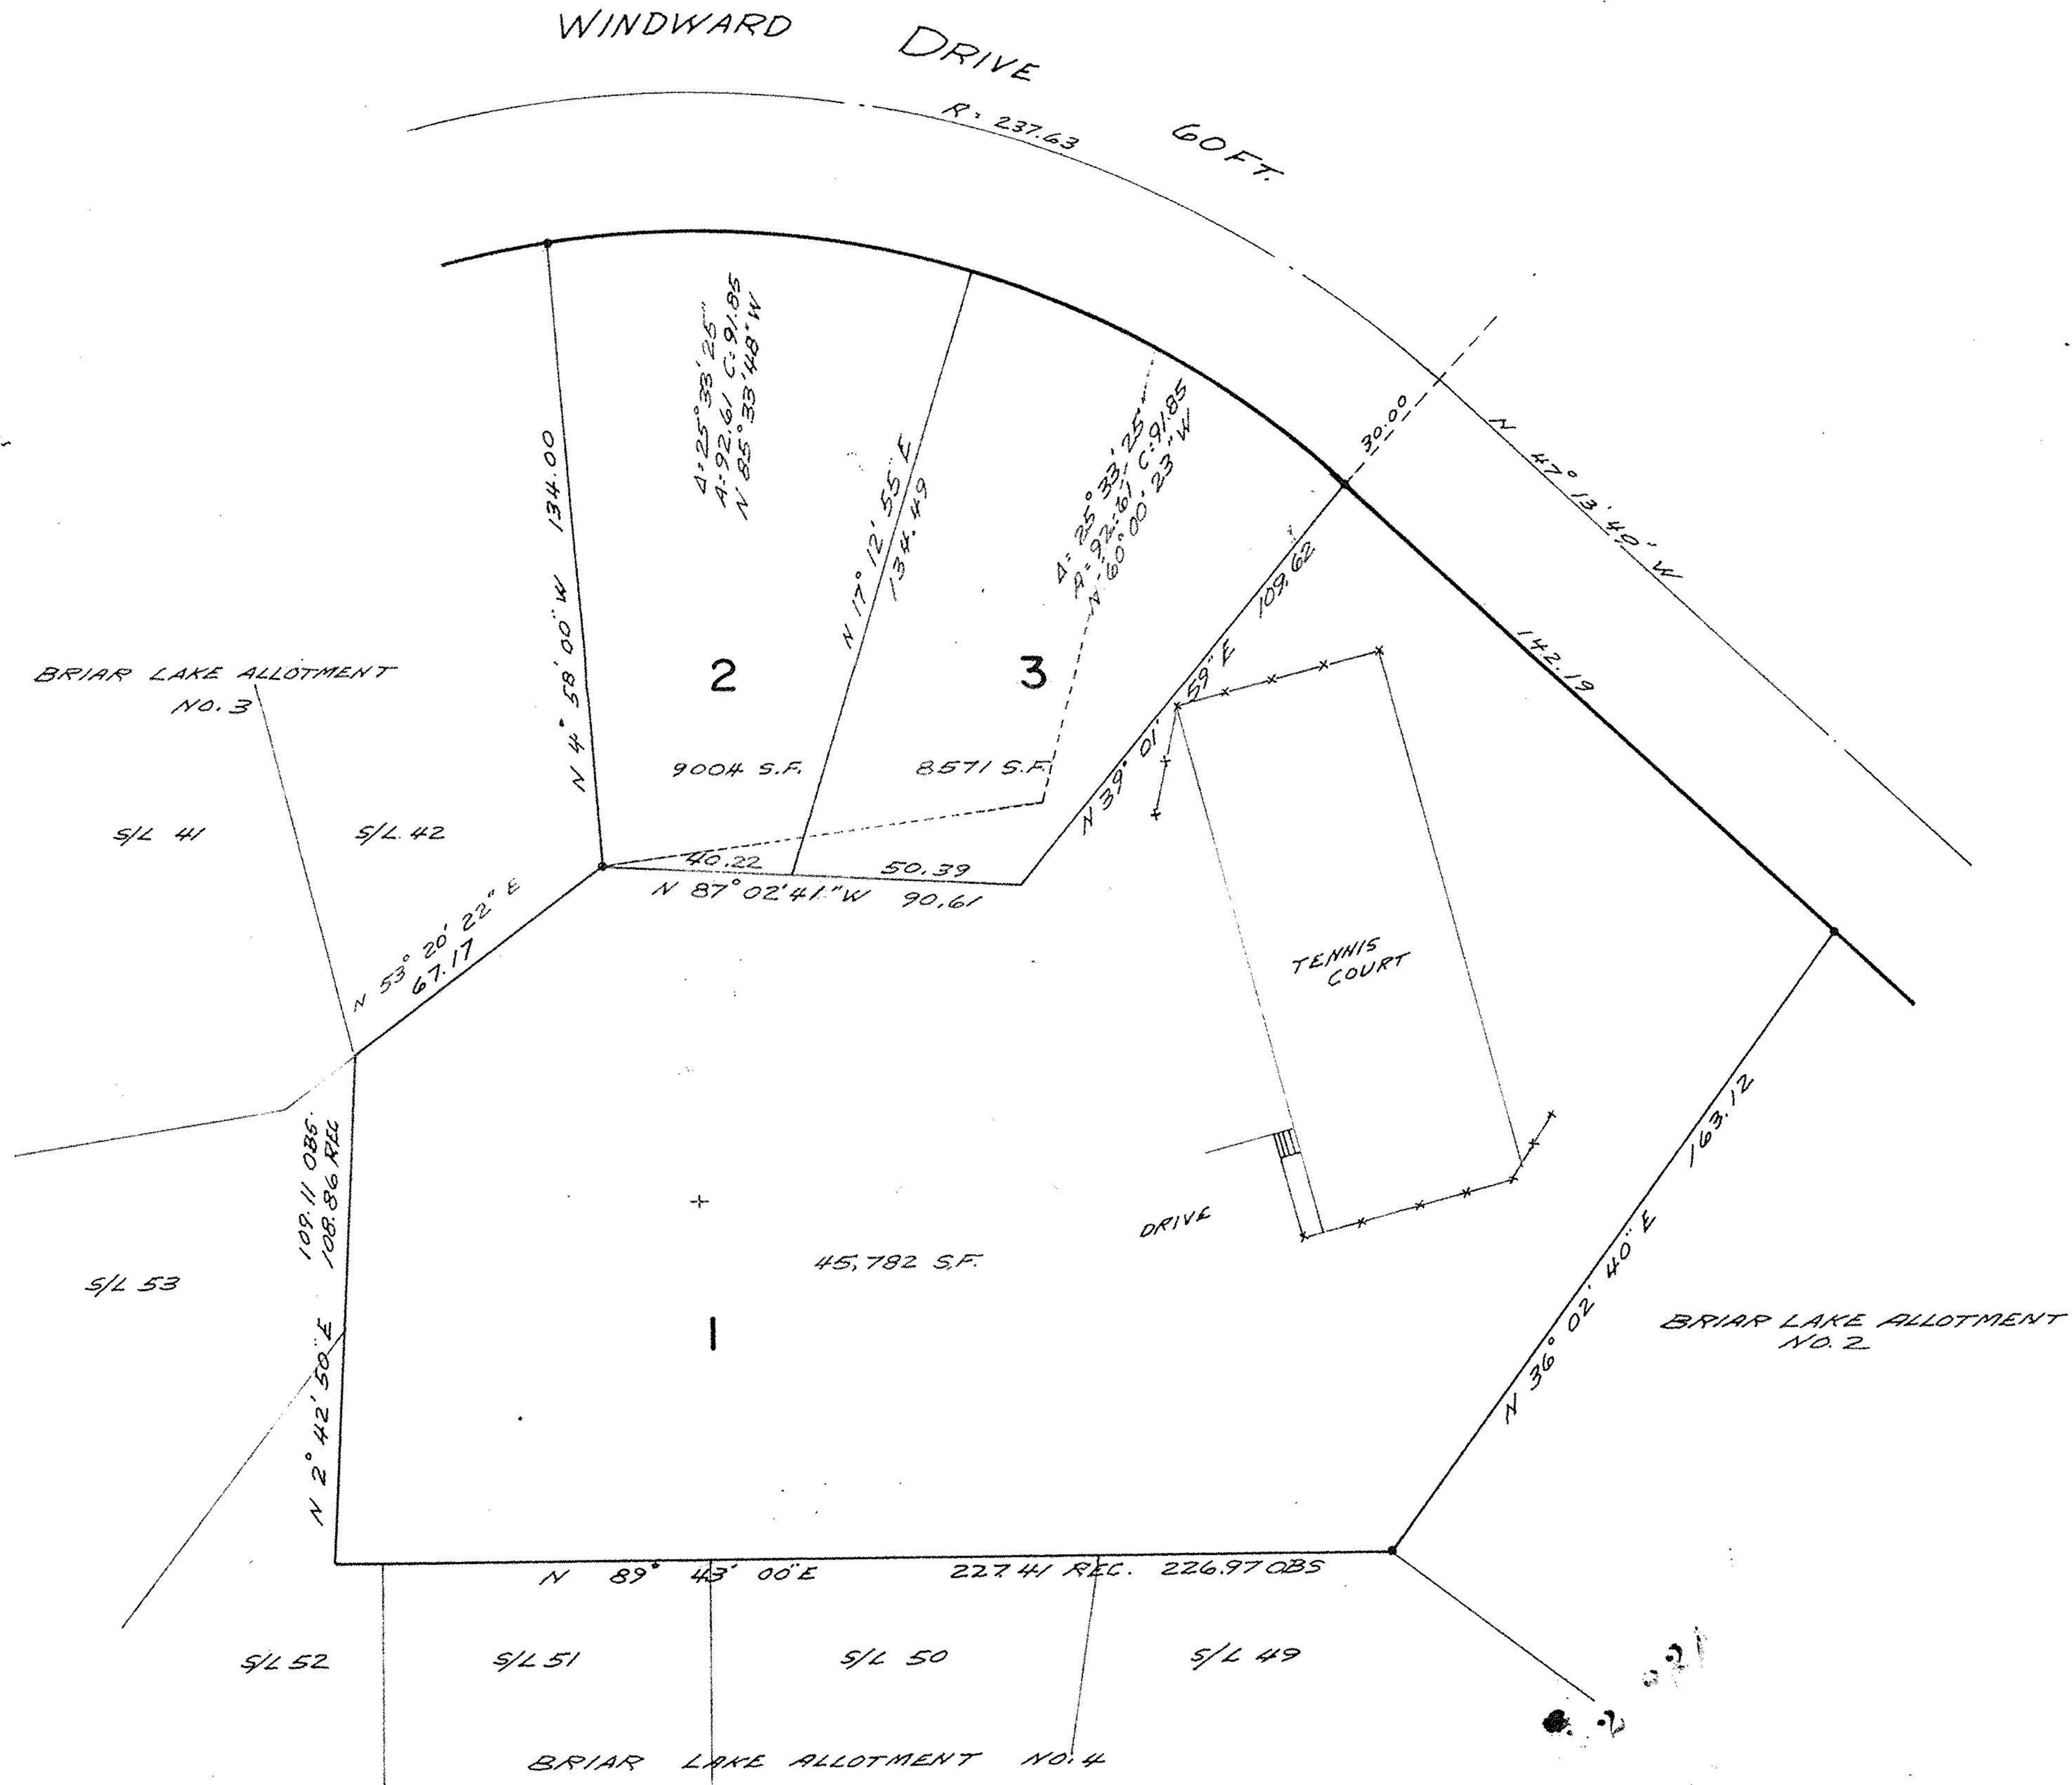

#18713

APPROVED  
LORAIN CO.  
MAP DEPT.  
DATE 11-8-89  
PAGE 6-34  
BY *W. J. Desmit*  
VOID  
AFTER

18713

JAMES A. RESAR, P.E.  
OHIO REG. SURVEYOR NO. 6361

#18713