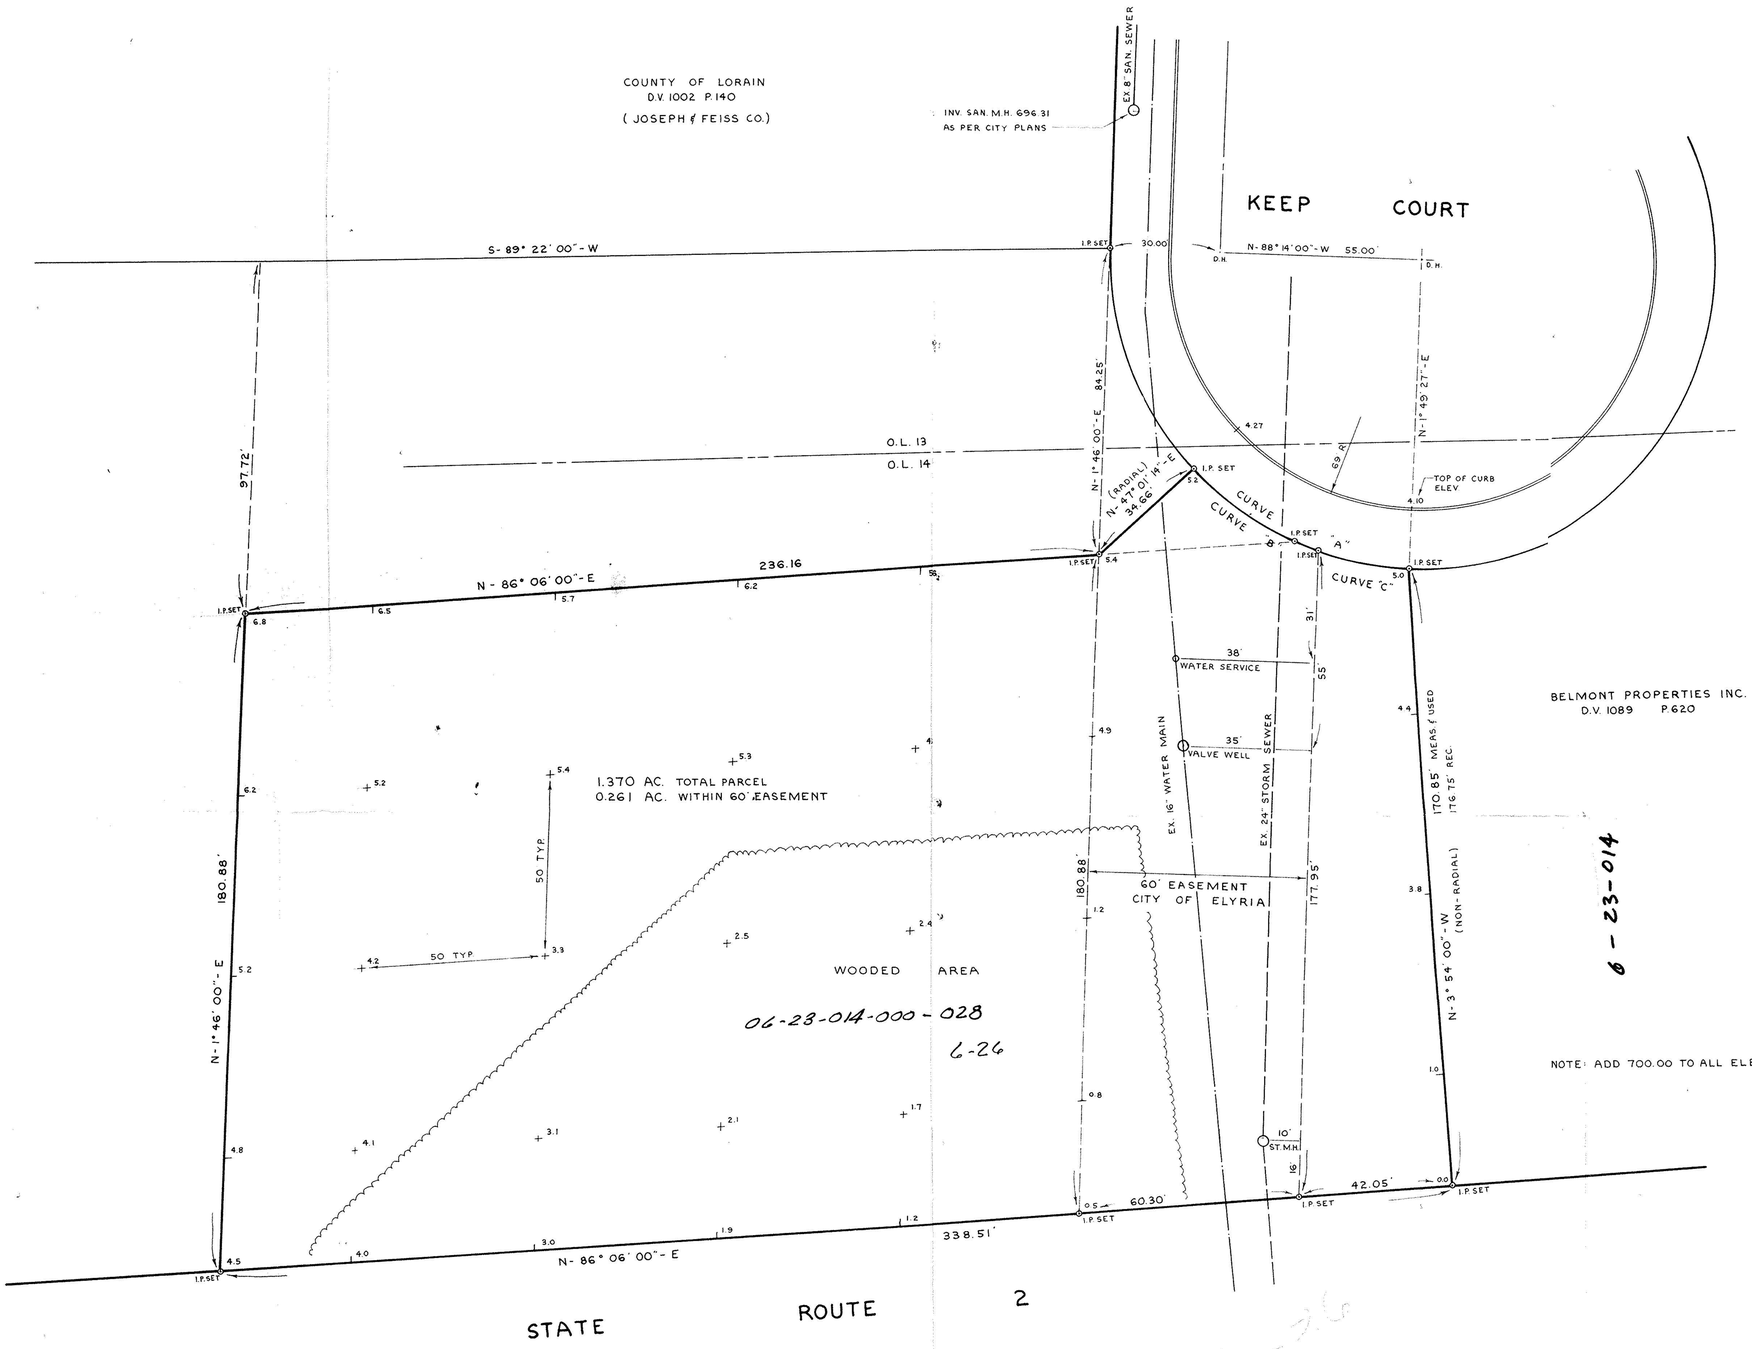

CURVE A
R = 85.00' Δ = 45° 11' 47"
A = 67.05' C = 65.33'
C.B. = N- 65° 34' 39"- W

CURVE B
R = 85.00' Δ = 28° 06' 25"
A = 41.70' C = 41.28'
C.B. = N- 57° 01' 59"- W

CURVE C
R = 85.00' Δ = 17° 05' 22"
A = 25.35' C = 25.26'
C.B. = N- 79° 37' 52"- W

10-066
6-26
06-23-014

6-26
2-2-78

06-23-014

No.	Date	Description	By
1	10-4-76	ADD UTILITY LOCATIONS	DLH

REVISIONS

PROJECT

TOPOGRAPHICAL SURVEY OF PART OF ORIGINAL ELYRIA TOWNSHIP LOT NO. 14 BRACE TRACT

CITY OF ELYRIA COUNTY OF LORAIN STATE OF OHIO

PREPARED FOR:

MILAN STEEL

Drawn by: DLH
Checked by:
App. by:
Scale: 1" = 20'
Date: 14-76

KLEINOEDER · SCHMIDT and ASSOCIATES

ENGINEERS — SURVEYORS — CONSULTANTS in LAND PLANNING

ELYRIA · NORWALK · MEDINA OHIO

REFERENCES
72-264
76-35

SHEET NO. 1 of 1

JOB NO. 76-2