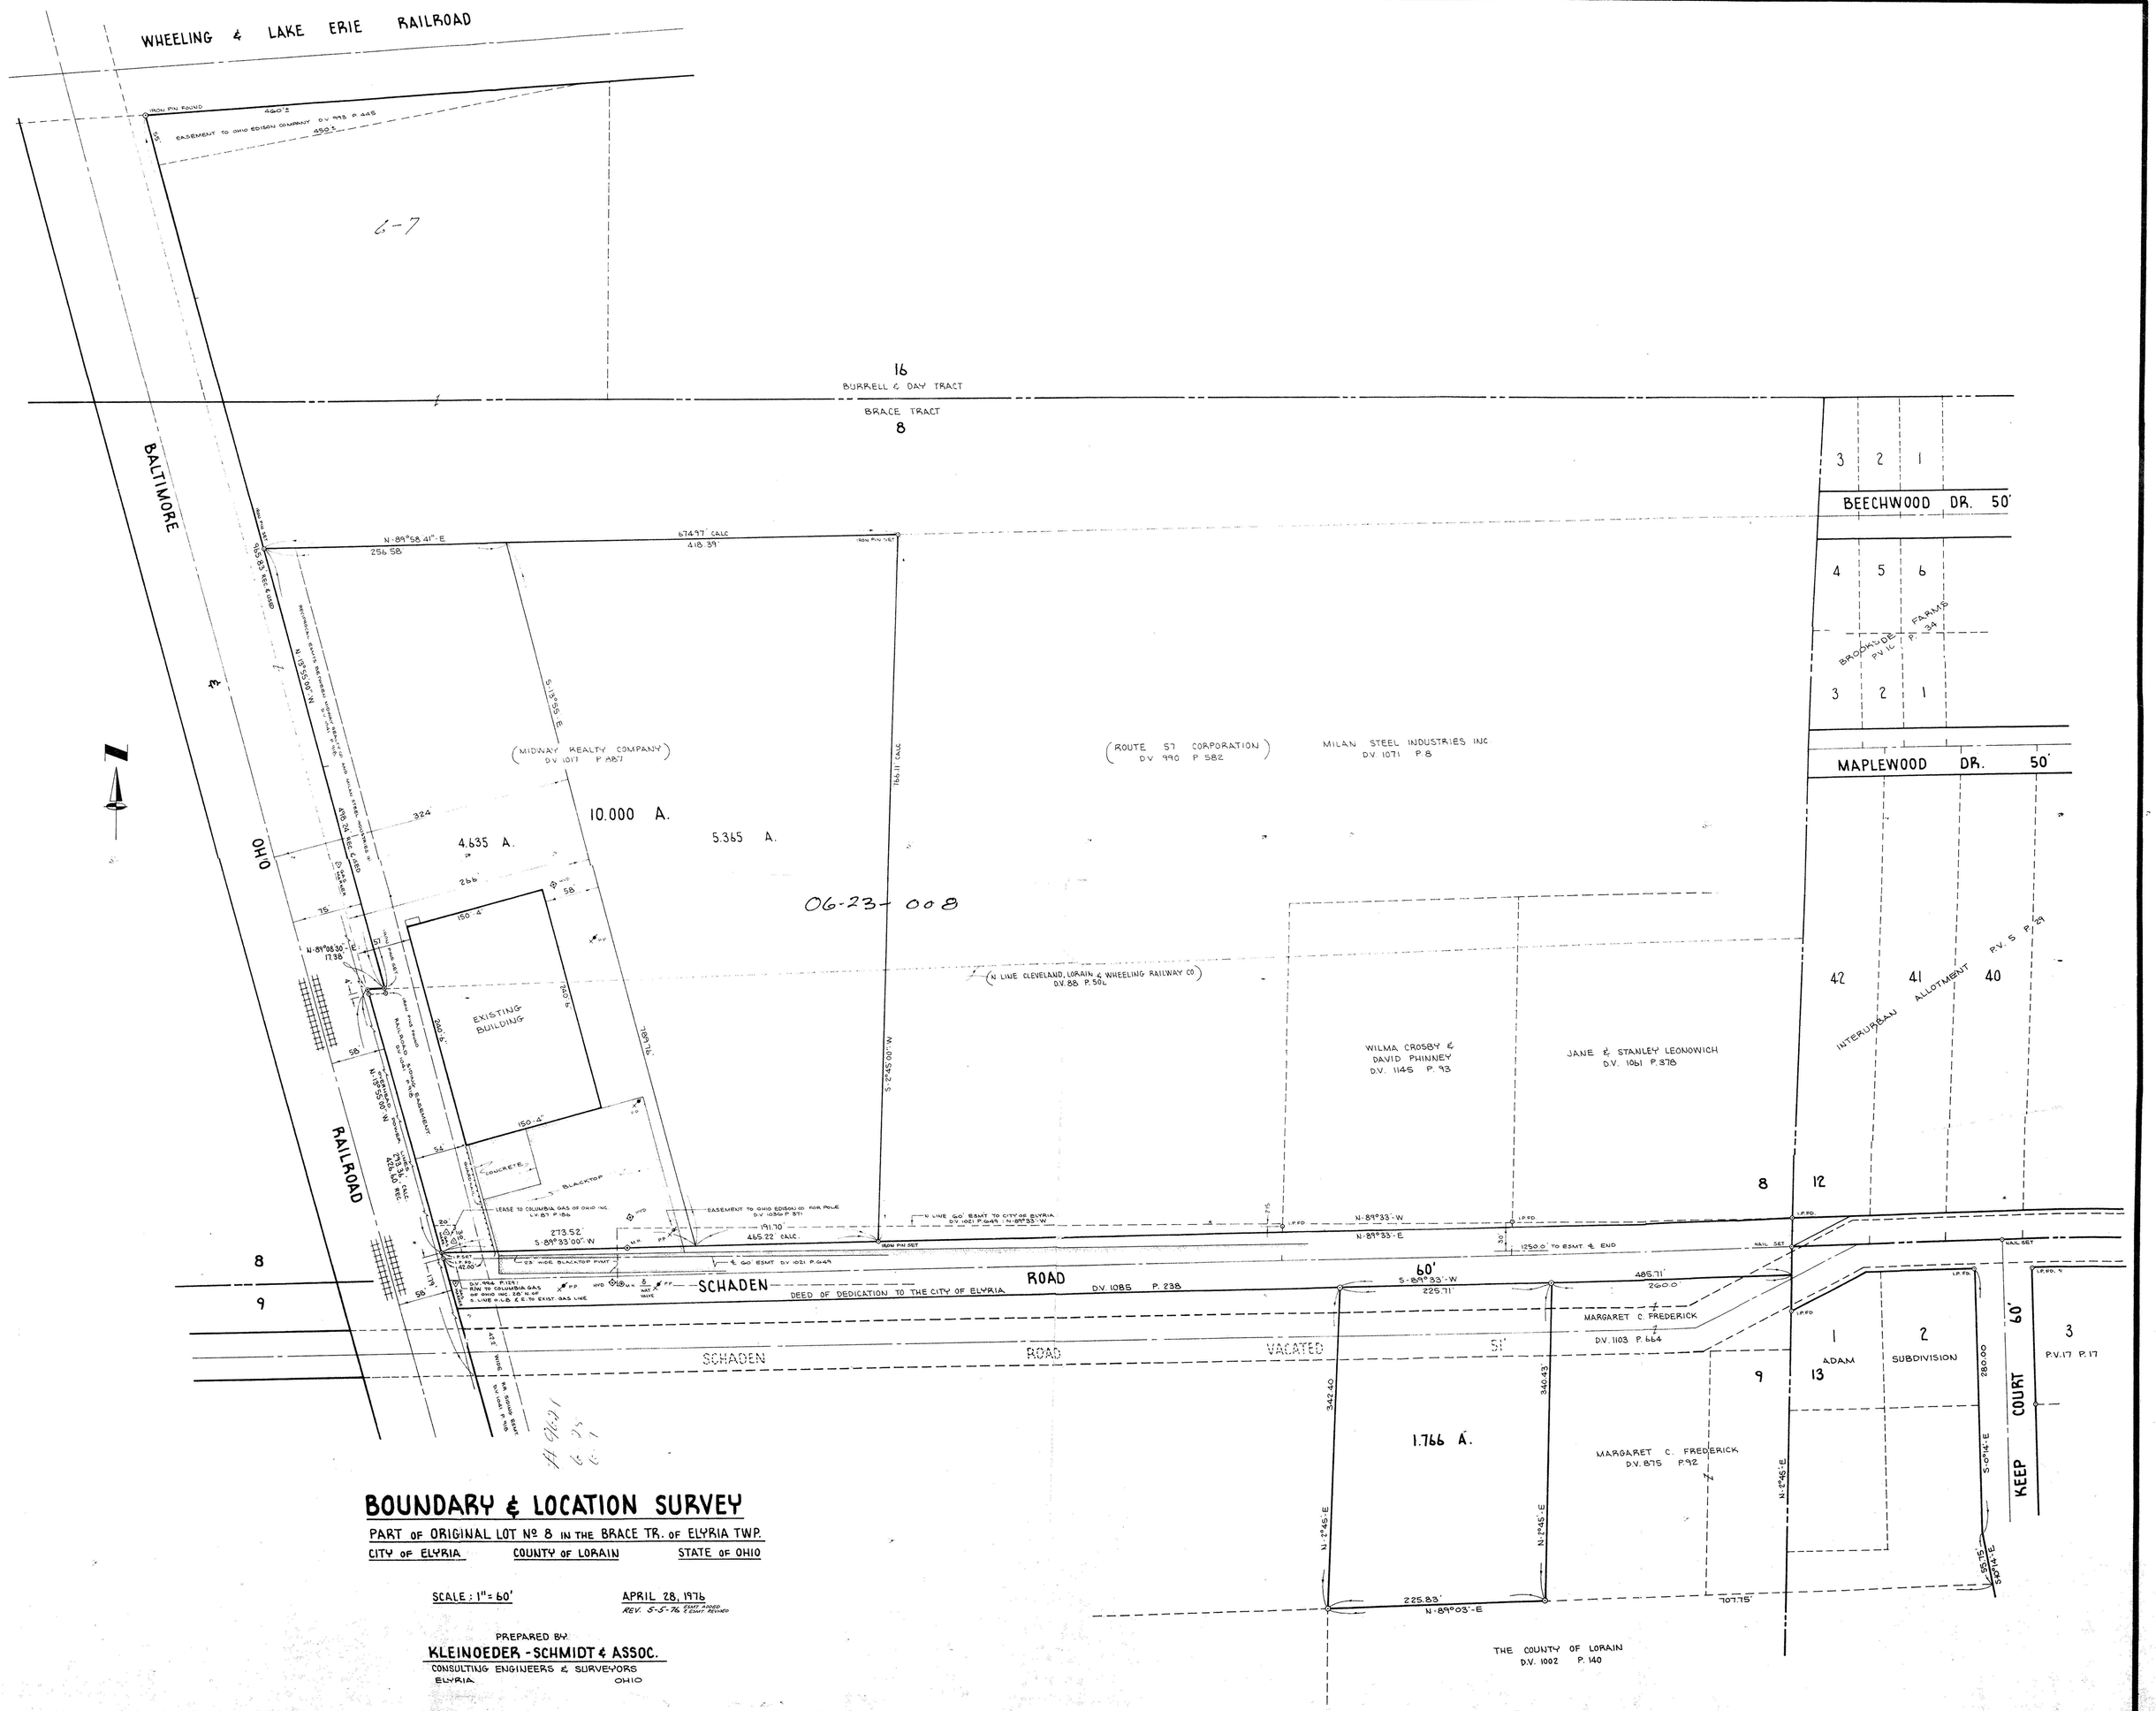


# BOUNDARY & LOCATION SURVEY

PART OF ORIGINAL LOT Nº 8 IN THE BRACE TR. OF ELYRIA TWP.

CITY OF ELYRIA — COUNTY OF LORAIN — STATE OF OHIO

SCALE : 1" = 60'

APRIL 28, 1976
REV. 5-5-76 EASMT ADDED & EASMT REVISED

PREPARED BY
KLEINOEDER - SCHMIDT & ASSOC.
CONSULTING ENGINEERS & SURVEYORS
ELYRIA OHIO

7635