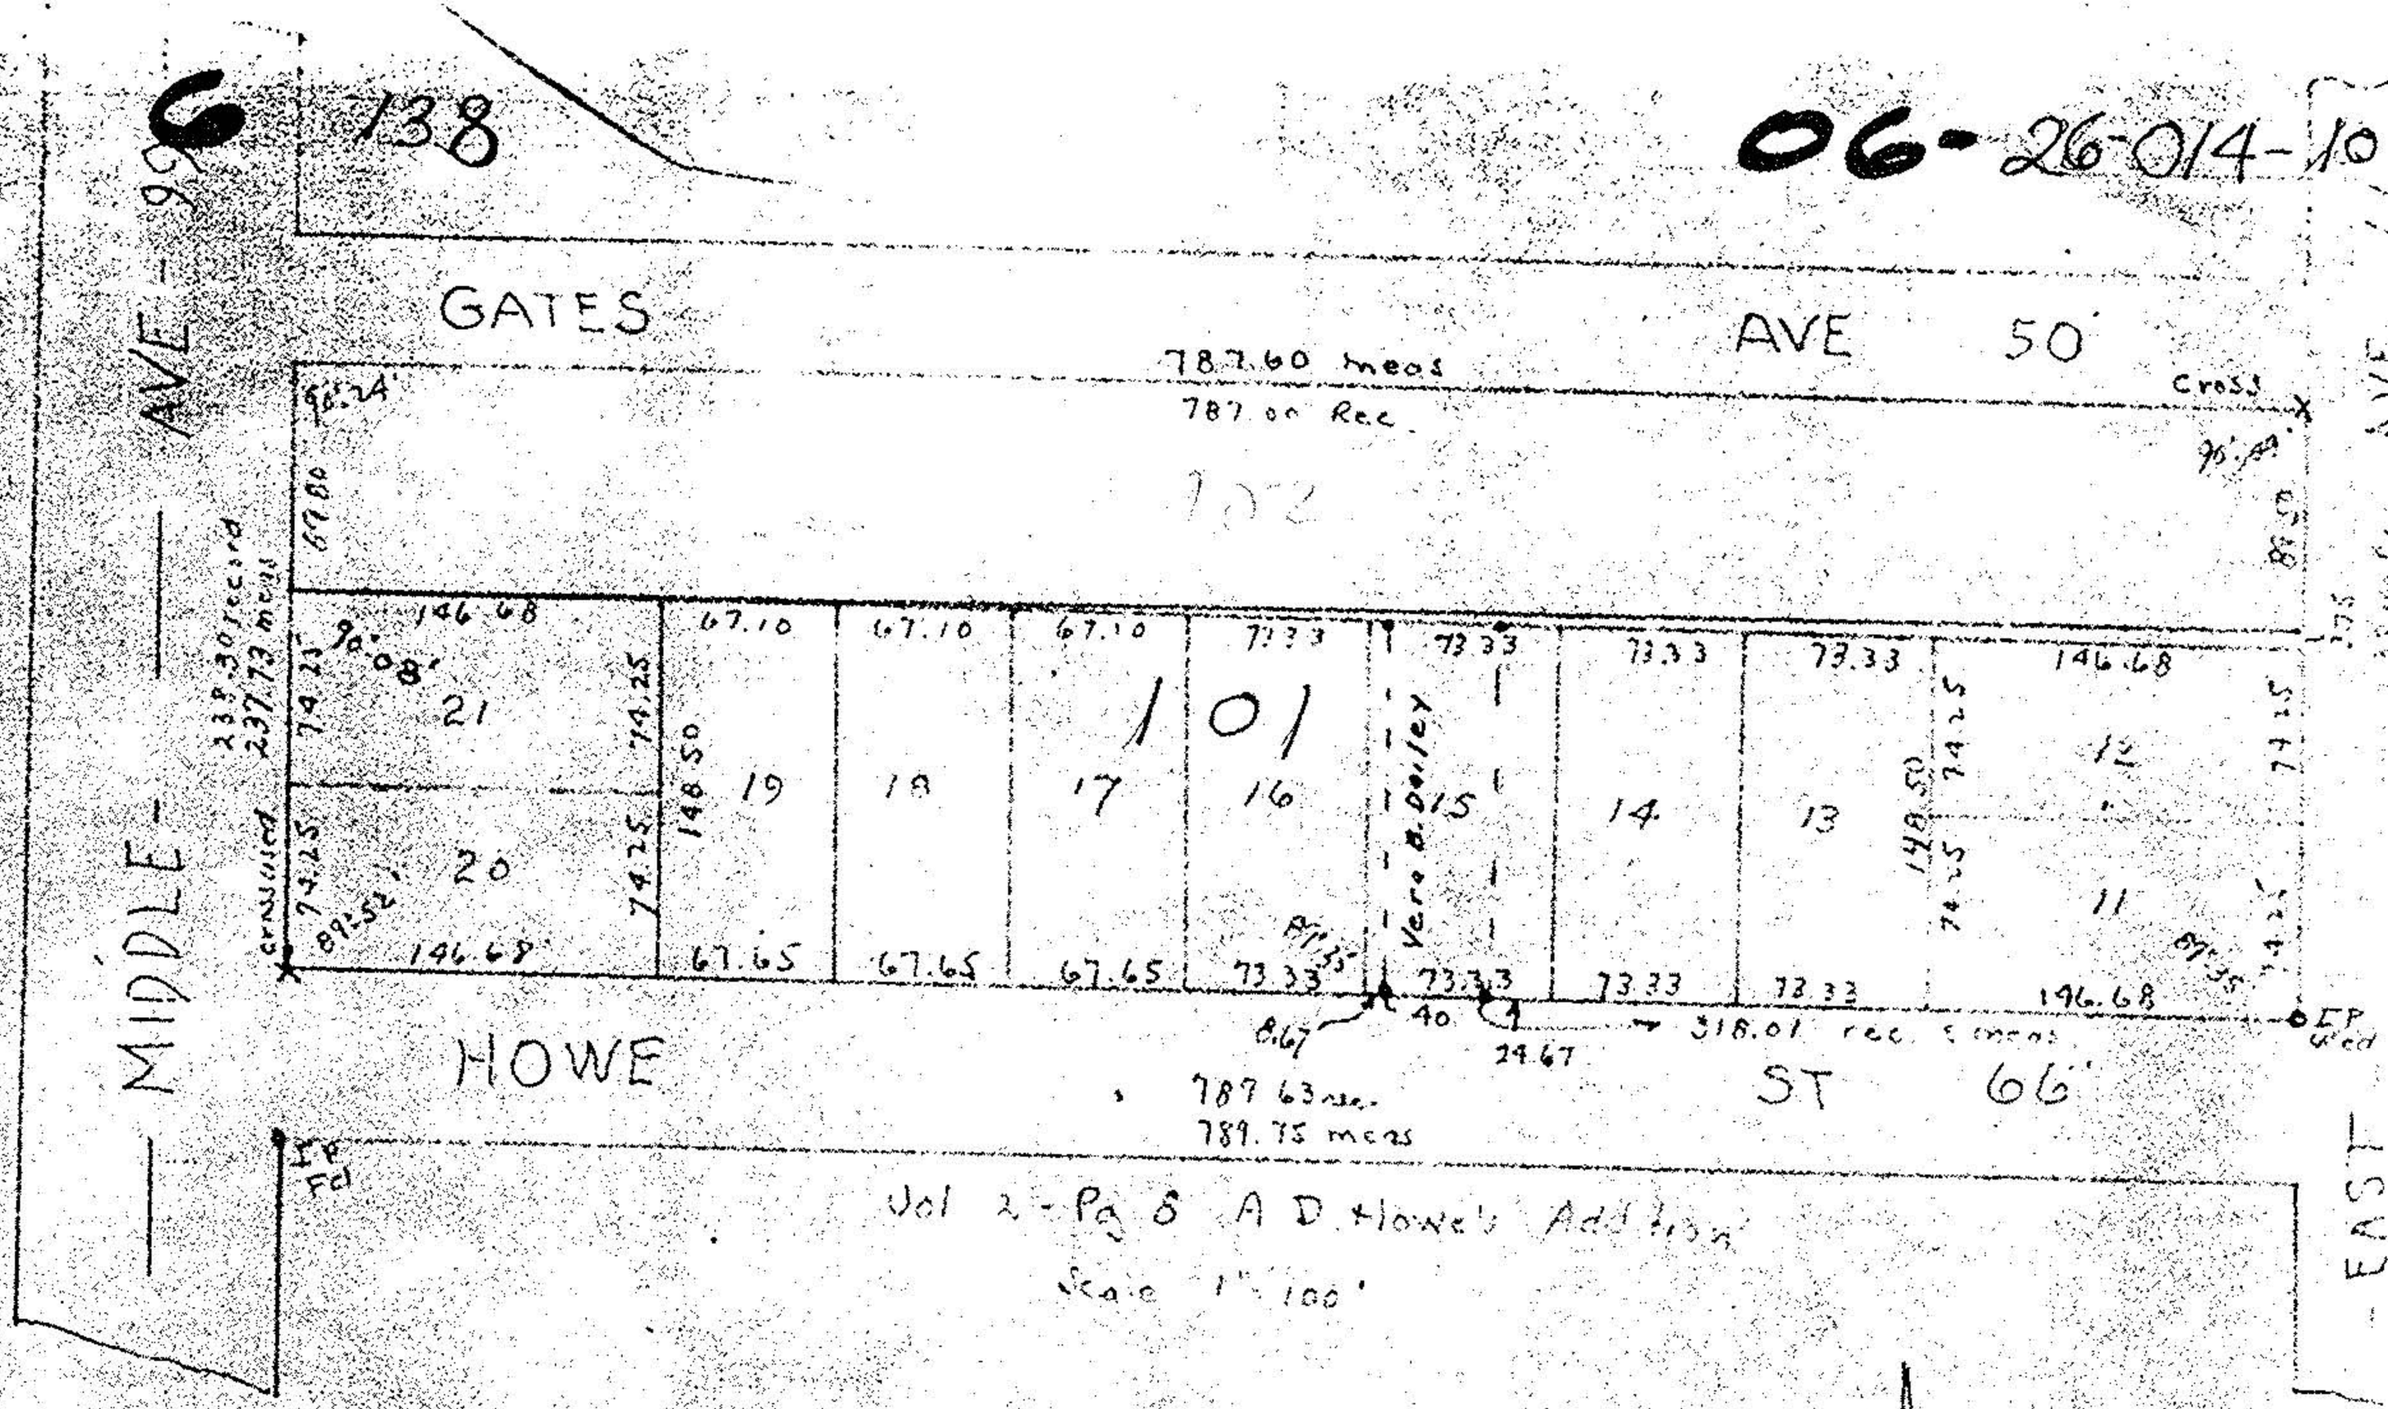

Copy of survey made for Vera B. Dailey
By Warden & Laundon
June 15 - 1920

(3)